



BETHLEHEM MINES CORPORATION
ELLSWORTH DIVISION
SCALE 1"=400'
MARCH 1984 SHEET 2


LEGEND

- ▬ MINE BOUNDARY
- ▨ 5 YEAR PERMIT AREA & SUBSIDENCE CONTROL PLAN AREA
- ▣ PRE 1966 HOUSE
- ▣ AN POST 1966 HOUSE
- ▣ T PRE 1966 TRAILER
- ▣ TN POST 1966 TRAILER
- ▣ B BARN
- ▣ C GARAGE
- ▣ D OUTBUILDING
- ▣ CB COMMERCIAL BUILDING
- ▣ PB PUBLIC BUILDING
- SUPPORT AREA

PITTSBURGH COAL SEAM

SCALE 1"=400' SURVEY DATE 3-7-88

MINE NO. 58
BETHLEHEM MINES INC.
ELLSWORTH DIVISION
WASHINGTON COUNTY
GREEN COUNTY
MORGAN TWP.
WEST BETHLEHEM TWP.
MARIANNA BORO

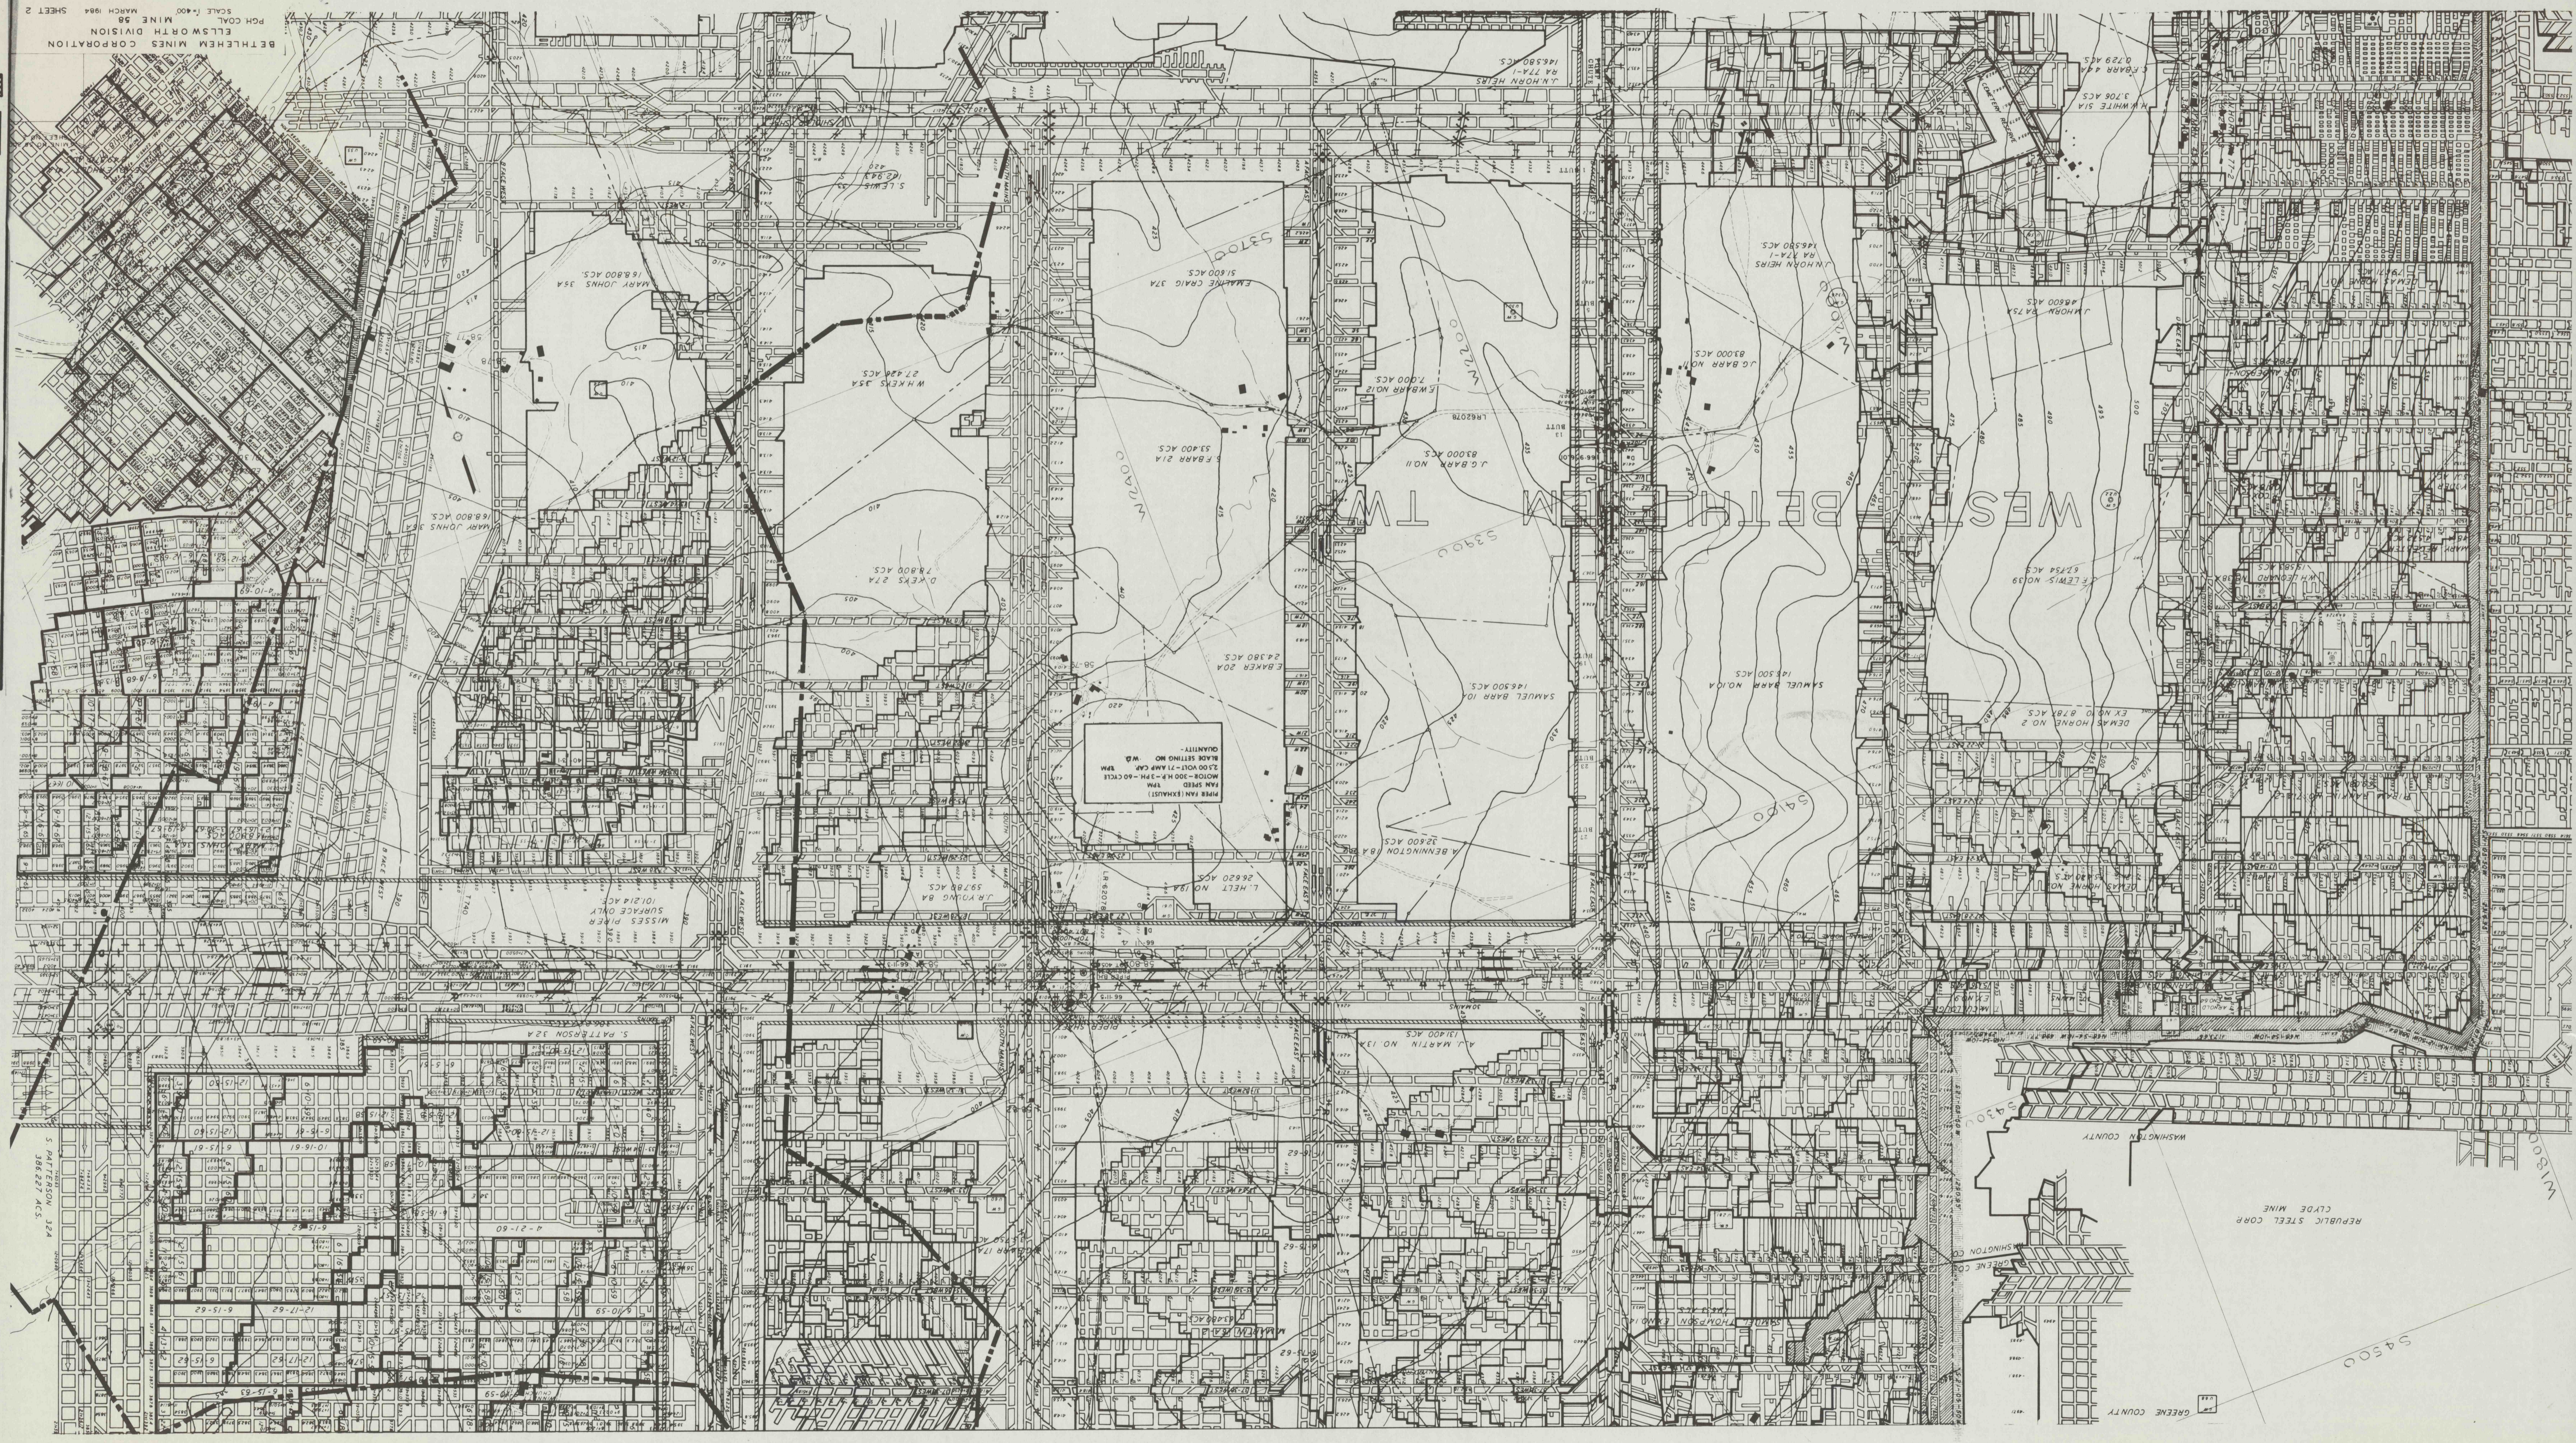

PIPER PAK (SHELFST)
MOTOR - 300 H.P. - 74" - 60 CYCLE
MAN SHED
25000 - 17 AMP CAP. TRM
BLANK SHEETING NO. W.D.

WASHINGTON COUNTY
GREEN COUNTY
REPUBLIC STEEL CORP.
CLYDE MINE
54500
MILBROOK