


MAP OF BETH ENERGY MINE'S  
 MINE NO. 38E  
 UPPER FREEPORT SEAM  
 SHOWING FINAL SURVEY (10-10-80)  
 JACKSON TWP., CAMBRIA CO., PA  
 SCALE: 1" = 400'  
 MAY, 1986

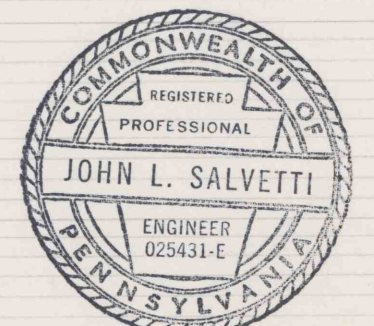

John L. Salvetti  
 John L. Salvetti R.P.E. 025431-E

#250  
 6-9-86  
 C.C.