


Property Plan
 Black Beauty No. 1 Mine
 Young Twp., Indiana Co., Pa.
 Scale 1"=400' Apr. 14, 1966
 Graft Engineering Co.
 Blairsville, Pa.

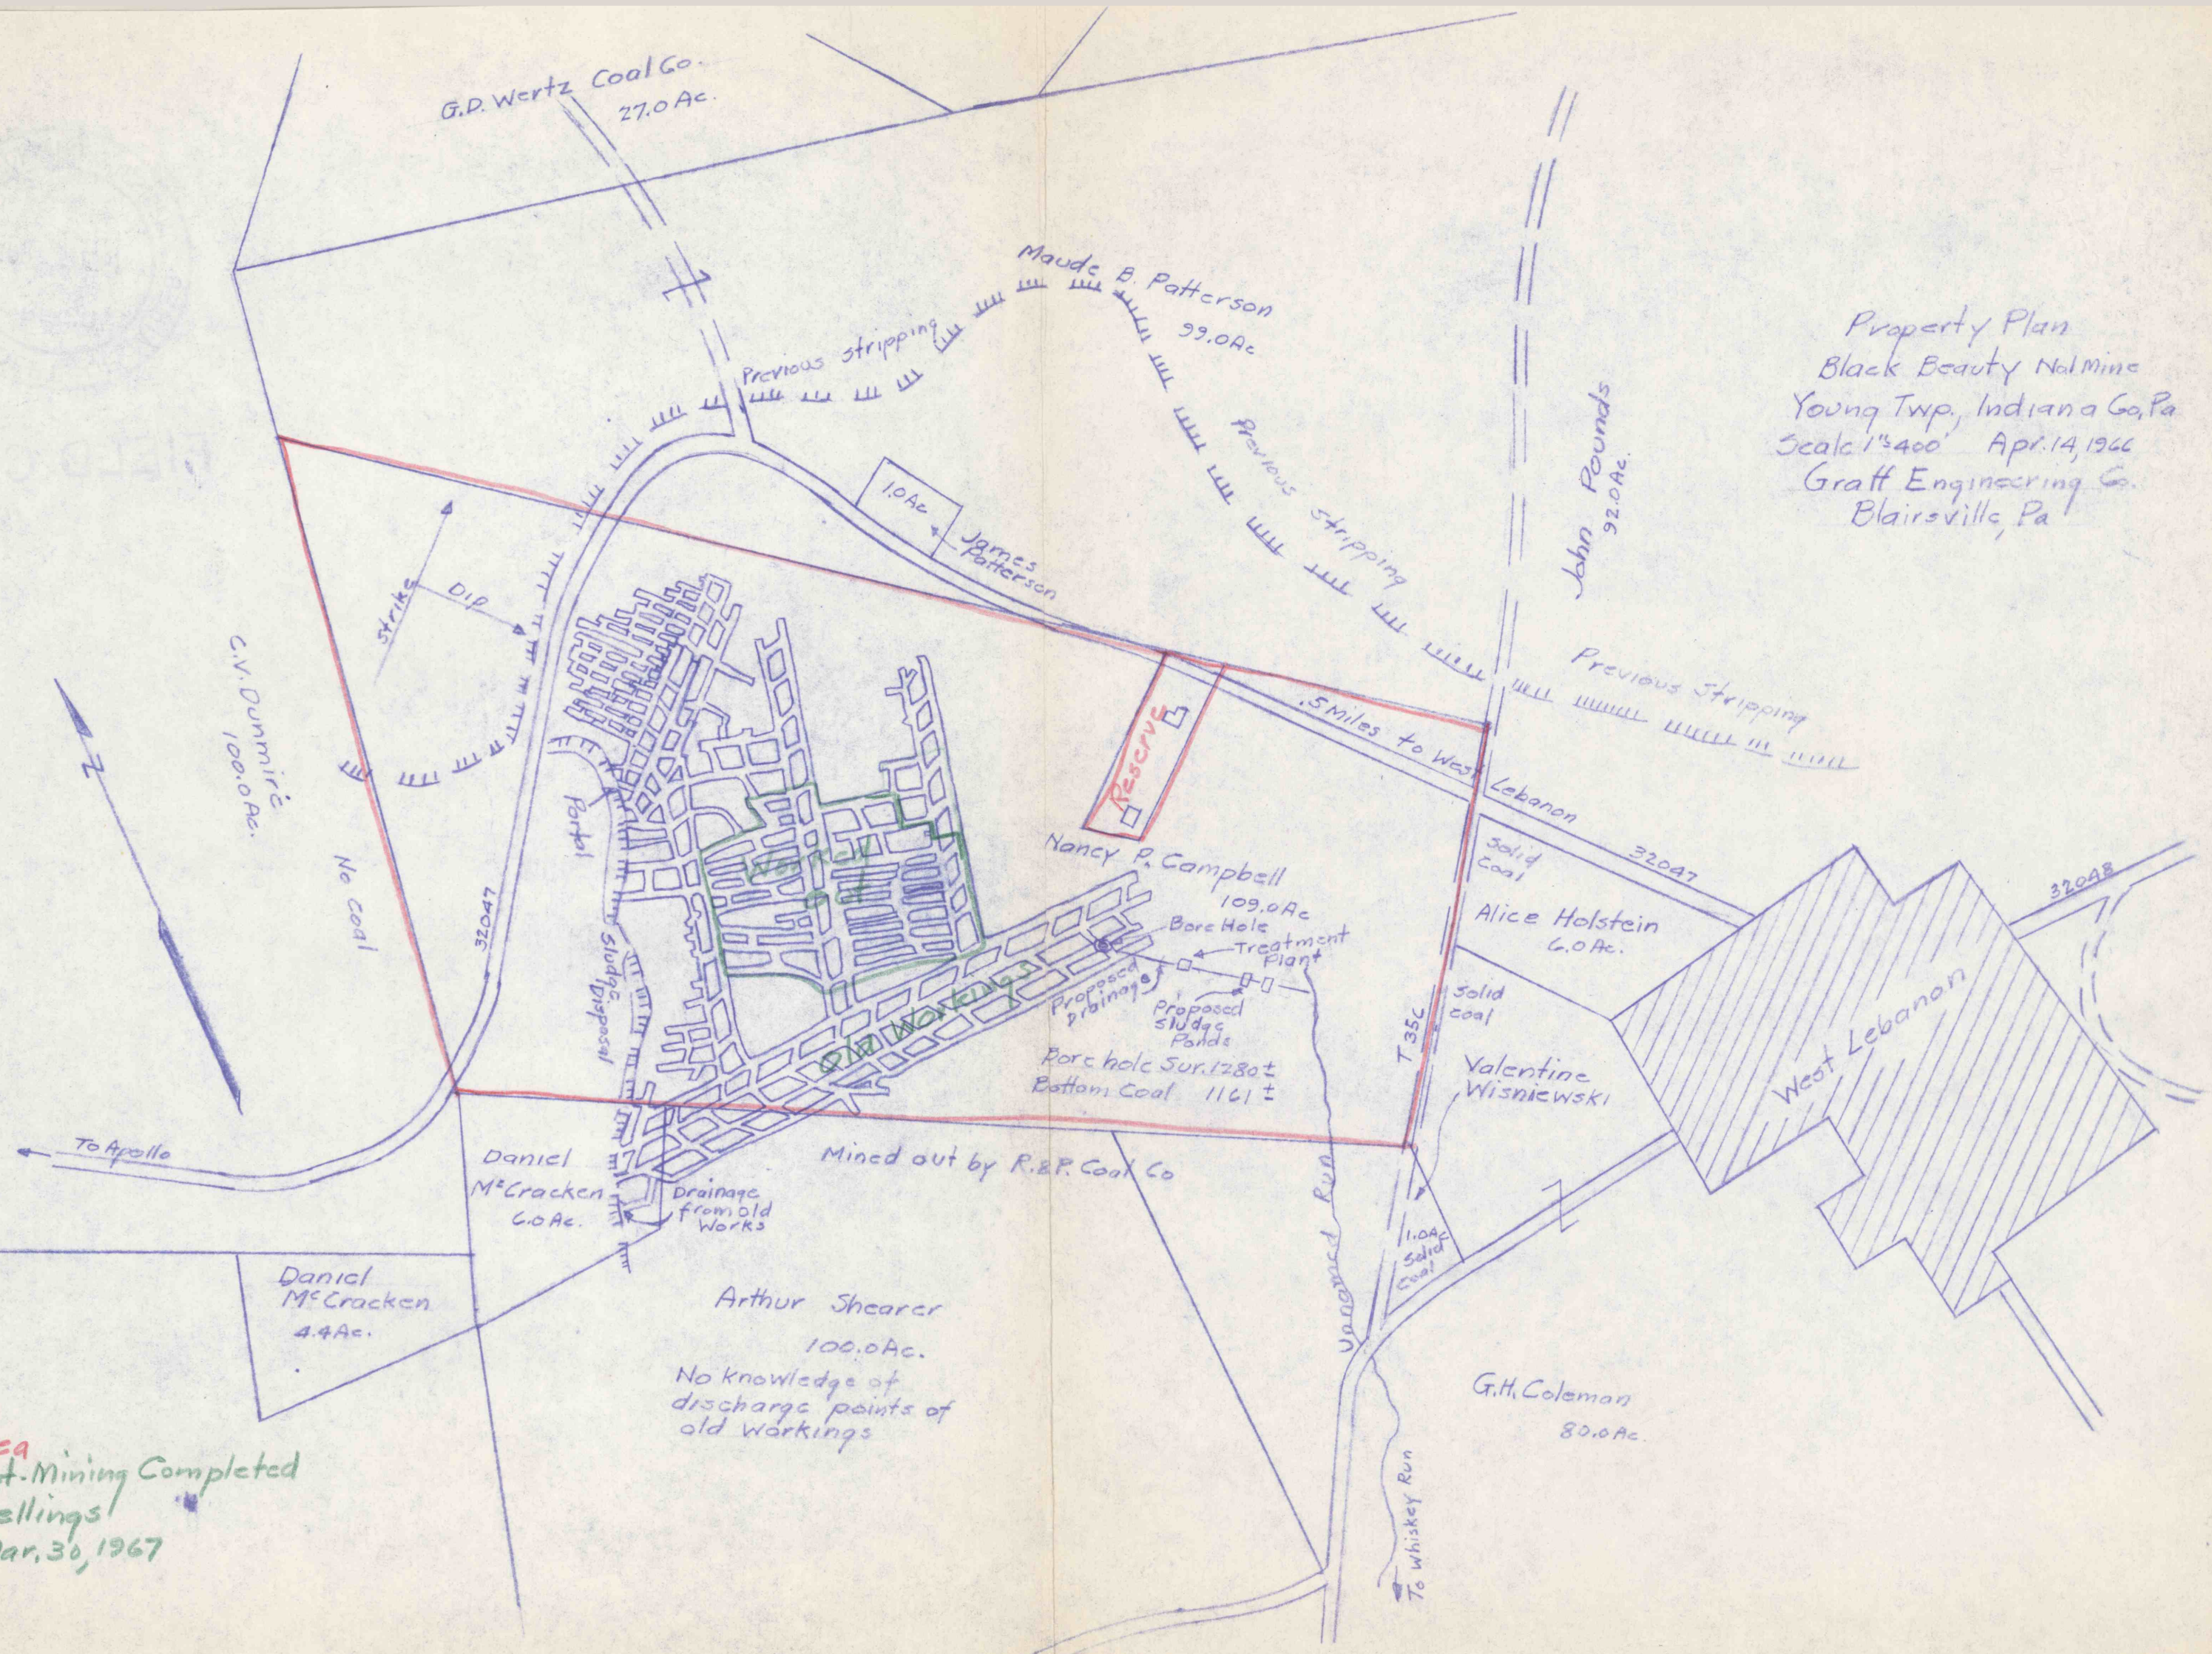

■ Coal Area
 ■ Mined out - Mining Completed
 No Dwellings
 Date Mar. 30, 1967

#278
 6-11-99
 C.C.