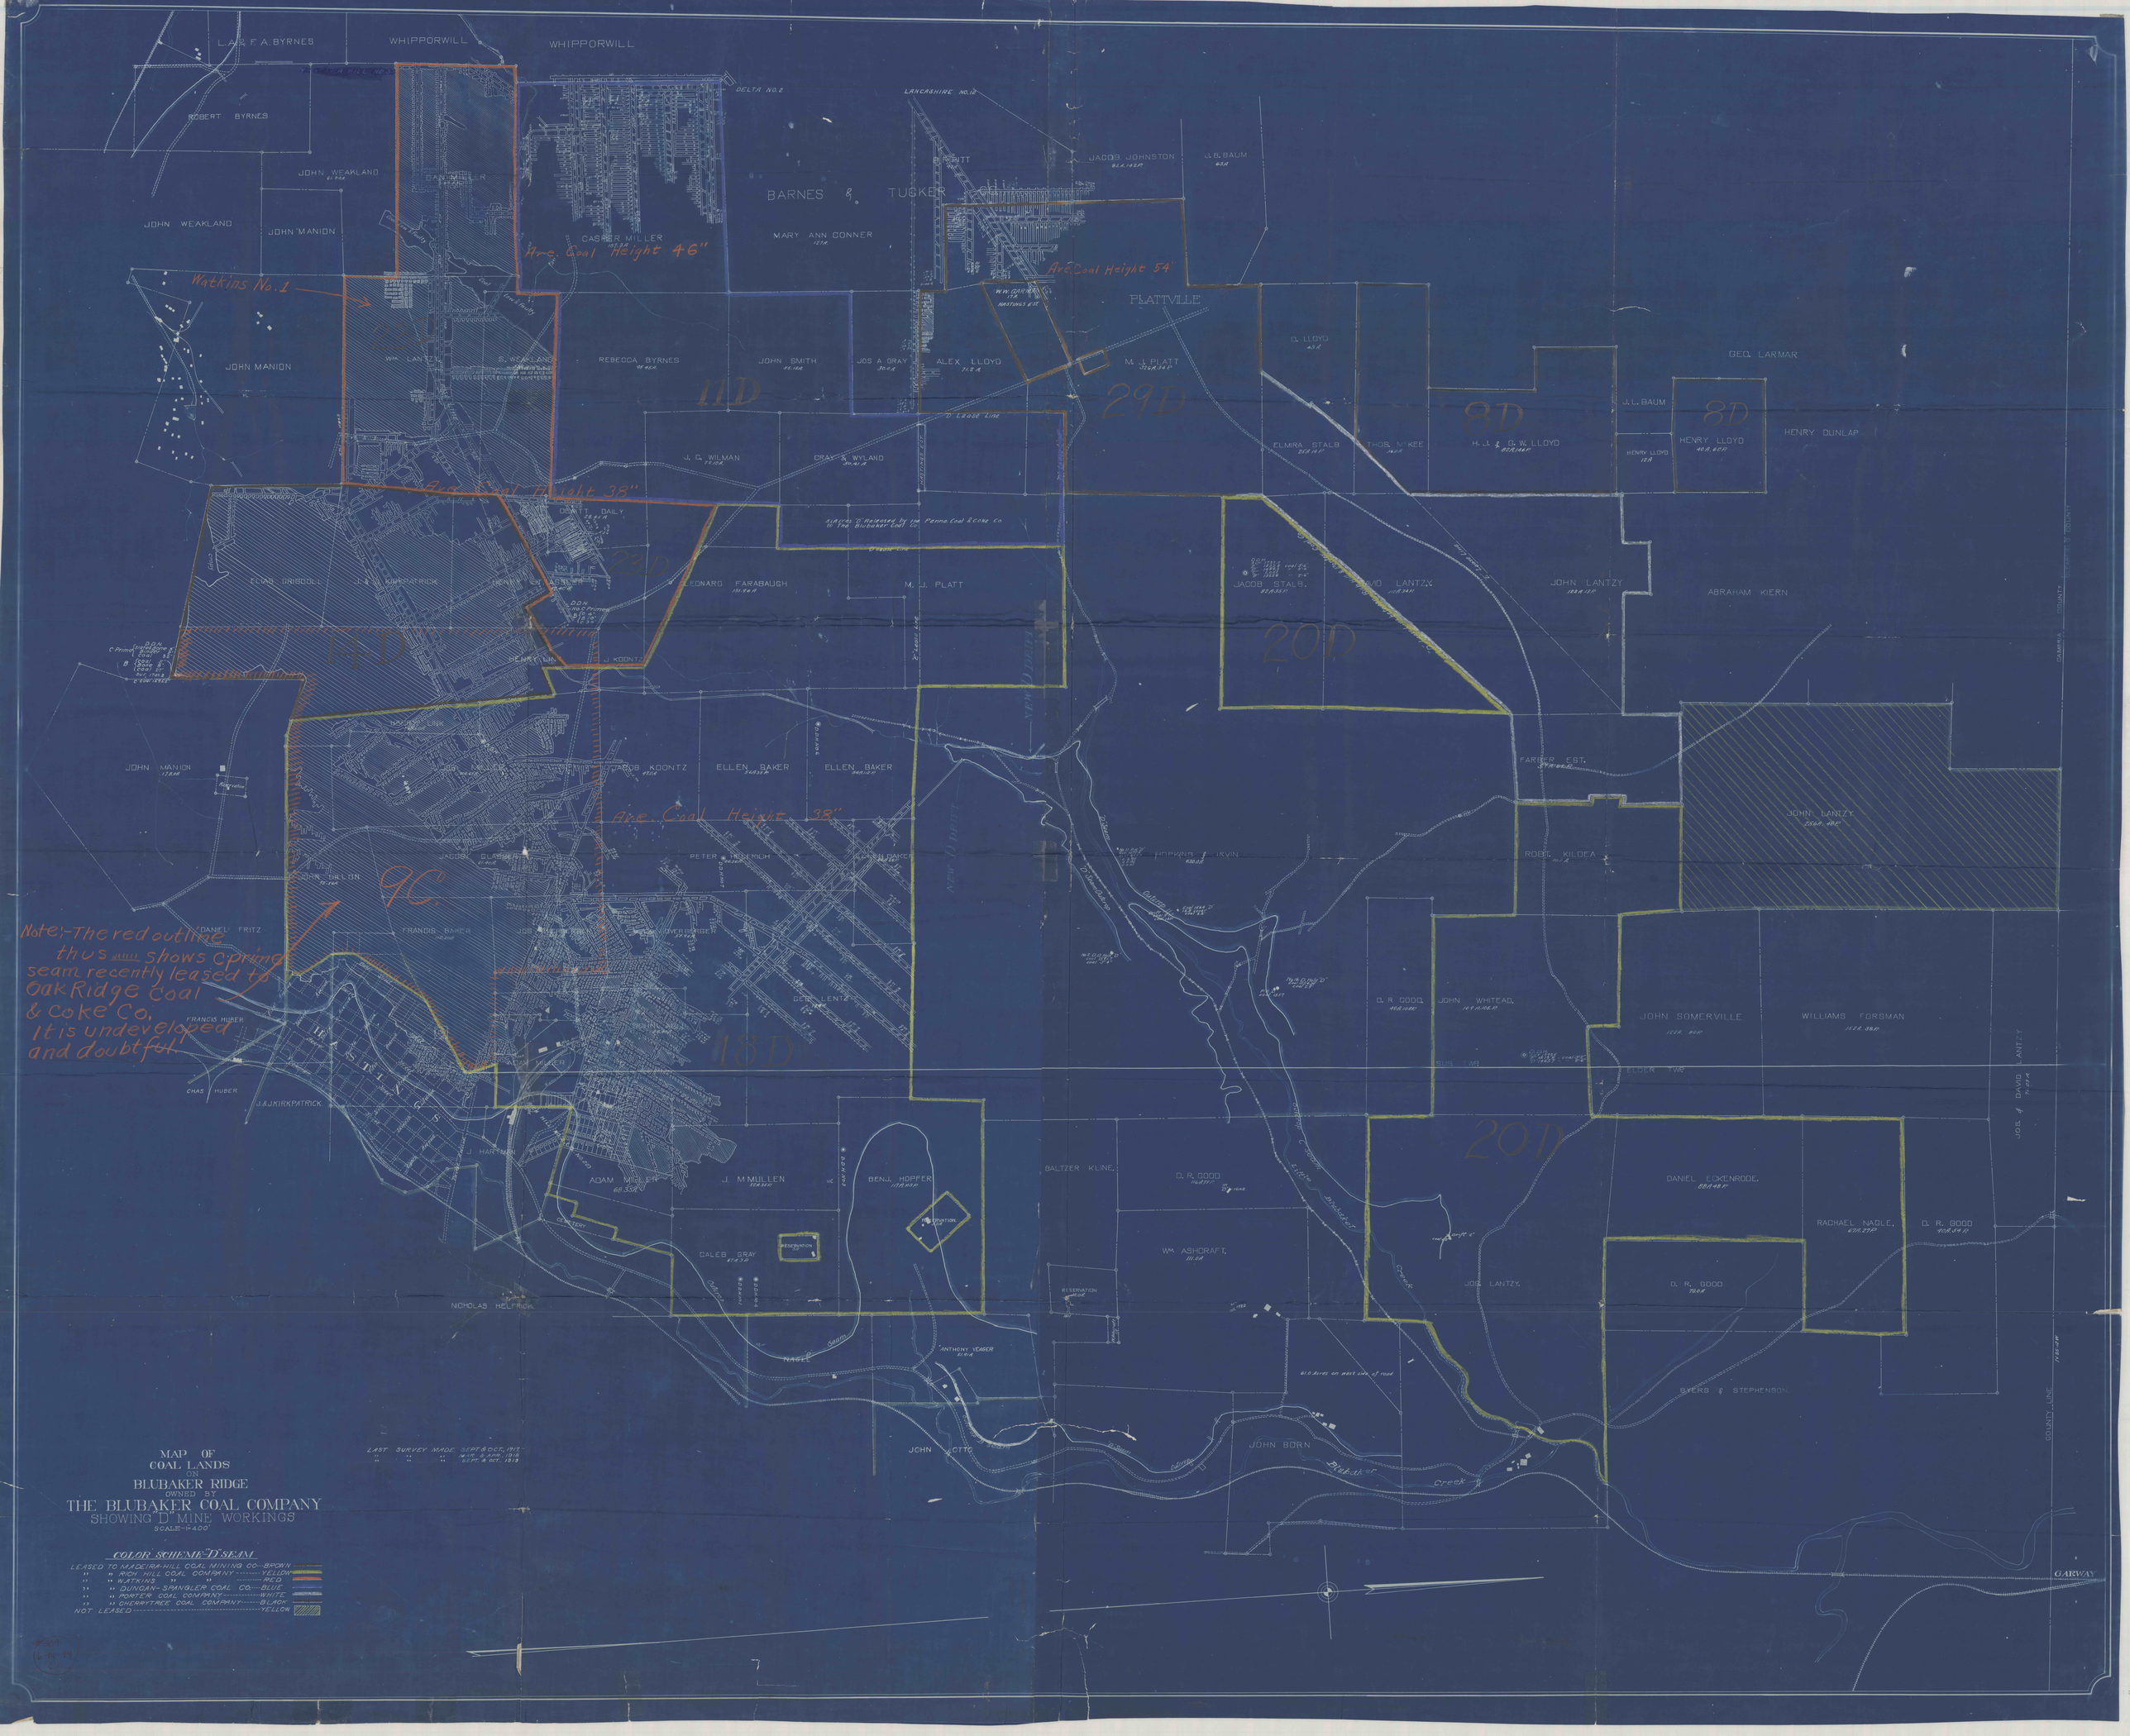
MAP OF
COAL LANDS
ON
BLUBAKER RIDGE
OWNED BY
THE BLUBAKER COAL COMPANY
SHOWING "D" MINE WORKINGS
SCALE-1"=400'
COLOR SCHEME-"D" SEAM
LEASED TO MADEIRA-HILL COAL MINING CO.---BROWN
" " RICH HILL COAL COMPANY ---------YELLOW
" " WATKINS " " ---------RED
" " DUNCAN-SPANGLER COAL CO.---BLUE
" " PORTER COAL COMPANY ----------WHITE
" " DIERRTREE COAL COMPANY----BLACK
NOT LEASED ----------YELLOW
LAST SURVEY MADE SEPT & OCT, 1917
" " " MAR. & APR. 1918
" " " SEPT. & OCT. 1918
Note:-The red outline thus shows "Prime" seam recently leased to Oak Ridge Coal & Coke Co. It is undeveloped and doubtful.
Watkins No. 1
Ave. Coal Height 46"
Ave. Coal Height 54"
Ave. Coal Height 38"
Ave. Coal Height 38"
BARNES & TUCKER
PLATTVILLE
WHIPPORWILL
HASTINGS
GARWAY
COUNTY LINE
1D
11D
29D
8D
23D
14D
9C
18D
20D
20D