


Northwestern Mng. & Exchange
Oyster Mine - Elk County


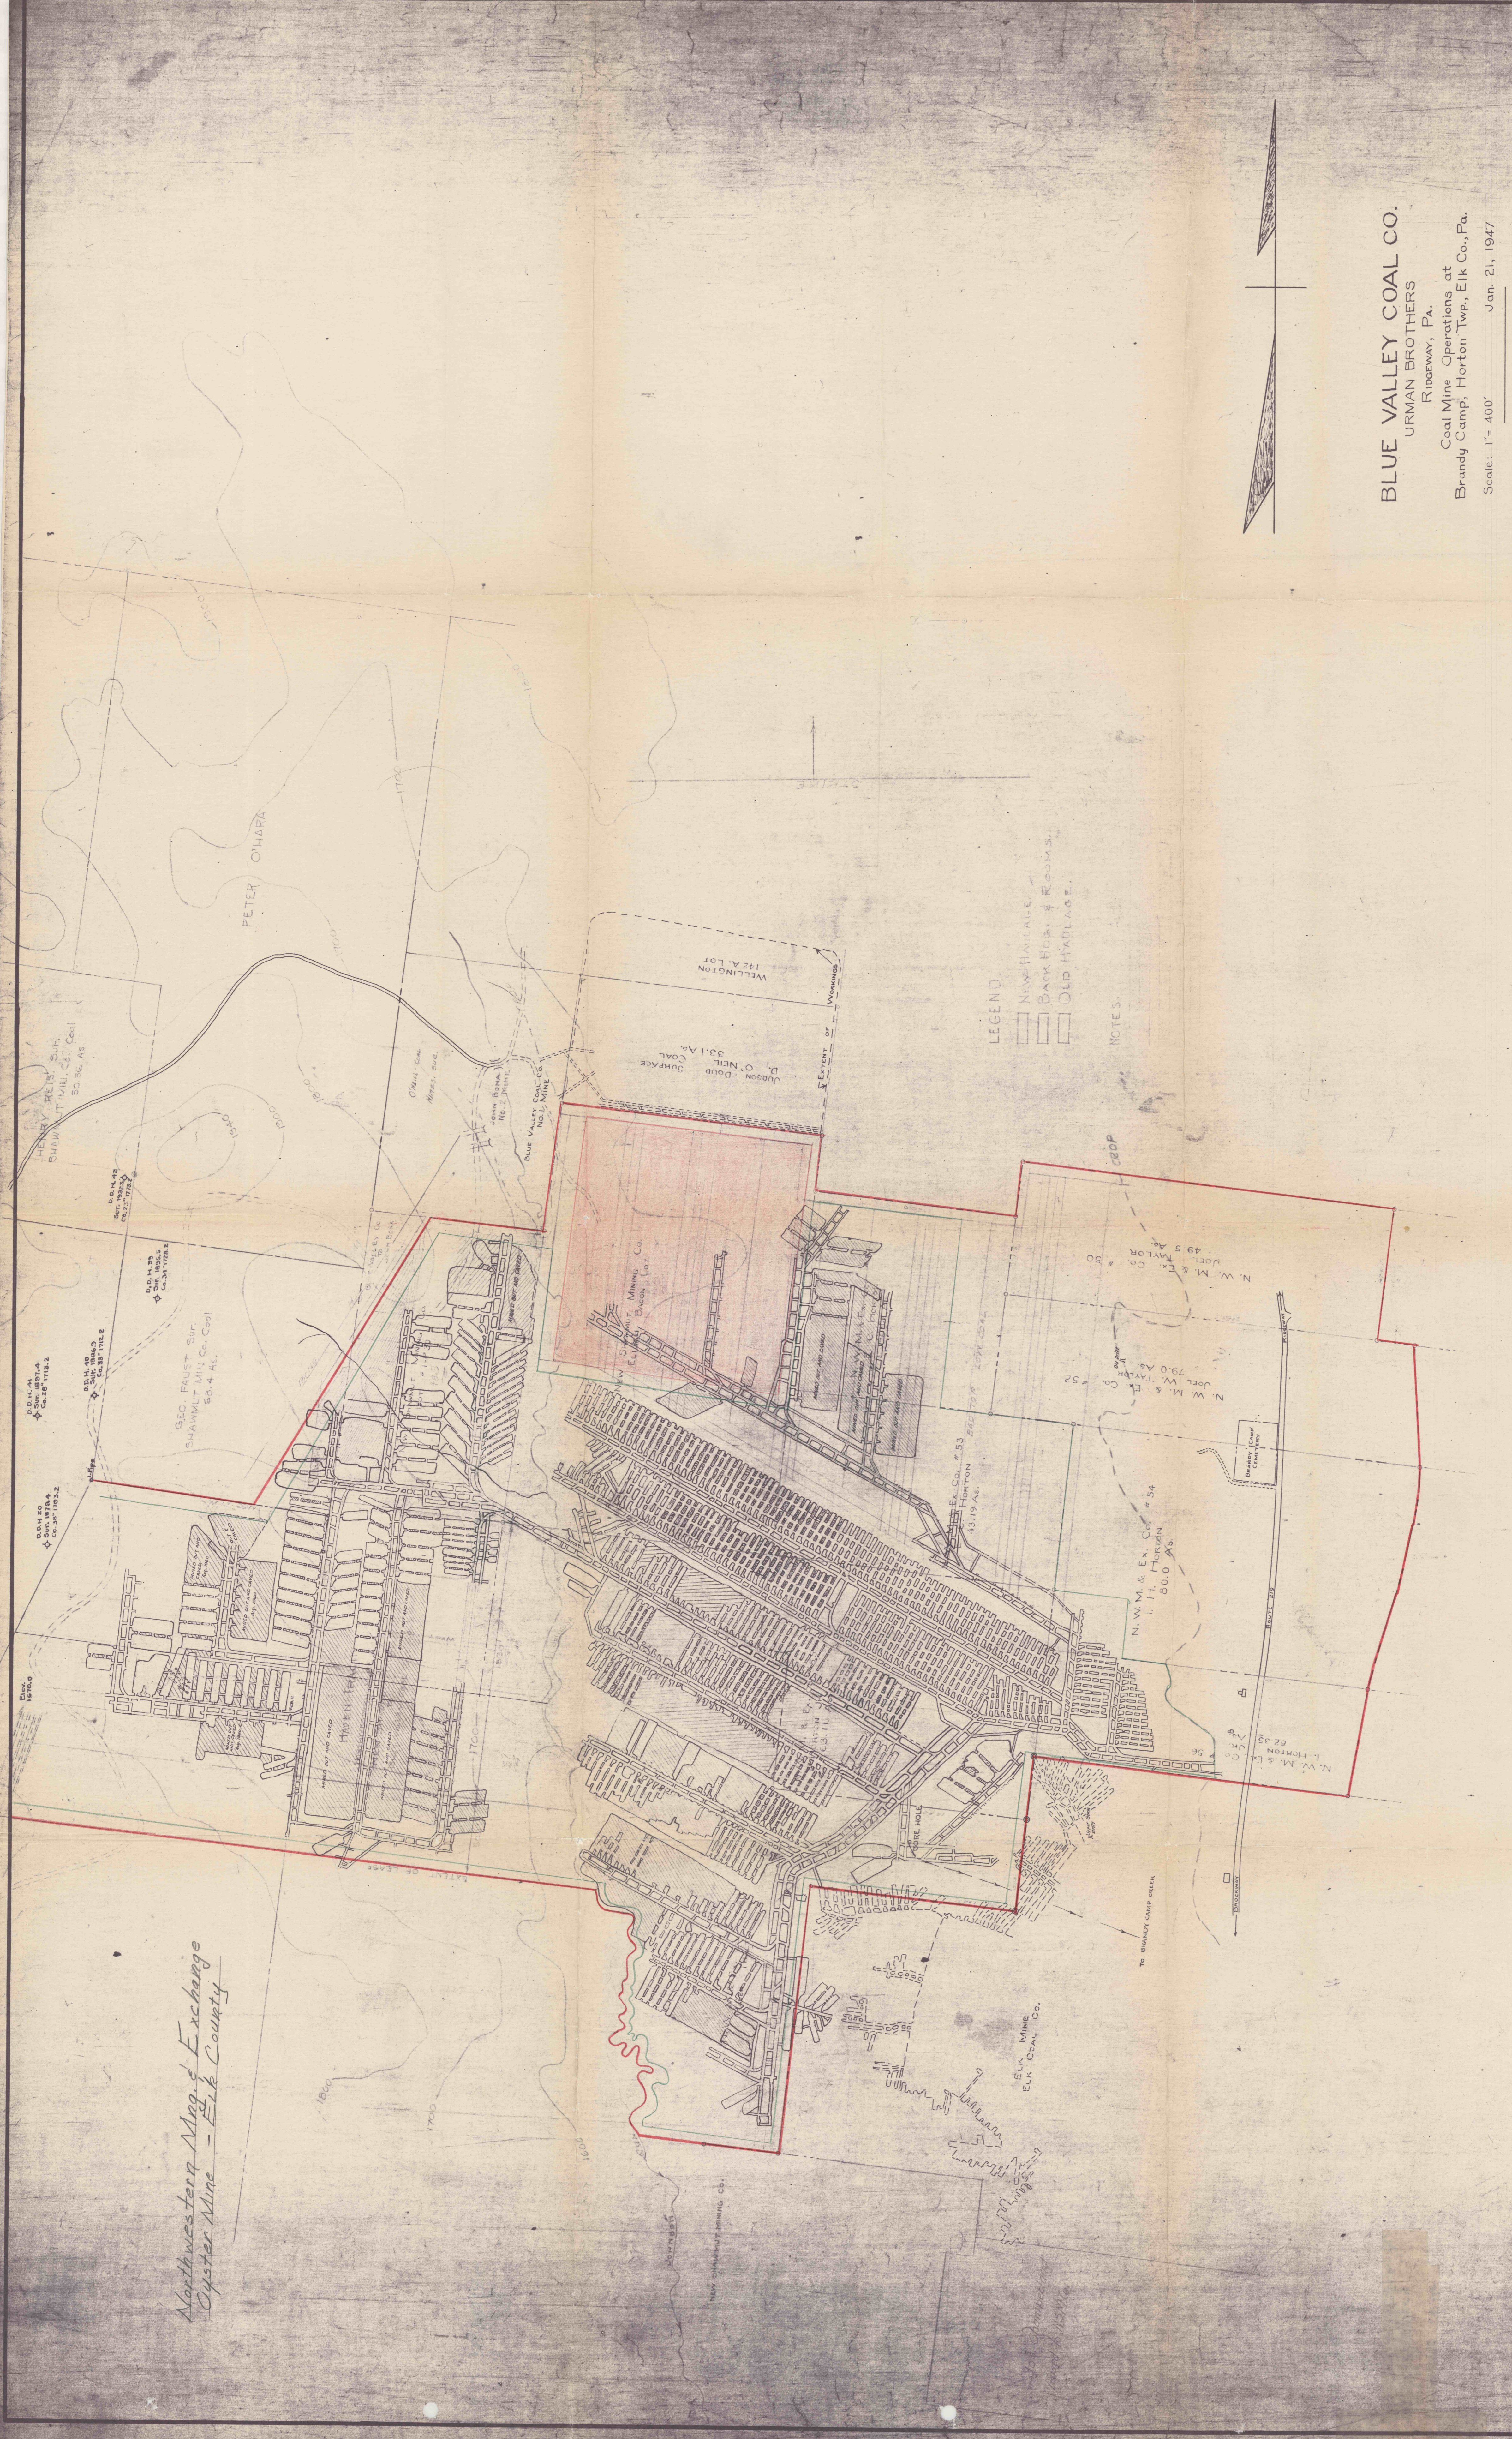


LEGEND
[Symbol] NEW HAIRLAGE
[Symbol] BACK HOUS. & ROOMS
[Symbol] OLD HAIRLAGE

NOTES

LEGEND
[Symbol] EXTENT OF LEASE
[Symbol] MINED & CAVED
[Symbol] AREA TO BE MINED

BLUE VALLEY COAL CO.
URMAN BROTHERS
RIDGEWAY, Pa.
Coal Mine Operations at
Brandy Camp, Horton Twp, Elk Co., Pa.
Scale: 1" = 400'
Jan. 21, 1947
YOST, BROMFIELD & HESS, ENGRS.
DuBois, Pa.
CLEARFIELD, Pa.

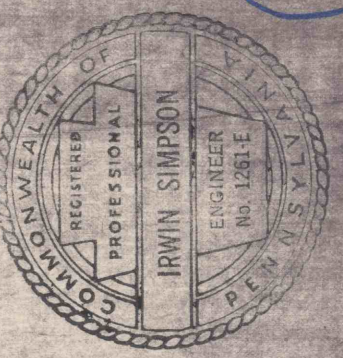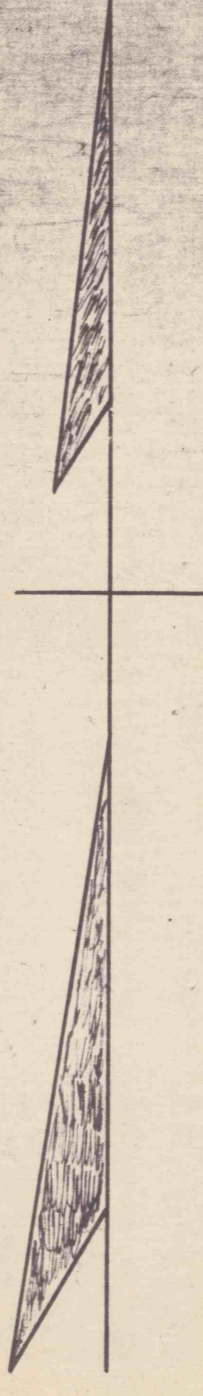

FIELD COPY

N. B. 143-146
FILE 1801

TO DATE AS OF
MAY 1947
FEBRUARY 11, 1956
OCT. 1957
JANUARY 5, 1961