


■ = All the mineral
E, D, C, B, & A seams.

■ = "E" seam on lease
from Geo. Baer Est

■ = Own "E" seam

■ = In Fee

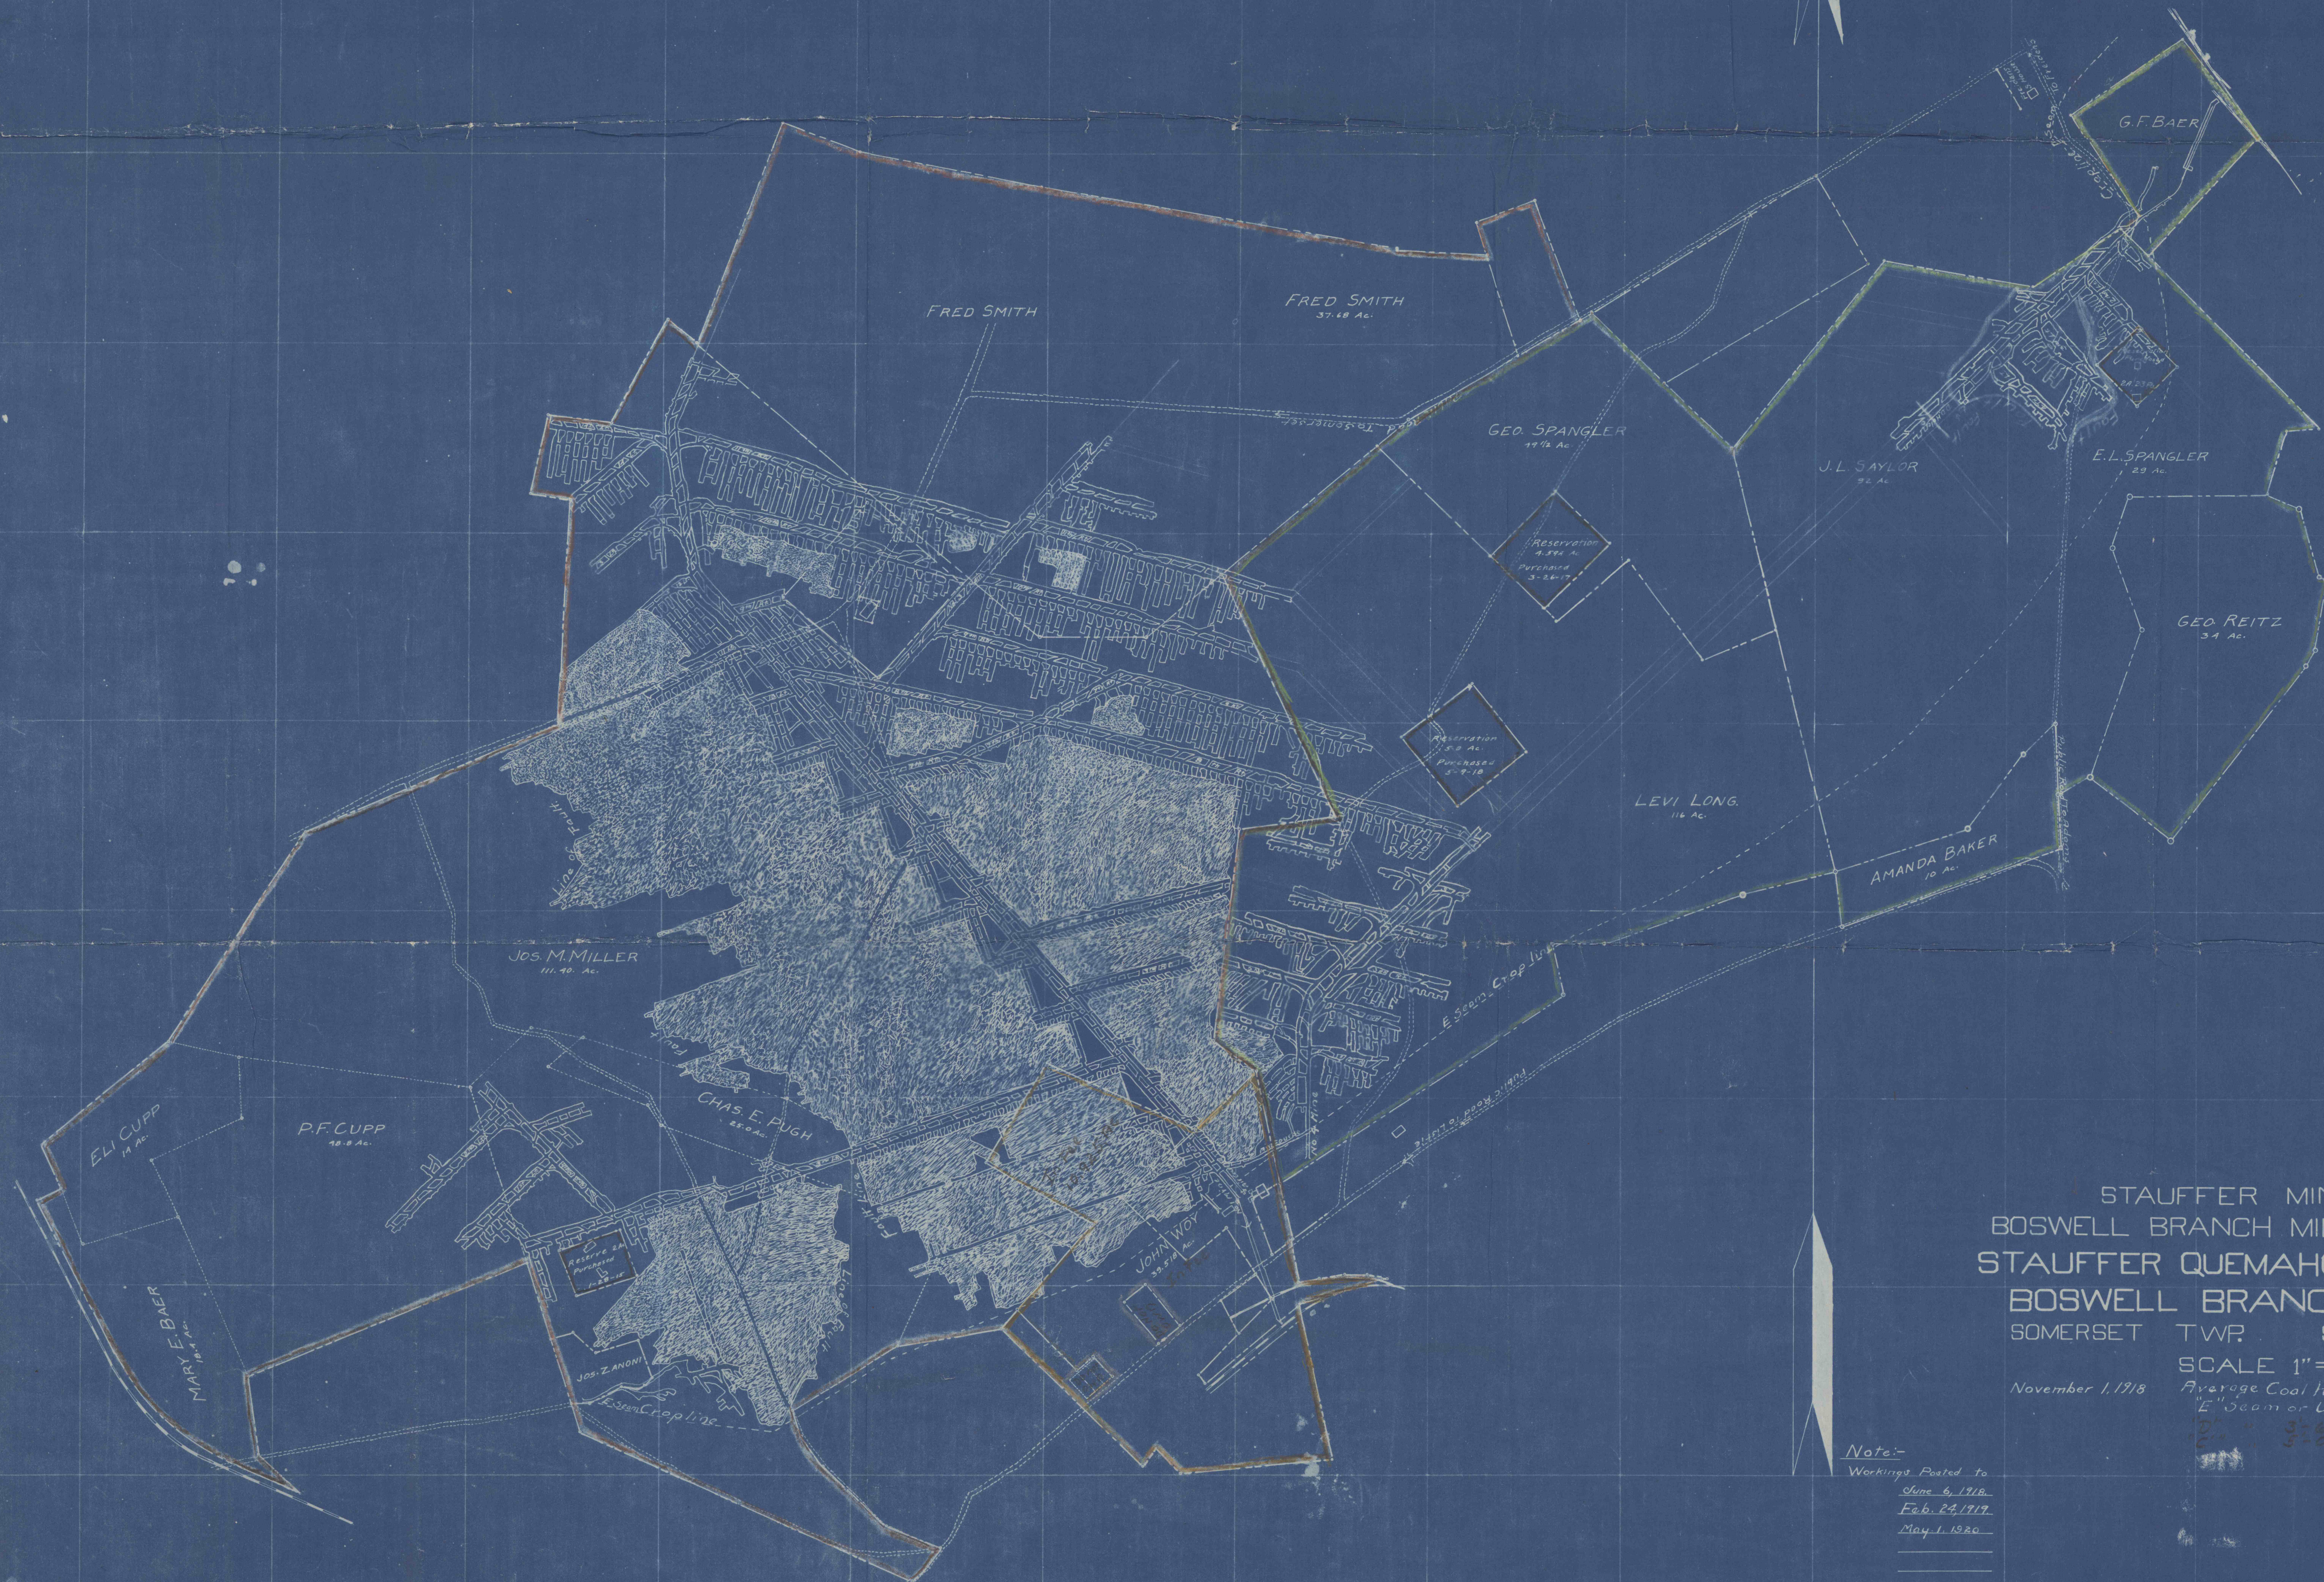

STAUFFER MINE NO. 1
BOSWELL BRANCH MINES NO. 1 & NO. 2
STAUFFER QUEMAHONING COAL CO.
BOSWELL BRANCH COAL CO.
SOMERSET TWP. SOMERSET CO. PA.

SCALE 1" = 400'
November 1, 1918 Average Coal Height = 40" Fluck and Moore
"E" seam or Upper Freeport Mining and Civil Engs.
Somerseet Pa.

Note:-
Workings Posted to
State 6, 1918.
Feb. 24, 1919.
May 1, 1920.

D. J. Morgan - M. Eng.

4-28-19
11-15-19
CCO