


#406  
6-17-99  
C.E.

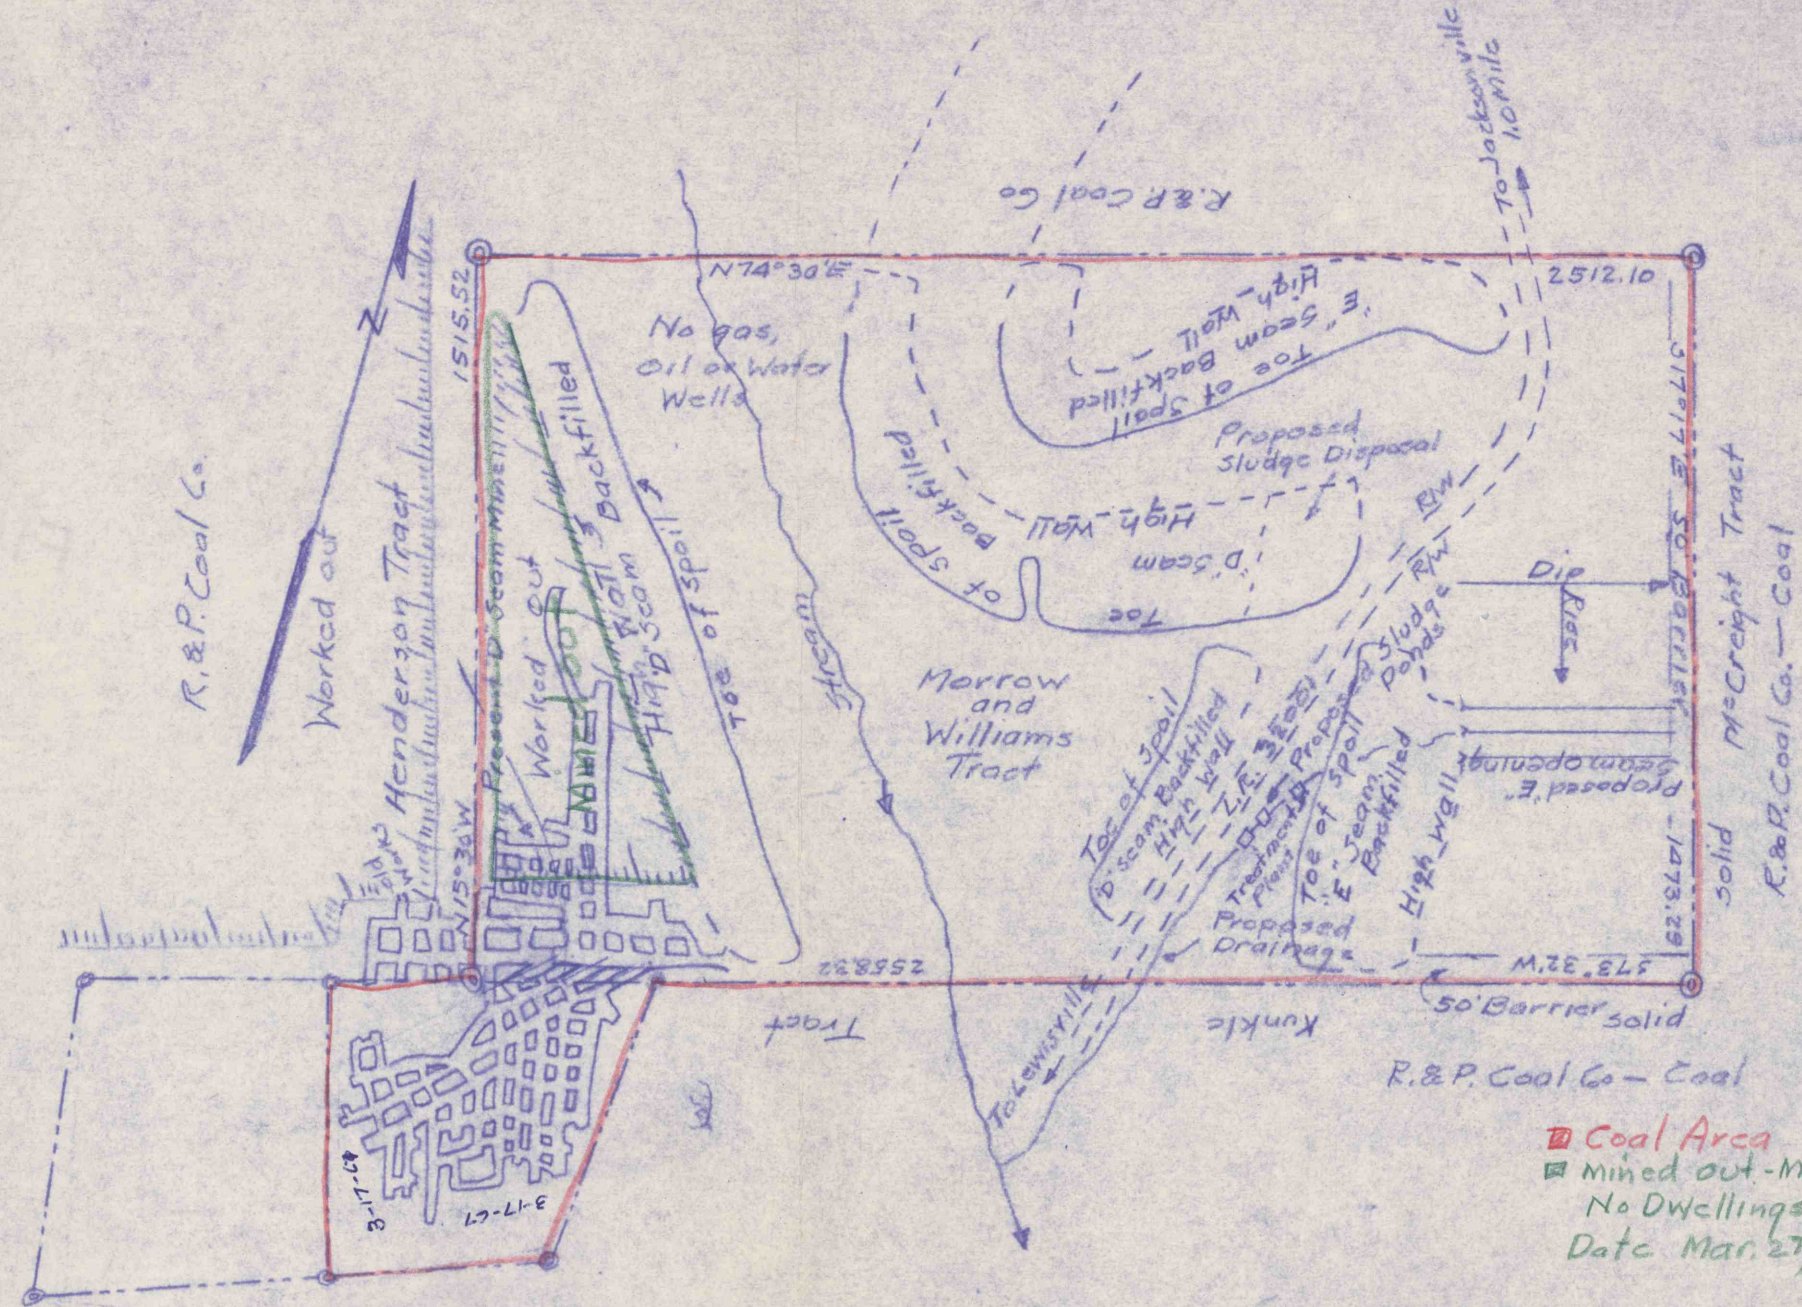

■ Coal Area  
■ Mined out - Mining Completed  
 No Dwellings  
 Date Mar. 27, 1967

Property Plan  
 C.A.S. Coal Company, Pa.  
 Young Twp, Indiana Co, Pa.  
 Scale 1/4" = 400' Apr. 28, 1964  
 Graff Engineering Co.  
 Blairsville Pa.