


ALLECHENY RIVER MINING CO.
 KITTANNING PA.
 CADOGAN NO. 2 MINE
 TWP. South Buffalo
 CO. Armstrong
 SCALE: 1" = 400'
 SURVEY DATE Completion 9-25-69
James Sprout
 R.S. 8414-B

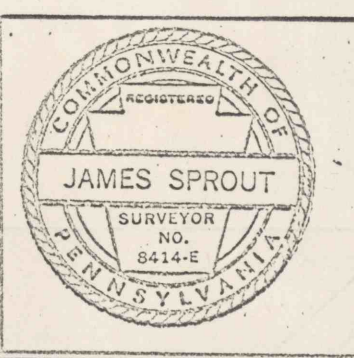

LEGEND

CONTEMPLATED MINING	
SUPPORT AREA	
PROTECTED STRUCTURES	
MINING COMPLETED AREA	