

#404
6-31-99
C.C.

MAP OF COAL LANDS

OWNED BY THE
Carbon Coal & Coke Co.
Situatod near
Langdonale, Bedford Co., Penna.

Scale: 7 inch = 400 feet.
Survey conducted by
P. E. Homelendorf, Engineer, & F. Donkle, Asst. Engineer.


October 1911
January 1912

JOSEPH E. THROPP

CAMBRIA IRON CO

CHEVINGTON & BUNN

COLONIAL IRON CO

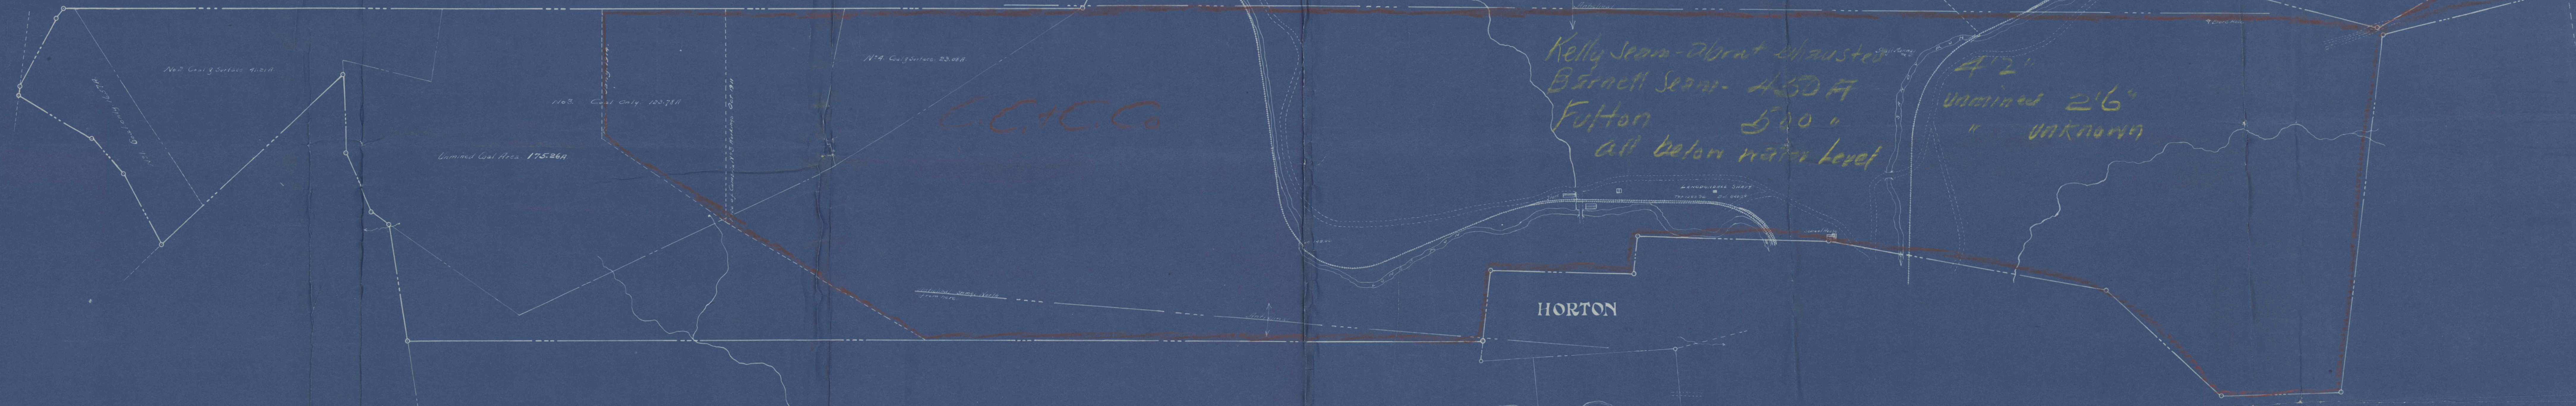

HORTON

S. T. BROWNS HEIRS

COLONIAL IRON CO

CAMBRIA IRON CO