

MANOR REAL ESTATE & TRUST CO.

EBENSBURG COAL CO. J. W. WISSENGER

EBENSBURG COAL CO.

ELIAS ROWLAND  
131.33

JEFFERSON ROWLAND  
111.71 AS

ELLSWORTH ROWLAND  
172.85 AS

DO NOT OWN  
LEASED TO  
LINCOLN COAL CO.

AMOS W. ROWLAND  
NOW  
WILLIAM GITTINGS  
82.53 AS


POSTED TO

- 7-1-80
- 1-1-81
- 7-1-81
- 1-1-82
- 7-1-82
- 12-31-82
- 1-1-83
- 8-1-83
- 10-31-83

LINCOLN COAL CO.

- RED B' COAL OWNED
- YELLOW B' COAL LEASED
- GREEN SURFACE OWNED

To the best of my knowledge  
and belief this is a true and  
accurate map of mining as  
completed

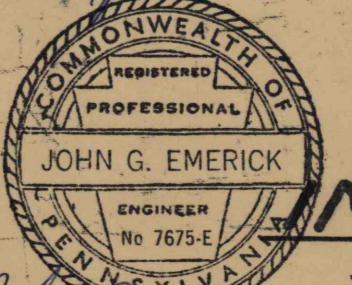

MAP  
SHOWING  
PROPERTY AND MINING OPERATIONS  
OF THE  
**IMPERIAL CARDIFF COAL CO.**  
SITUATE IN  
CAMBRIA CO. PA.

AUG. 7, 1930  
SCALE 1" = 400'  
FETTERMAN ENG. CO.

#455 59  
6-82  
C.G.

MONTOE COAL MINING CO.