





THIS MAP PREPARED BY L. ROBERT KIMBALL & ASSOCIATES
 Consulting Engineers & Architects, EBENSBURG, PENNSYLVANIA.
 BY PHOTOGRAMMETRIC METHODS FROM AERIAL PHOTOGRAPHY
 DATED APRIL 3, 1980

SHEET INDEX

1
2

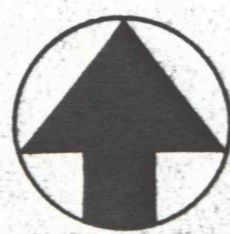

LEGEND
 PROPERTY AREA ———
 MINING AREA - - - - -

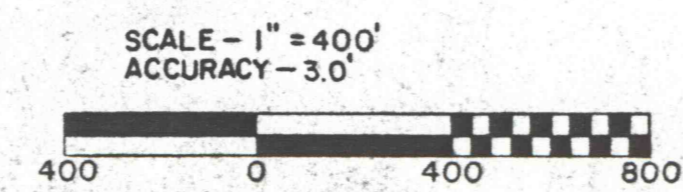

SIGNATURE & SEAL OF ENGINEER

STANFORD MINING COMPANY
 P.O. BOX 188
 DIXONVILLE, PA. 15734
 (717) 453-5829

CHESTNUT RIDGE MINE
 CHERRYHILL TWP., INDIANA COUNTY, PENNA.
 LOWER KITTANNING SEAM

PREPARED BY _____
 REVISED BY _____
 REVISION _____

PREPARED BY _____
 MEARS COAL CO. ENG. DEPT.
 P.O. BOX 188
 DIXONVILLE, PENNA. 15734

RECEIVED
 APR 24 1987
 Dept. of Environmental Resources
 McMurray District Office

1" = 400'

SHEET 1 OF 2

FINAL MAP