


MAP OF
CUNARD SLOPE
AT
MORRISDALE, CLEARFIELD CO., PA.

Revised to Jan. 1920.
Scale 1" = 400'
L.B. Smith, Eng.
"B"U
MORRIS TRG. CLEARFIELD CO., PA.

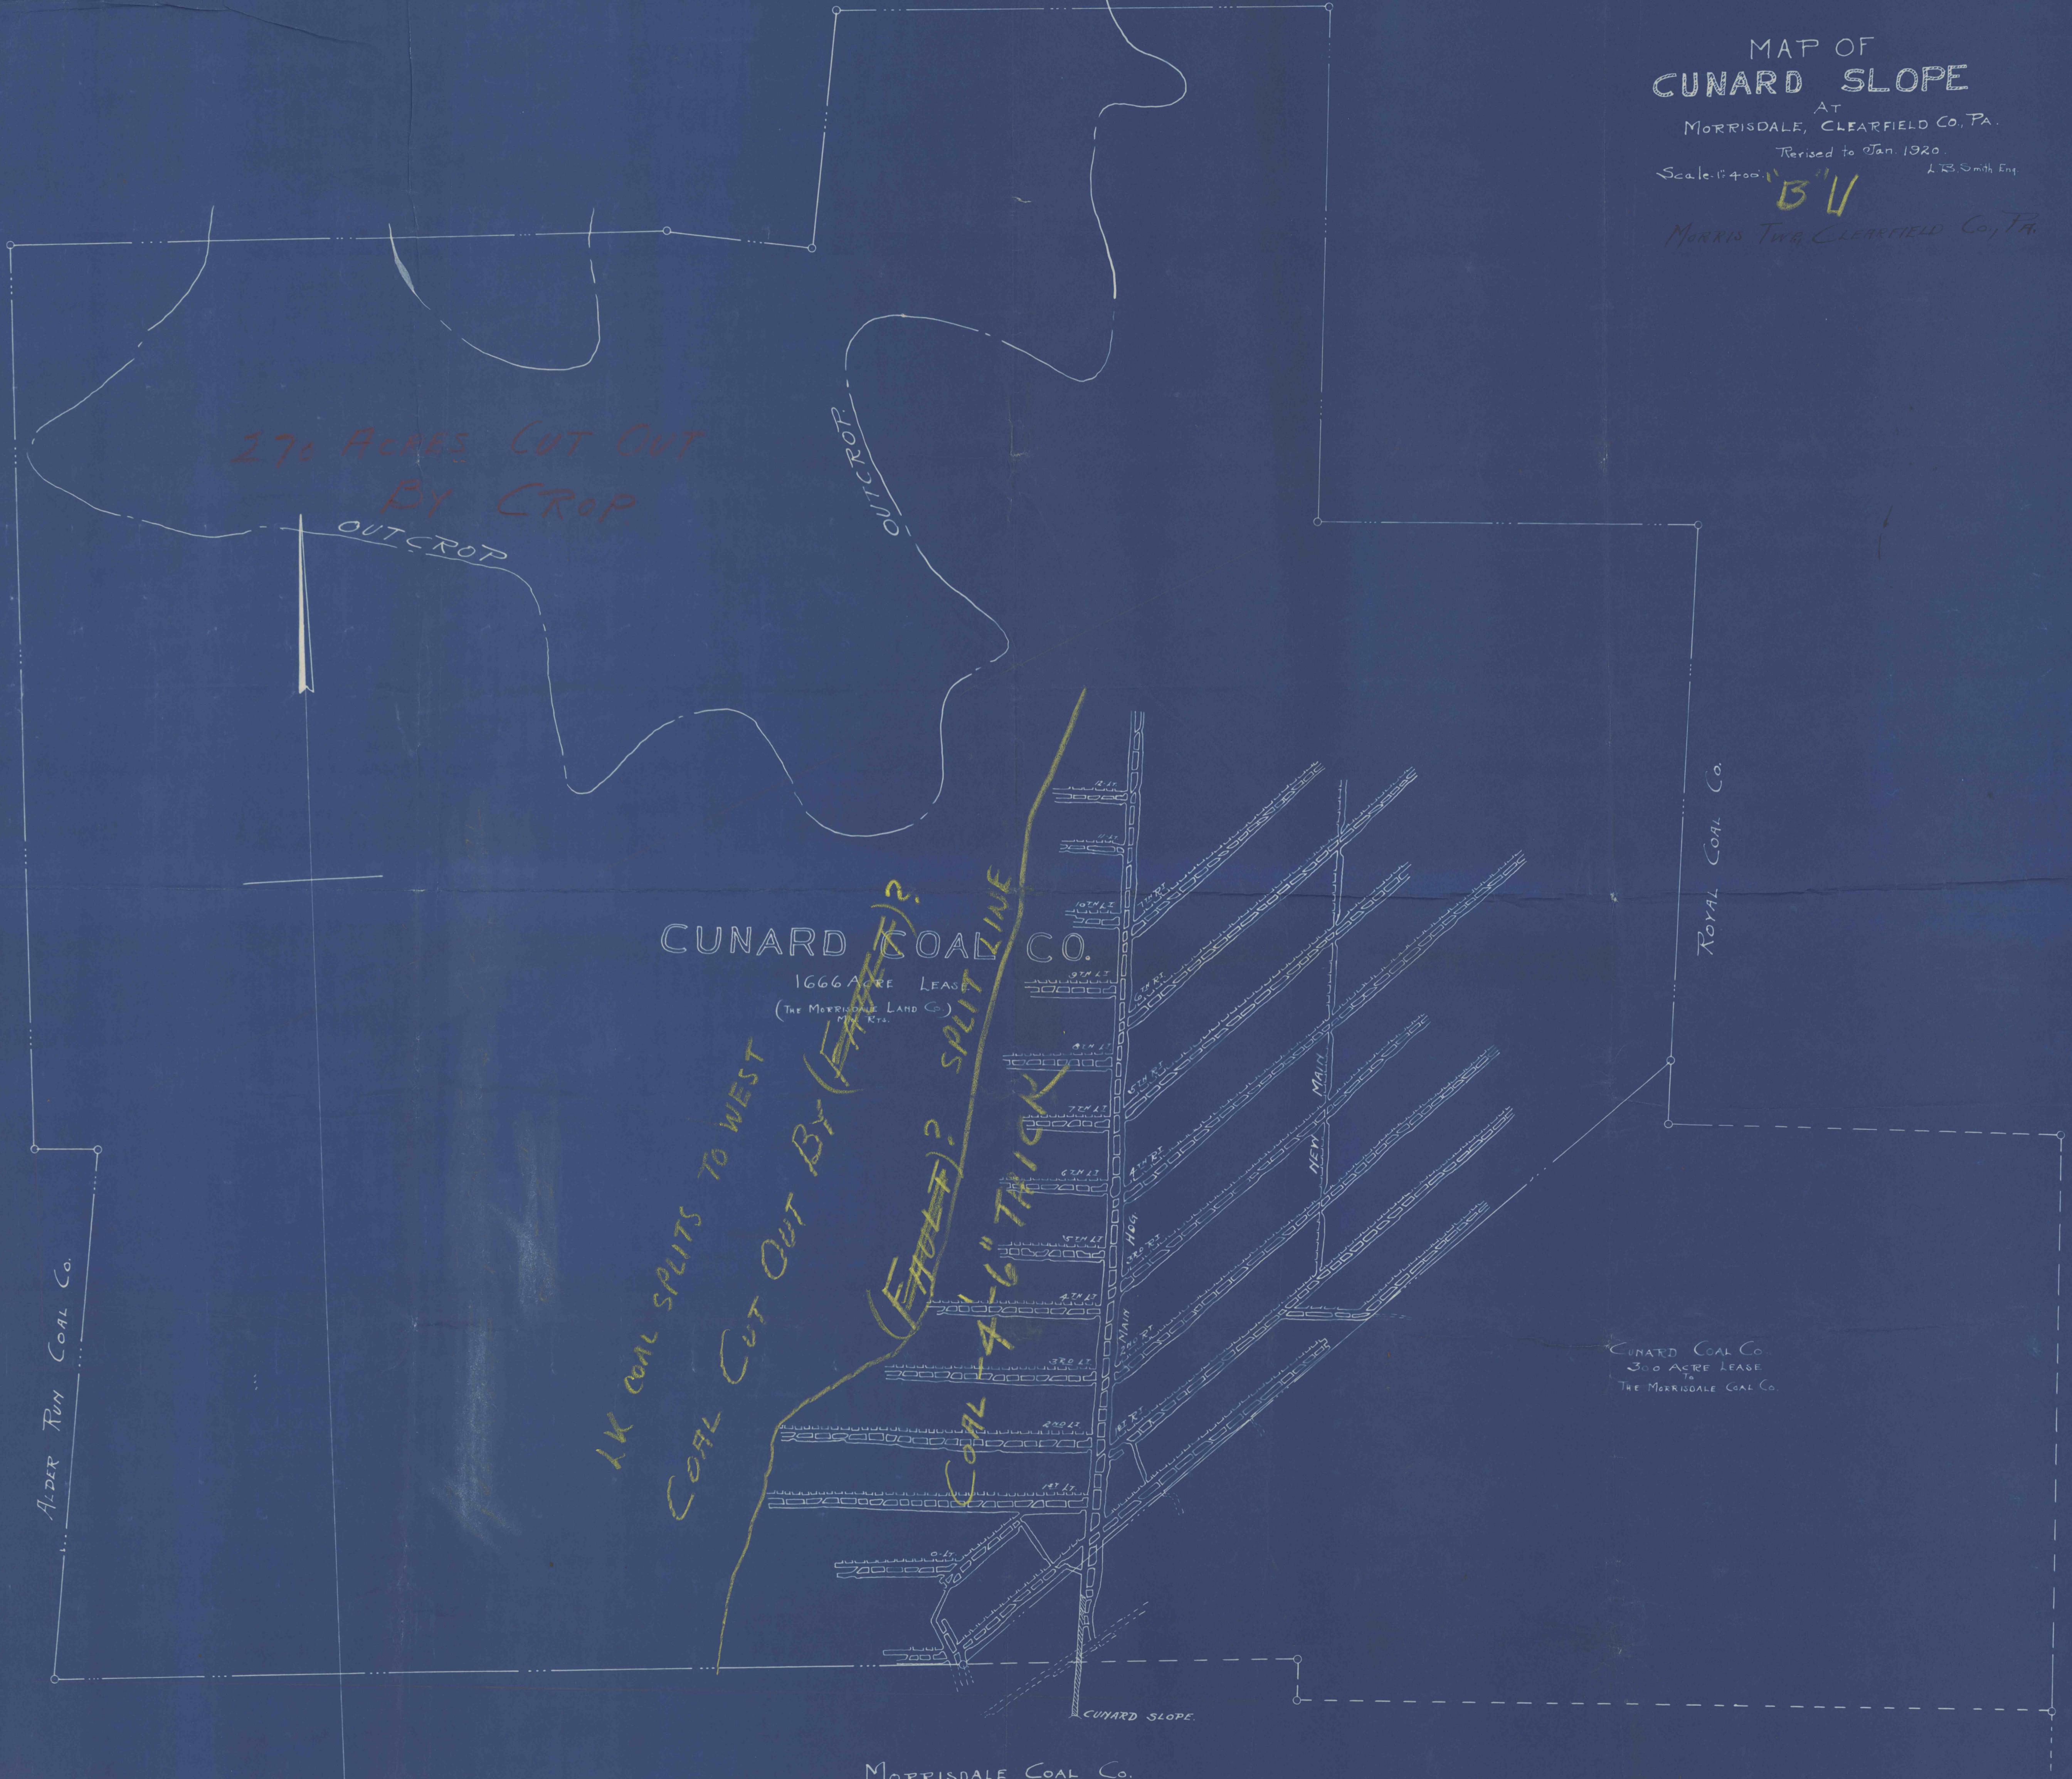

270 ACRES CUT OUT
BY CROP
OUTCROP

OUTCROP

CUNARD COAL CO.

1666 ACRE LEASE
(THE MORRISDALE LAND CO.)
MORRISDALE, PA.

1 1/2 COAL SPLITS TO WEST

COAL 4'-6" THICK

ROYAL COAL CO.

CUNARD COAL CO.
300 ACRE LEASE
TO
THE MORRISDALE COAL CO.

ALDER RUN COAL CO.

MORRISDALE COAL CO.

CUNARD SLOPE