


Map showing
COAL LANDS
 Owned by the
Imperial Coal Corporation
 situate in
East Wheatfield Twp. Indiana Co., Pa.

Scale 1"=400' December 1, 1919
 Fetterman Engr. Co.

- COAL OWNED
- COAL LEASED
- SURFACE OWNED
- SURFACE LEASED

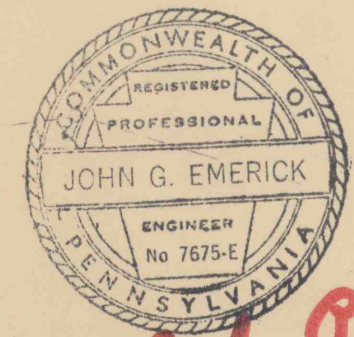

John G. Emerick
LEGEND

- MINE PROPERTY LIMITS ———— [Red Line]
- PERMITTED AREA ———— [Blue Line]
- SIX MONTH PROJECTED AREA ———— [Orange Line]
- PROPERTY OWNERS BL'DG. NUMBER — [Circle with Number] ETC.

#802
 7-8-99
 CC

POSTED TO: 12-31-65