
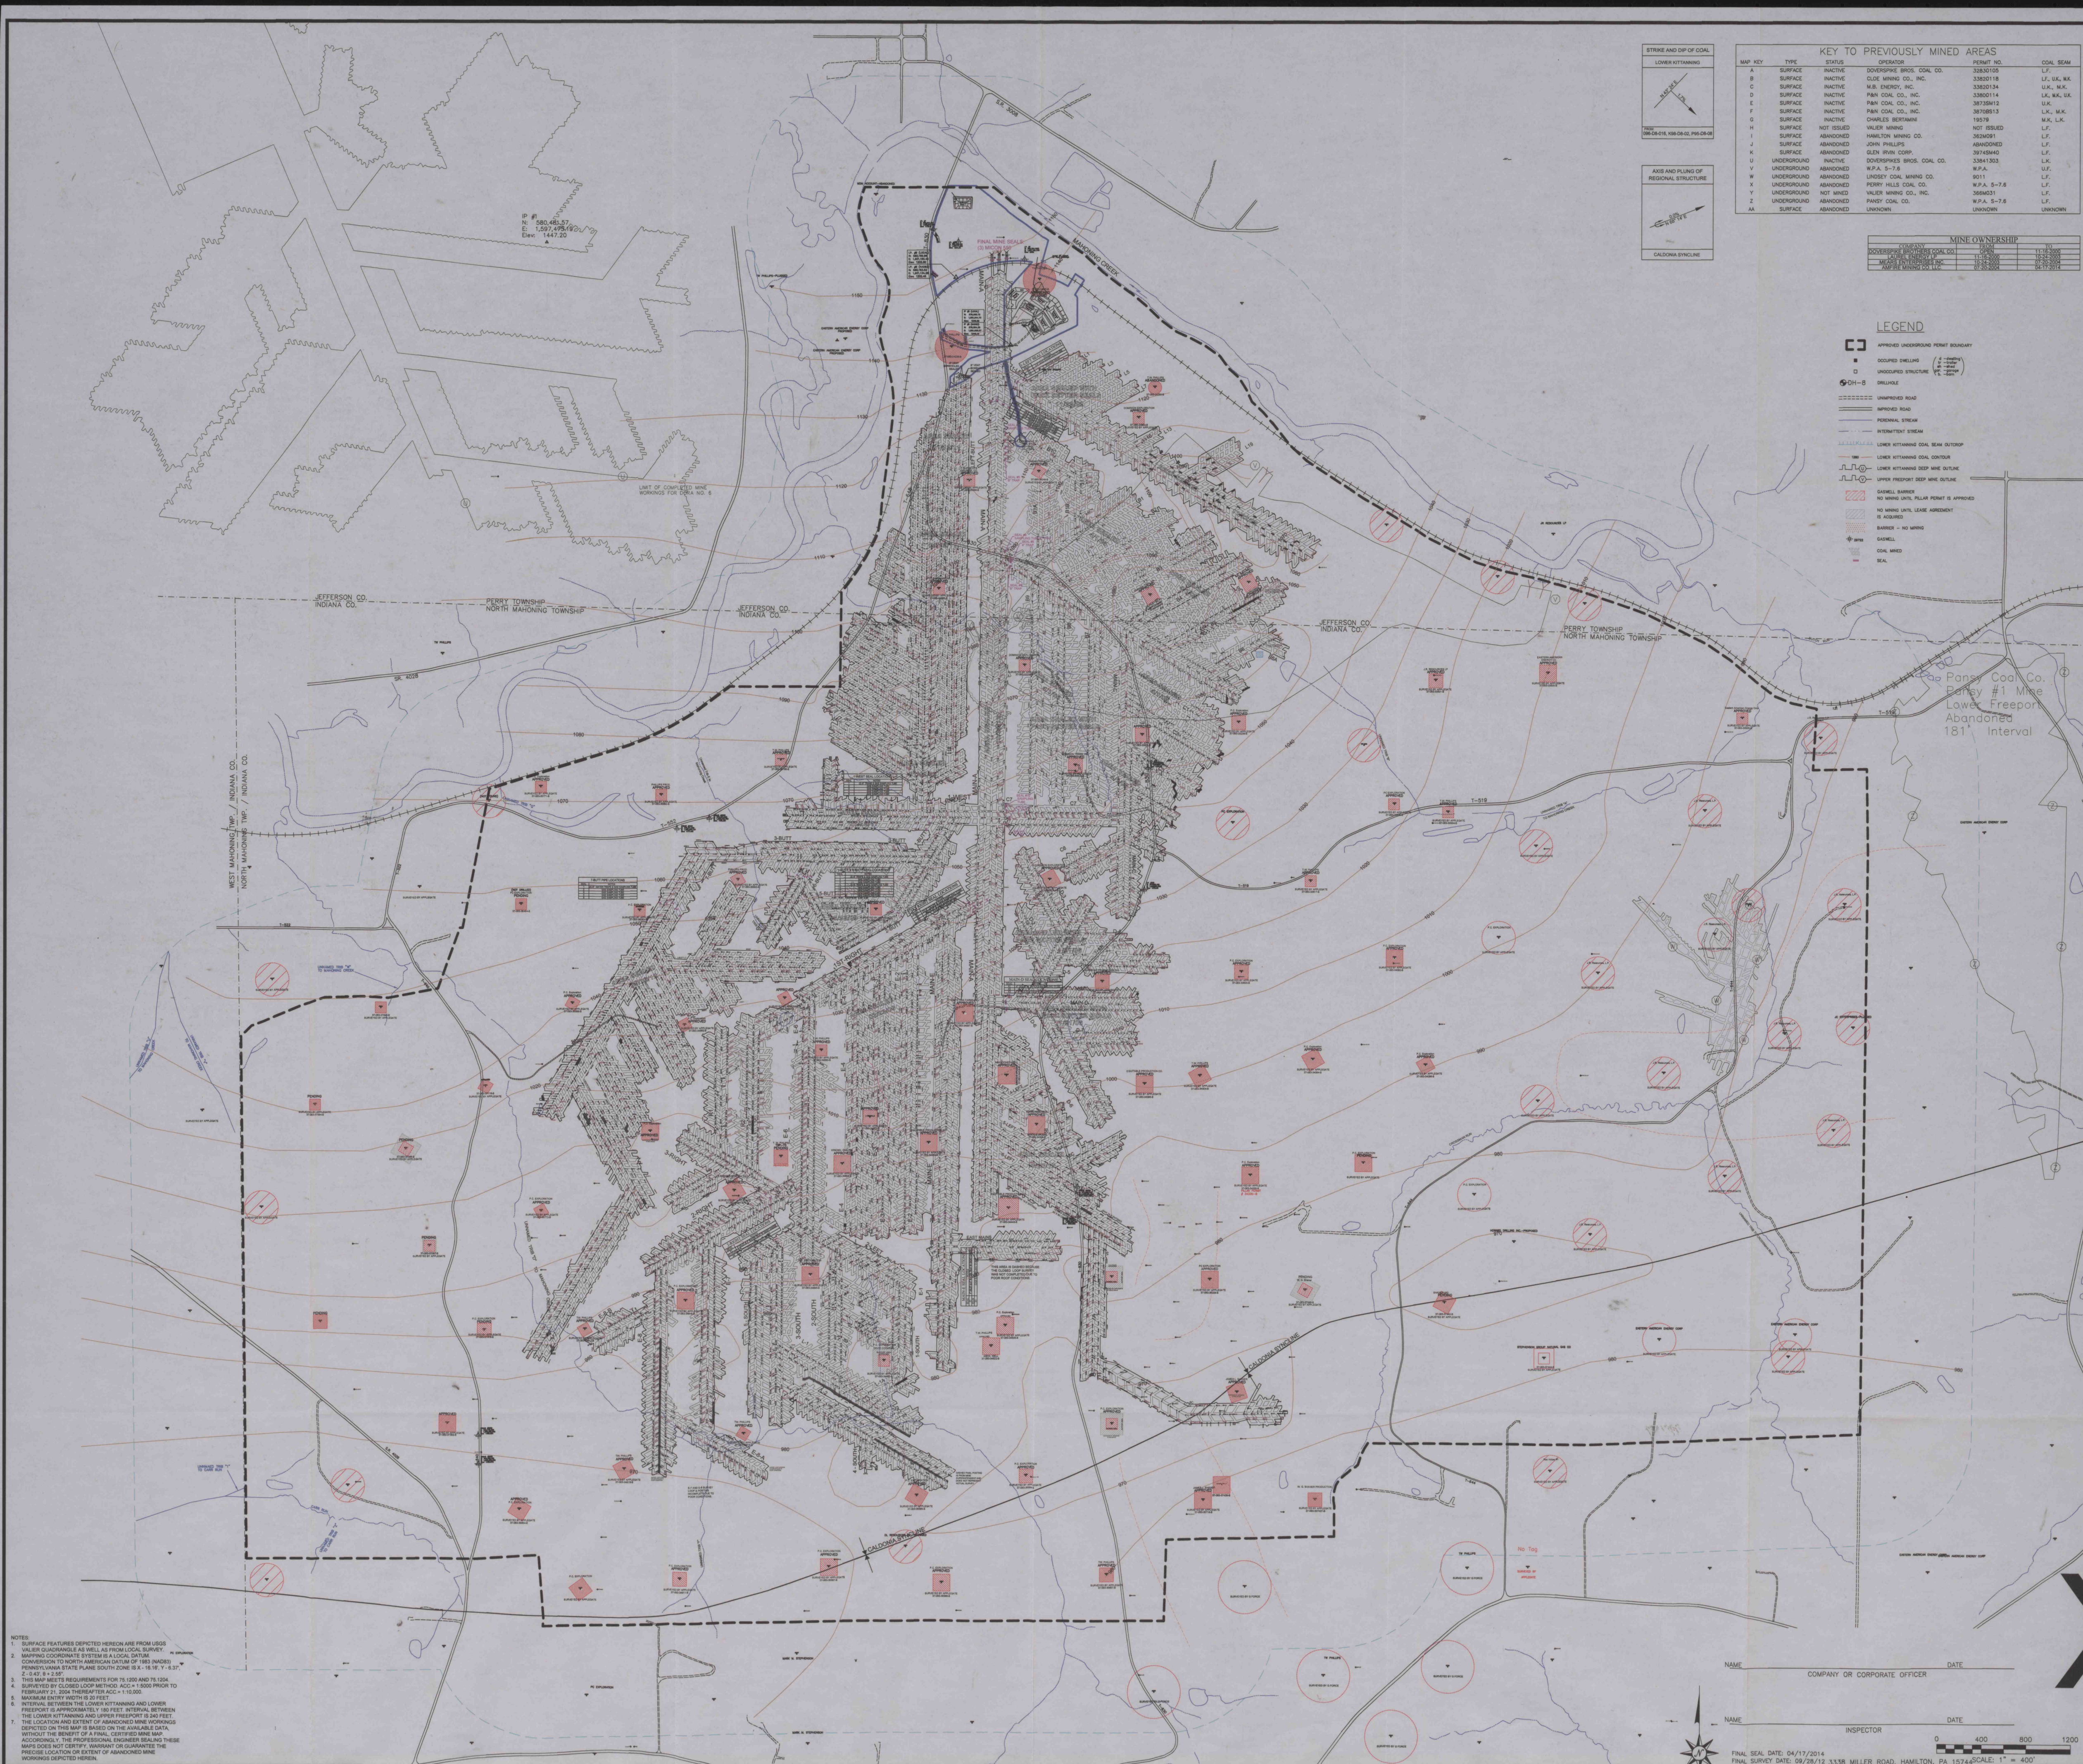


KEY TO PREVIOUSLY MINED AREAS						
MAP KEY	TYPE	STATUS	OPERATOR	PERMIT NO.	DATE	COAL SEAM

MINE OWNERSHIP			

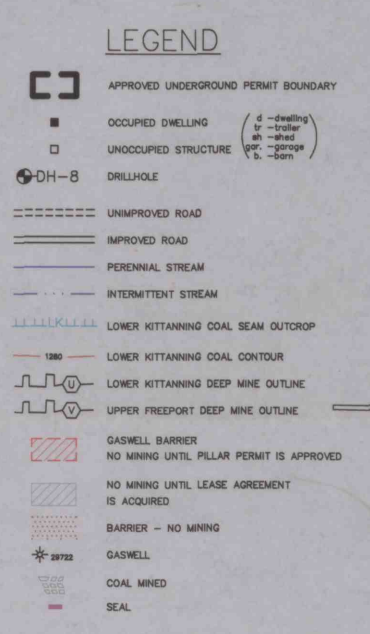

NOTES:
 1. SURFACE FEATURES DEPICTED HEREON ARE FROM USGS 7.5-MINUTE QUADRANGLES AS WELL AS FROM LOCAL SURVEY.
 2. MAPPING COORDINATE SYSTEM IS A LOCAL DATUM CONVERSION TO NORTH AMERICAN DATUM OF 1983 (NAD83) PENNSYLVANIA STATE PLANE SOUTH ZONE IS X = 15.16, Y = 6.37, Z = 2.43, R = 2.35.
 4. SURVEYED BY CLOSED LOOP METHOD, ACC. ± 1:5000 PRIOR TO FEBRUARY 21, 2014. THIS MEETS ACC. ± 1:10000.
 5. MAXIMUM ENTRY WIDTH IS 30 FEET.
 6. INTERVAL BETWEEN THE LOWER HITTING AND LOWER FREEPORT IS APPROXIMATELY 180 FEET. INTERVAL BETWEEN THE LOWER HITTING AND UPPER FREEPORT IS 180 FEET.
 7. THE LOCATION AND EXTENT OF ABANDONED MINE WORKINGS DEPICTED ON THIS MAP IS BASED ON THE AVAILABLE DATA. WITHOUT THE BENEFIT OF A FINAL CERTIFIED MINE MAP ACCORDINGLY, THE PROFESSIONAL ENGINEER SEALING THESE MAPS DOES NOT CERTIFY, WARRANT OR GUARANTEE THE PRECISE LOCATION OR EXTENT OF ABANDONED MINE WORKINGS DEPICTED HEREON.

MAP PREPARED BY:
Force
 Engineering Services, LLC
 1630 PHILADELPHIA STREET, INDIANA, PA 15701
 PHONE: (724) 901-8160 FAX: (724) 901-8888

DRAWN BY:
 NEG
 SCALE:
 1" = 400'
 DRAWING NO.
 1 OF 1

NAME _____ DATE _____
 COMPANY OR CORPORATE OFFICER

NAME _____ DATE _____
 INSPECTOR

0 400 800 1200
 SCALE: 1" = 400'

FINAL SEAL DATE: 04/17/2014
 FINAL SURVEY DATE: 08/28/12 3338 MILLER ROAD, HAMILTON, PA 15746

75.1204 FINAL MINE MAP
AMFIRE Mining Company, LLC
DORA 8 MINE
 CMAP 33871301 MSHA-DP 32-08704
 LOWER HITTING COAL SEAM
 NORTH MAHONING & PERRY TOWNSHIPS
 INDIANA & JEFFERSON COUNTY, PENNSYLVANIA

DATE
 05/06/2014