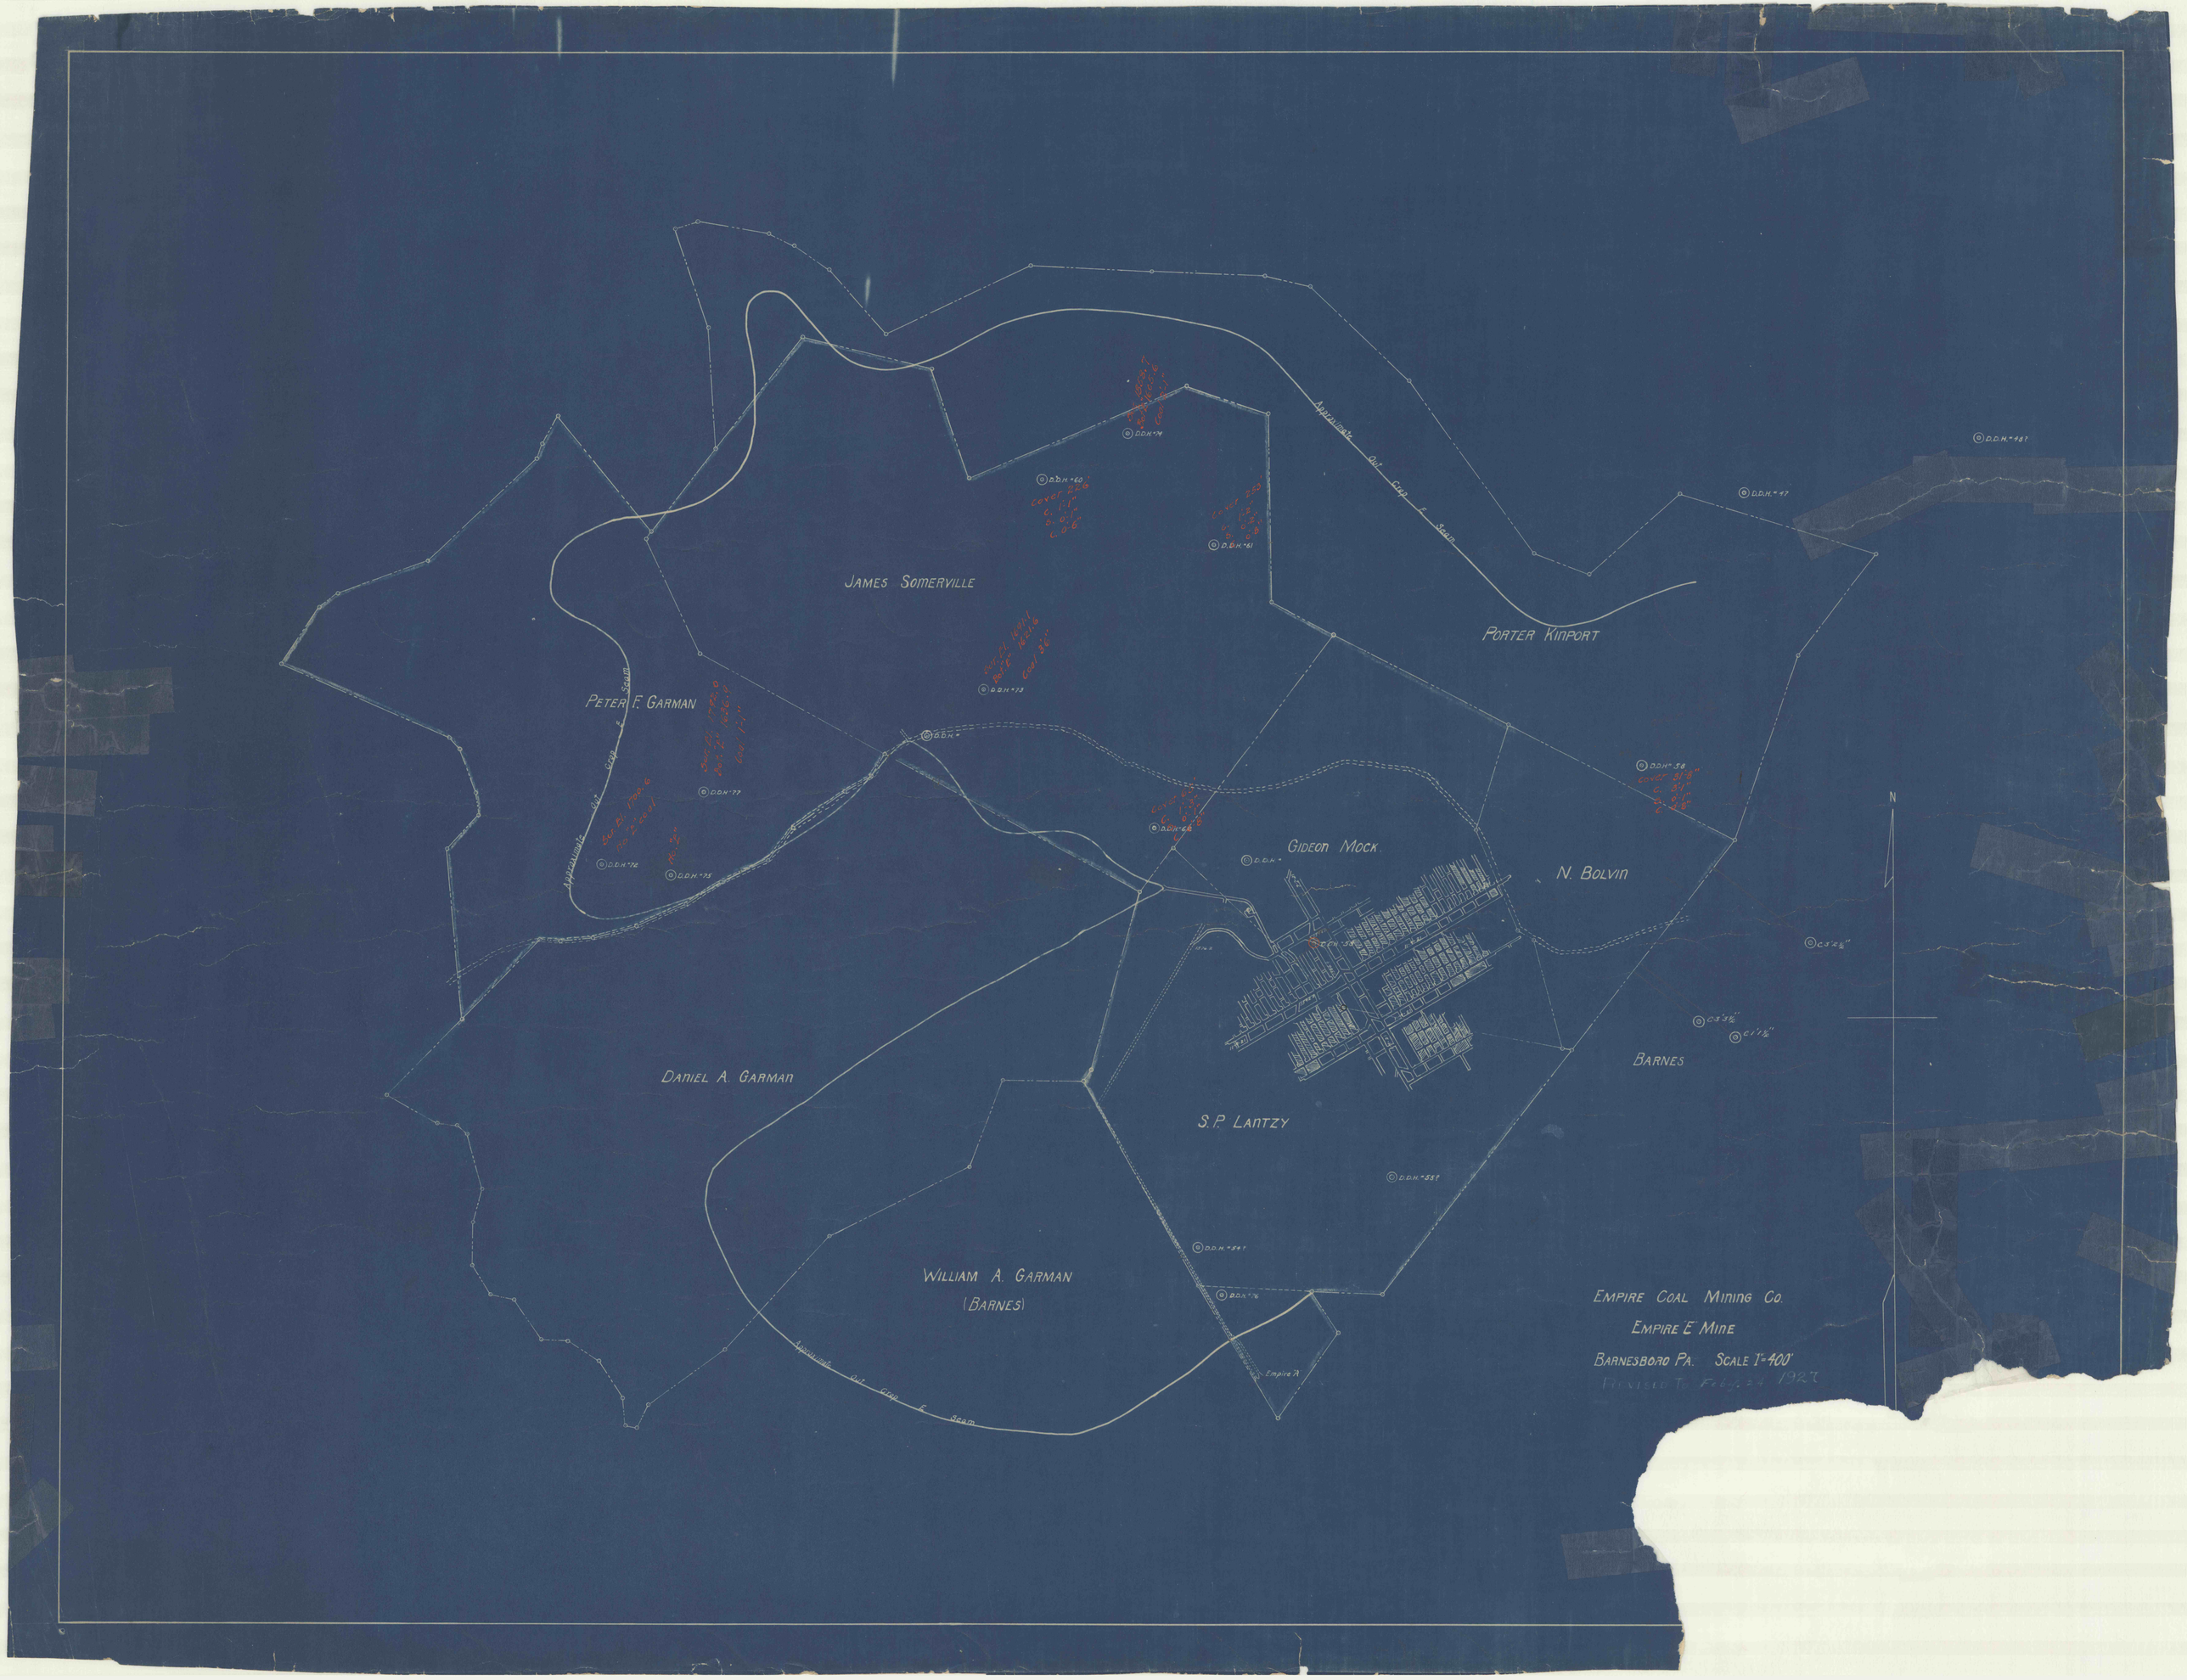

James Somerville
Porter Kinport
Peter F. Garman
Gideon Mock
N. Bolvin
Barnes
Daniel A. Garman
S.P. Lantzy
William A. Garman
(Barnes)
Empire Coal Mining Co.
Empire E Mine
Barnesboro Pa. Scale 1"=400'
Revised To Feby. 24 1927
N