

#959
7-16-99
C.C.


POWELL
HARRISON-WALKER BRICK PLANT
RUN

Harrison-Walker
Coal & Clay Mine

J.L. BANFIELD RES. ENG.

MAP
SHOWING WORKINGS OF B. SEAM
OF
FRANK & McARTNEY COAL CO.
BLANDURG, READE TWP, CAMBRIA CO., PA.
SCALE - 1" = 400'

OPERATED UNDER NAME OF :-
F & K COAL COMPANY
F & K MINE

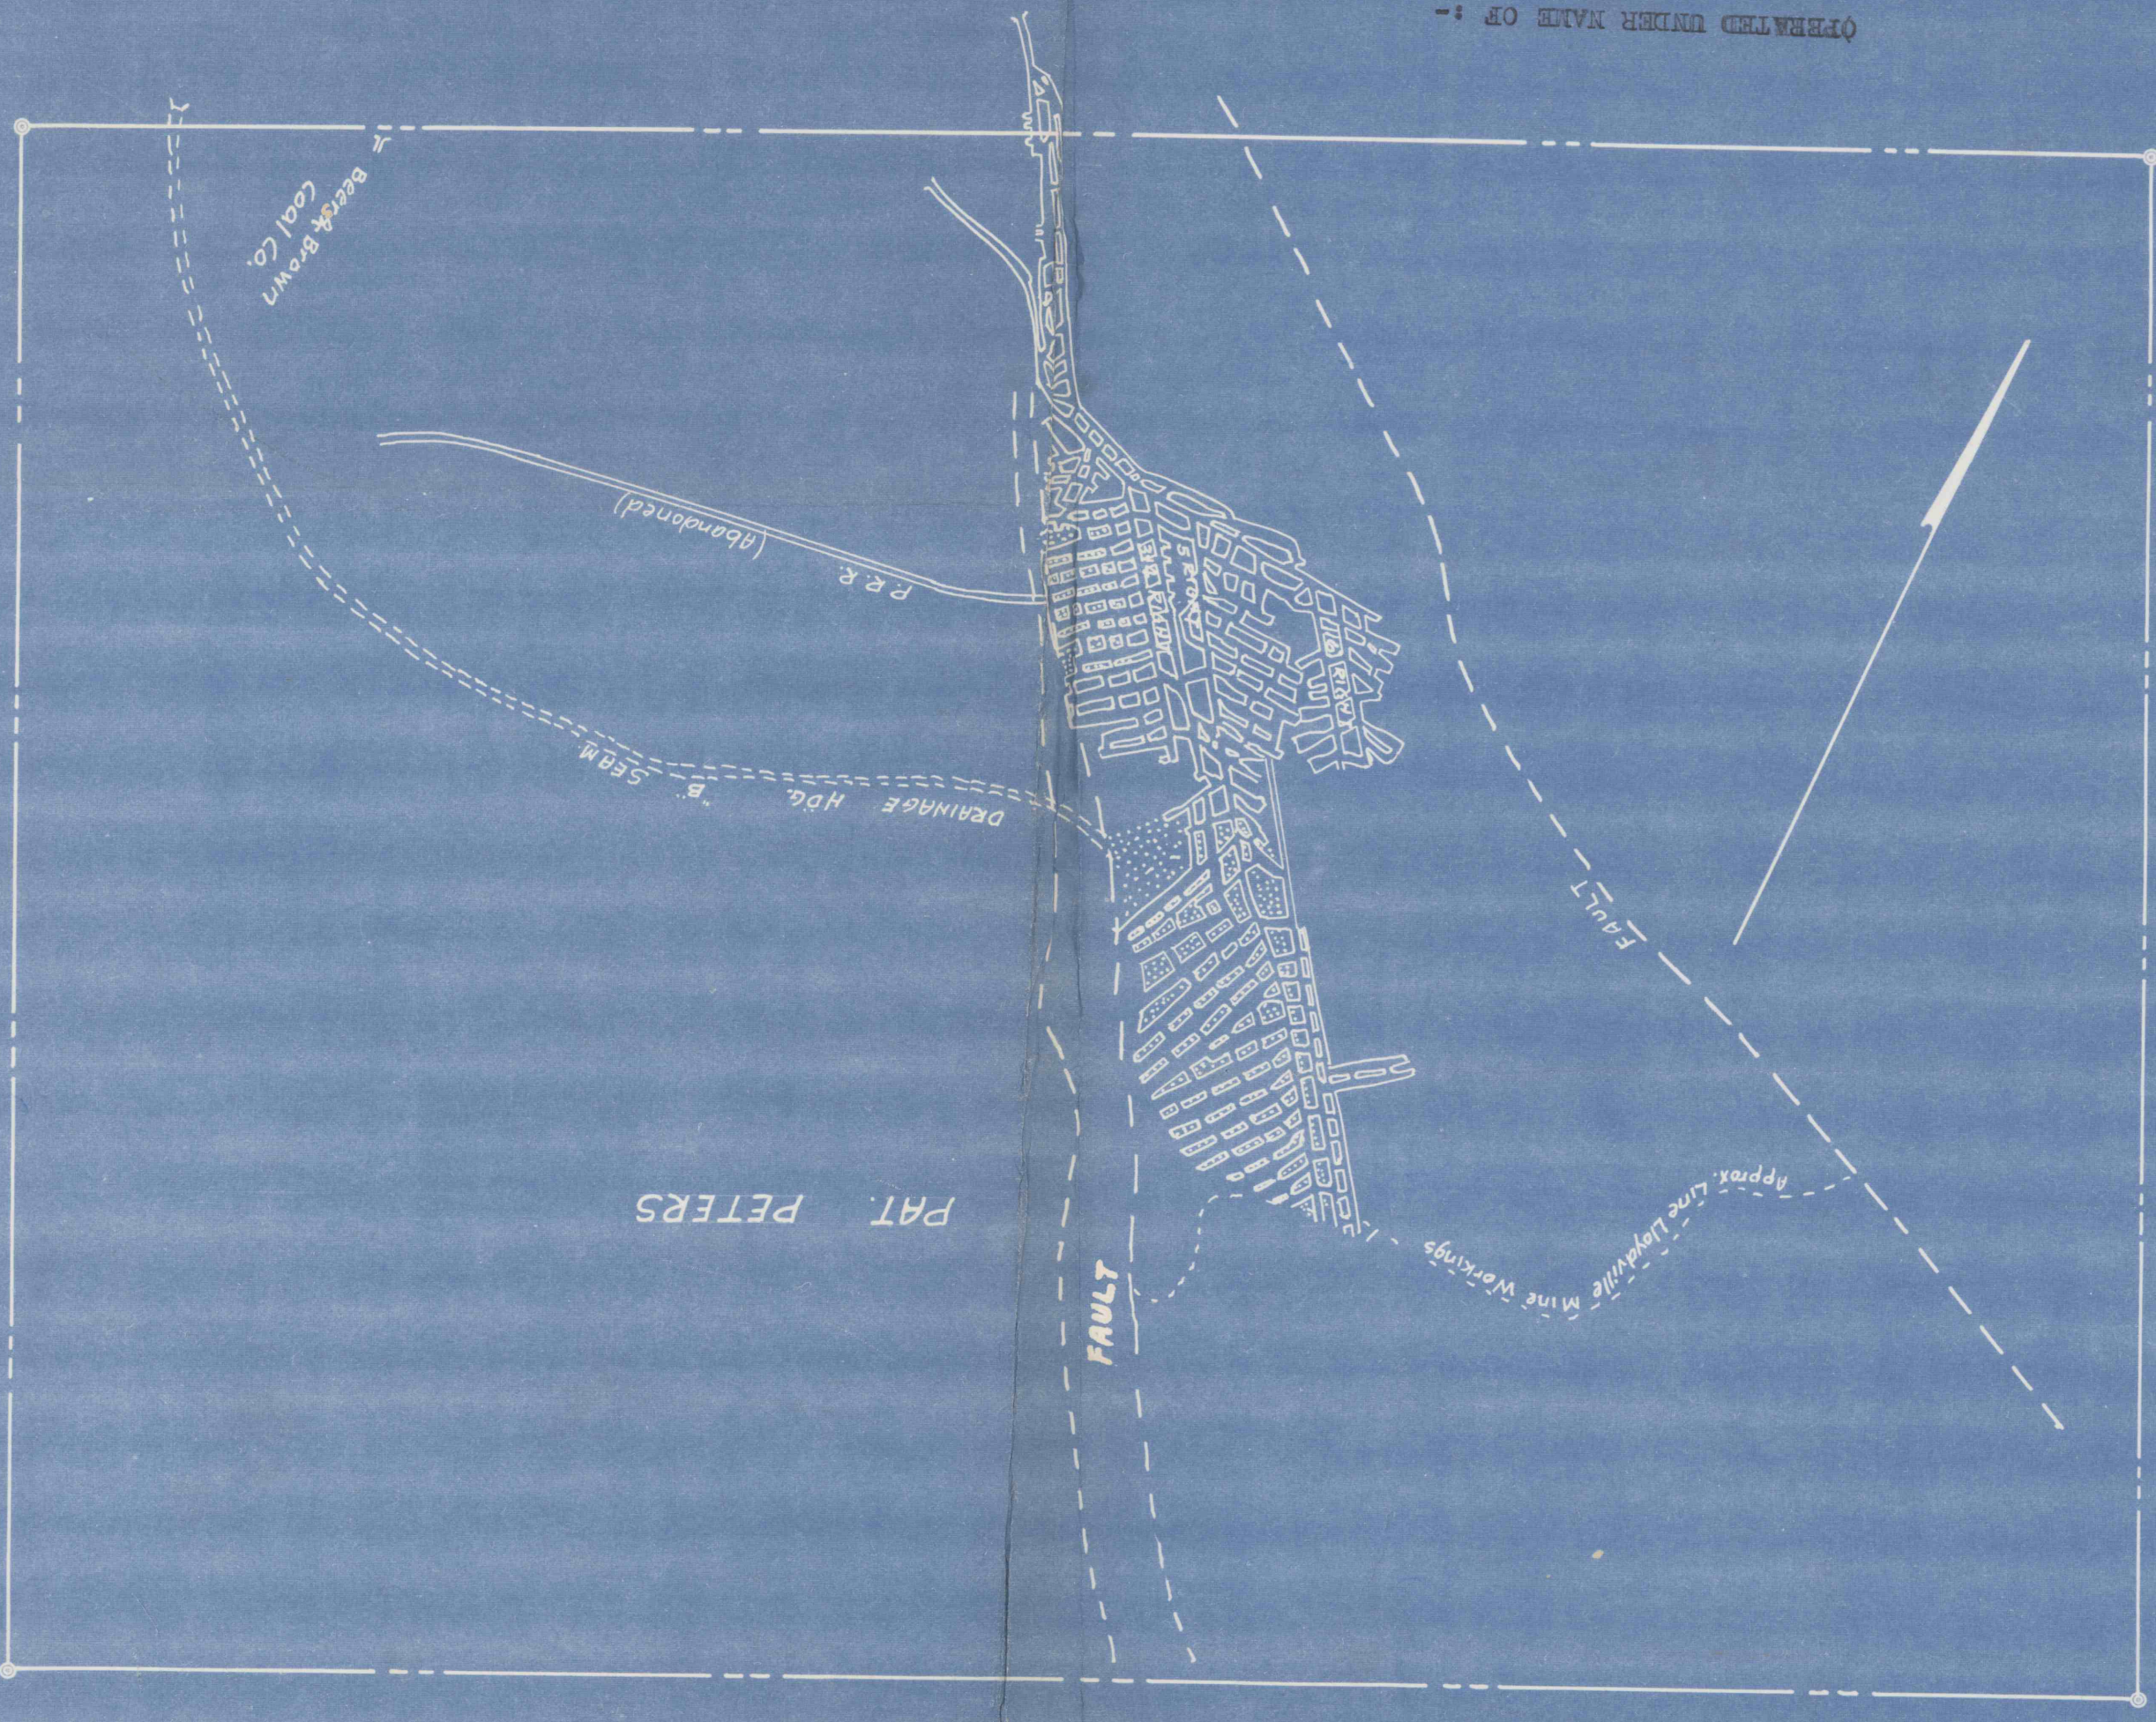

PAT. BORELAND

PAT. PETERS

MARTIN WOLF

MARTIN BLACK