#1045
7-20-99
CC

HOSTETTER MINE

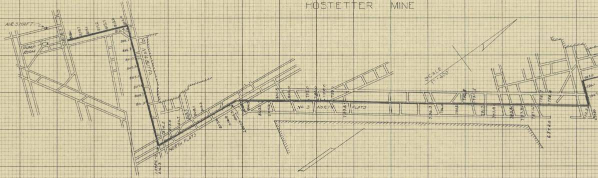
AIR SHAFT
PUMP ROOM
4 BUTTS
NORTH FLATS
No 3 NORTH FLATS
SCALE 1"=400'
19+84
816.3
63+20

PLAN

PUMP ROOM

EL. FLOOR 822.4

EL. BOT. SUMP 810.3

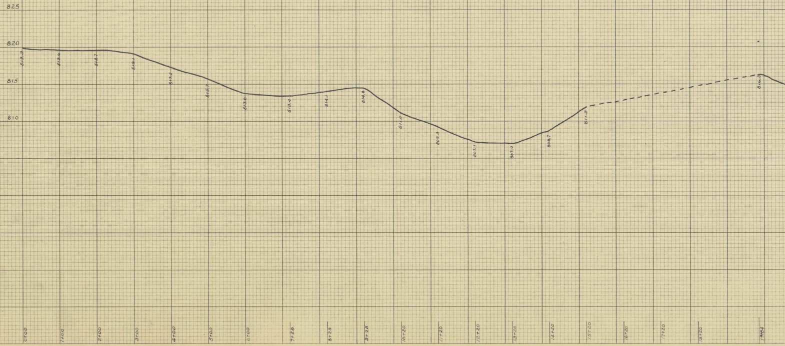

"Precise" CROSS SECTION 10 X 10 TO 1"
B.K. ELLIOTT CO.
MADE IN U.S.A.

"Precise" CROSS SECTION 10 X 10 TO 1"
B.K. ELLIOTT CO.
MADE IN U.S.A.

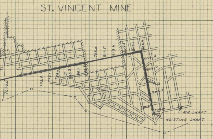
ST. VINCENT MINE
72+60
792.5
792.1
794.5
795.5
796.7
798.6
801.5
803.6
805.5
807.3
806.6
798.9
AIR SHAFT
HOISTING SHAFT

# PROFILE OF COAL SEAM
FROM
HOSTETTER AIR SHAFT TO ST. VINCENT SHAFT

SCALE {HOR. 1" = 100'
VER. 1" = 5'

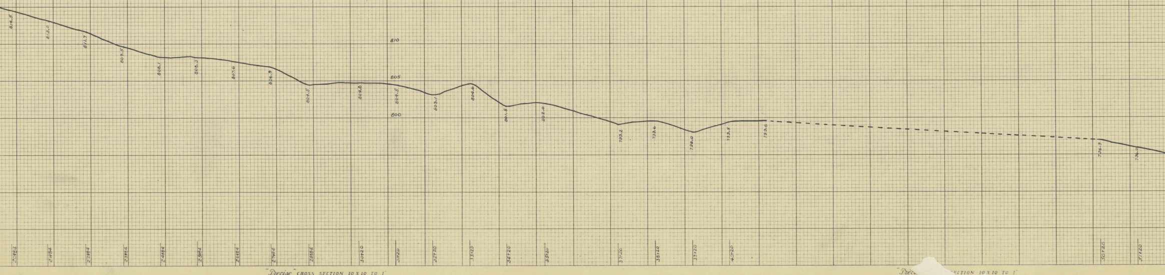
814.5
813.0
811.7
809.5
808.1
808.3
807.6
806.9
804.5
804.8
804.5
803.1
804.6
801.5
802.0
799.2
799.6
798.0
799.5
799.6
796.9
796.0
810
805
800
20+84
21+84
22+84
23+84
24+84
25+84
26+84
27+84
28+84
30+20
31+20
32+20
33+20
34+20
35+20
37+20
38+20
39+20
40+20
50+20
51+20

"Precise" CROSS SECTION 10 X 10 TO 1"
B. K. ELLIOTT CO.
MADE IN U.S.A.

"Preci
SECTION 10 X 10 TO 1"

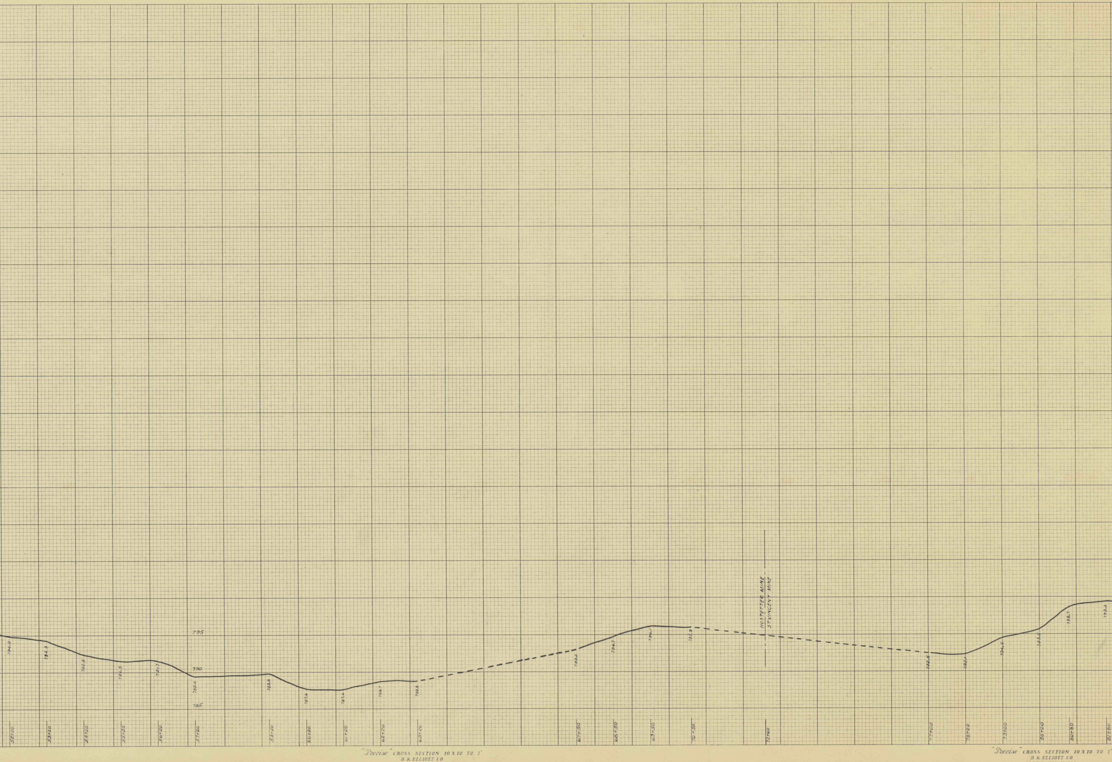

"Precise" CROSS SECTION 10 X 10 TO 1"
B K ELLIOTT CO
MADE IN U.S.A.

"Precise" CROSS SECTION 10 X 10 TO 1"
B K ELLIOTT CO
MADE IN U.S.A.

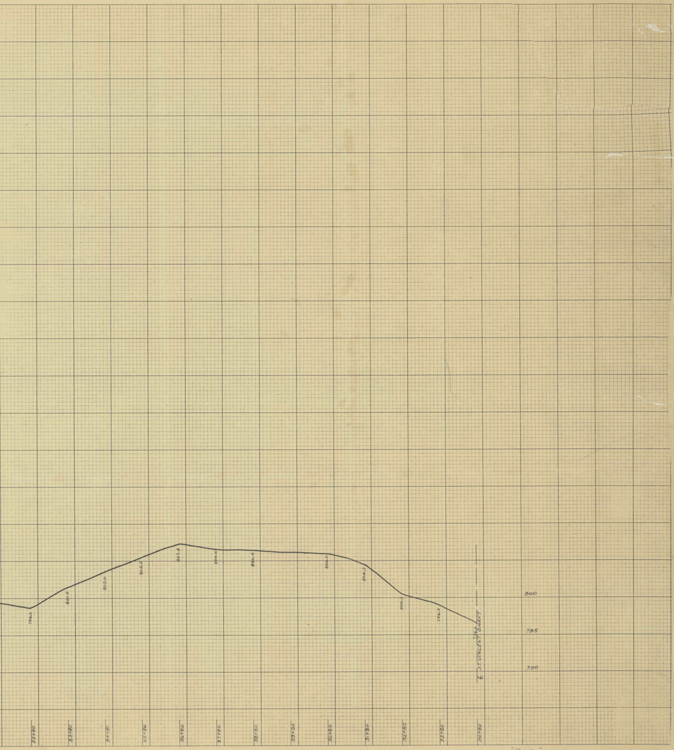

"Precise" CROSS SECTION 10 X 10 TO 1"
B K ELLIOTT CO
MADE IN U.S.A