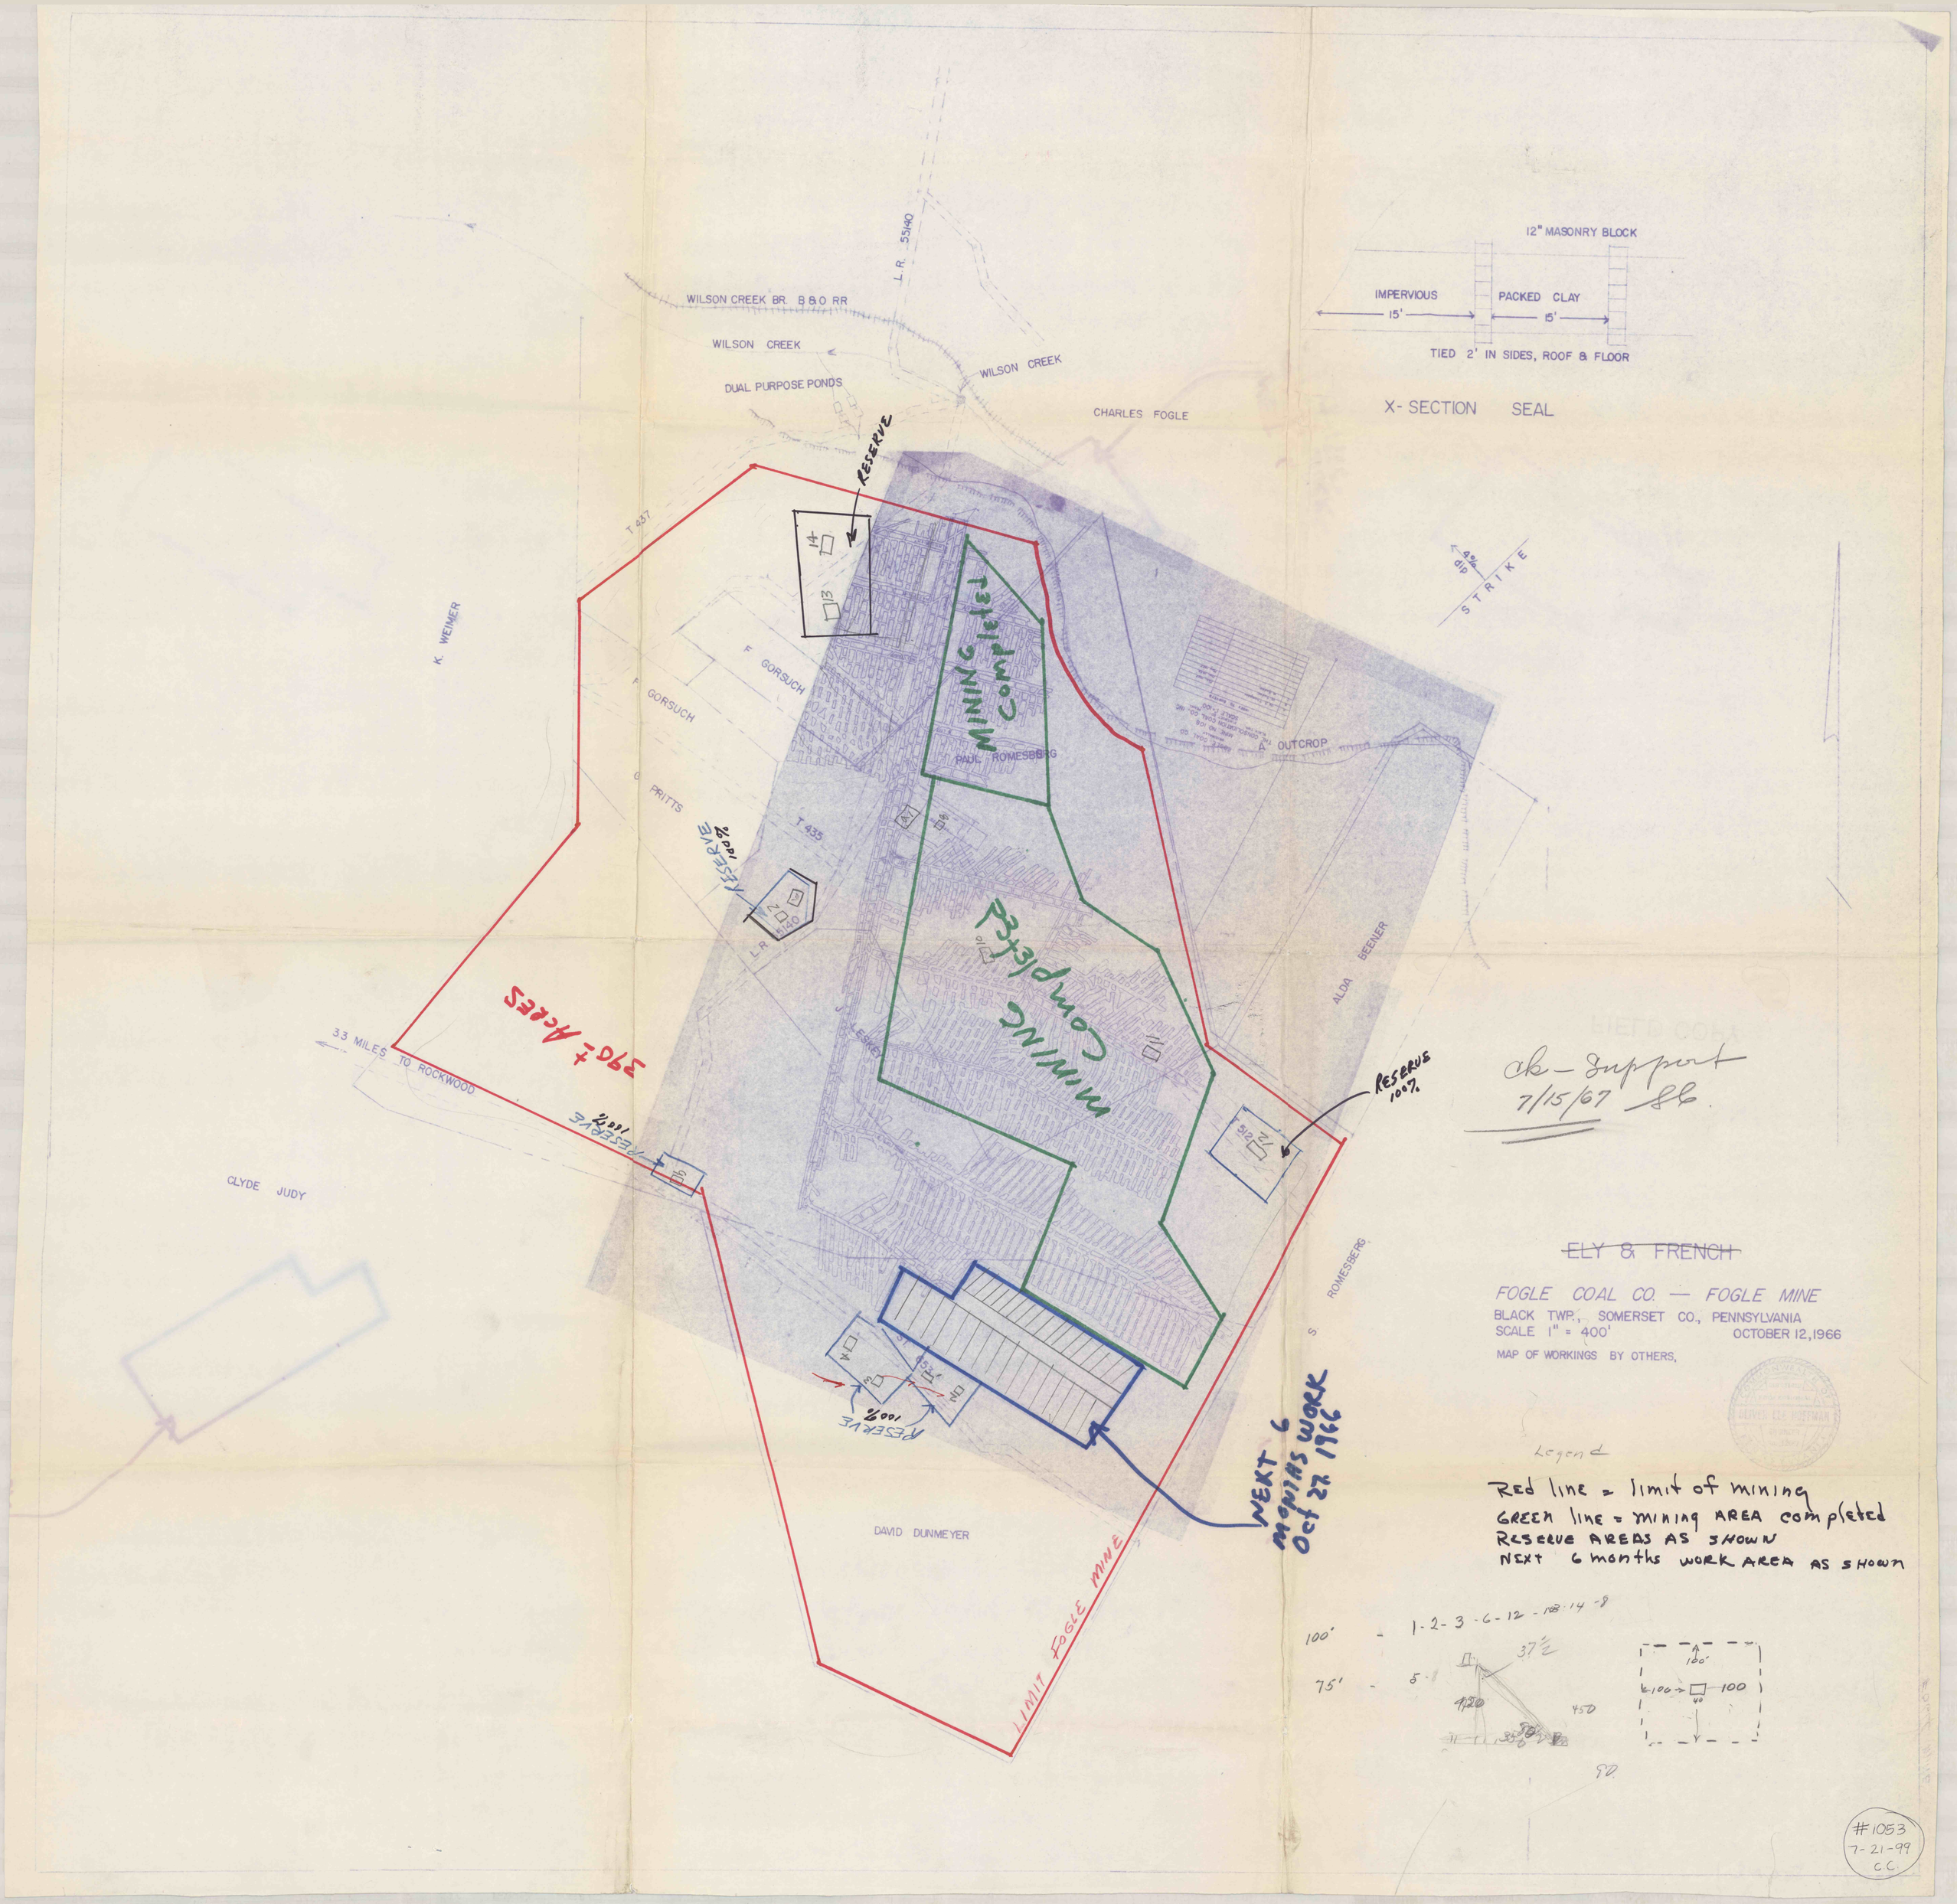

Ck - Support
7/15/67 SC

~~ELY & FRENCH~~

FOGLE COAL CO. — FOGLE MINE
BLACK TWP., SOMERSET CO., PENNSYLVANIA
SCALE 1" = 400' OCTOBER 12, 1966
MAP OF WORKINGS BY OTHERS,

Legend

Red line = limit of mining
GREEN line = mining AREA completed
RESERVE AREAS AS SHOWN
NEXT 6 months WORK AREA AS SHOWN

100' - 1-2-3-6-12-13-14-8
75' - 5-8

#1053
7-21-99
C.C.