




Henry W. Rau

Victor B. Fuller

To Route 422

■ Coal Area
■ Mined out - mining Completed
 No Dwellings
 Date Mar. 28, 1967

Andrew Papsiak

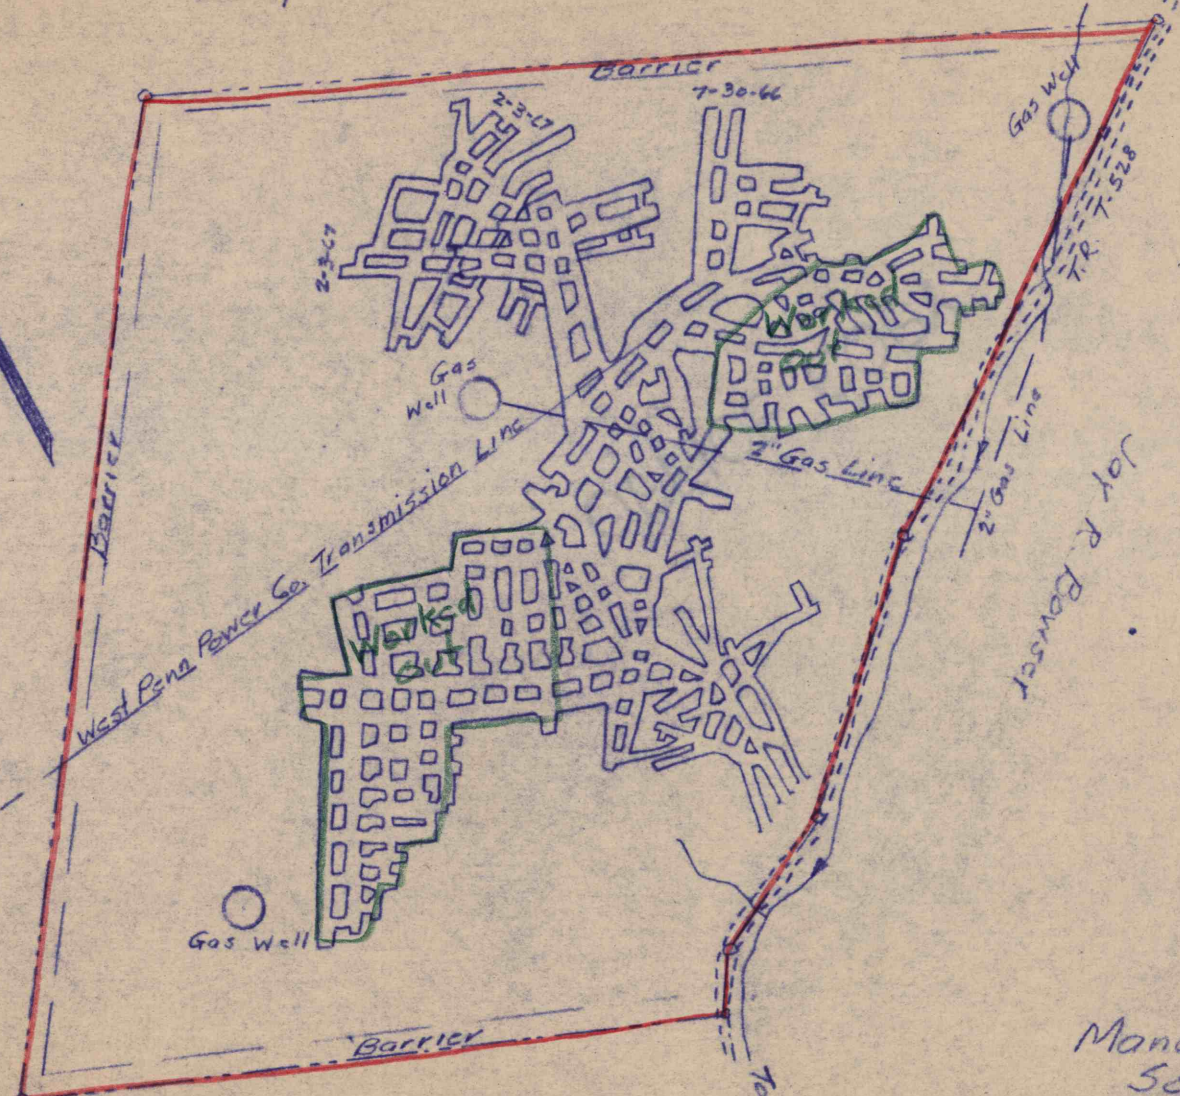

Gas Well

Gas Well

Jay R. Bowser

Wilbur Bowser

To Garrett Run

Cherry Run Fuel Co.
 Garrets Run Mine
 Manor Twp, Armstrong Co., Pa
 Scale 1"=400' Oct. 4, 1966
 Graff Engineering Co.
 Blairsville, Pa.