


FIT TO SHEET No 1

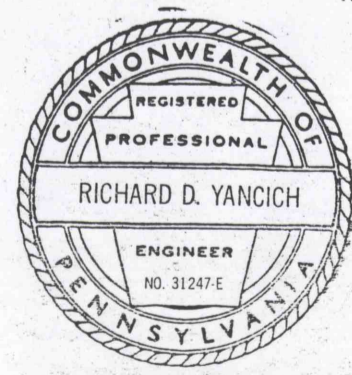

*Richard D. Yancich*  
7-23-90  
GATEWAY COAL COMPANY  
GATEWAY MINE  
1" = 400' **FINAL MAP**  
**SHEET No 2 A**