


SHEET No. 4

Final Map
GATEWAY MINE
GATEWAY COAL COMPANY
1" = 400' - SHEET No. 4



AMENDED PERMIT BOUNDARY

GEORGE W. HUFEMAN

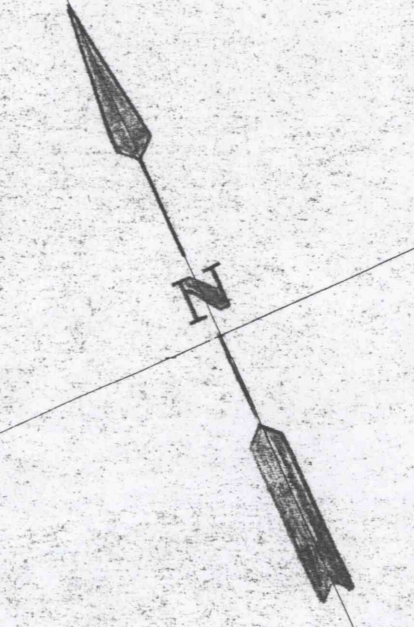

FIT TO SHEET No. 6

FIT TO SHEET No. 5

SHEET No. 4

