


FINAL MAP  
1" = 400' SHEET No 5  
GATEWAY MINE  
GATEWAY COAL COMPANY

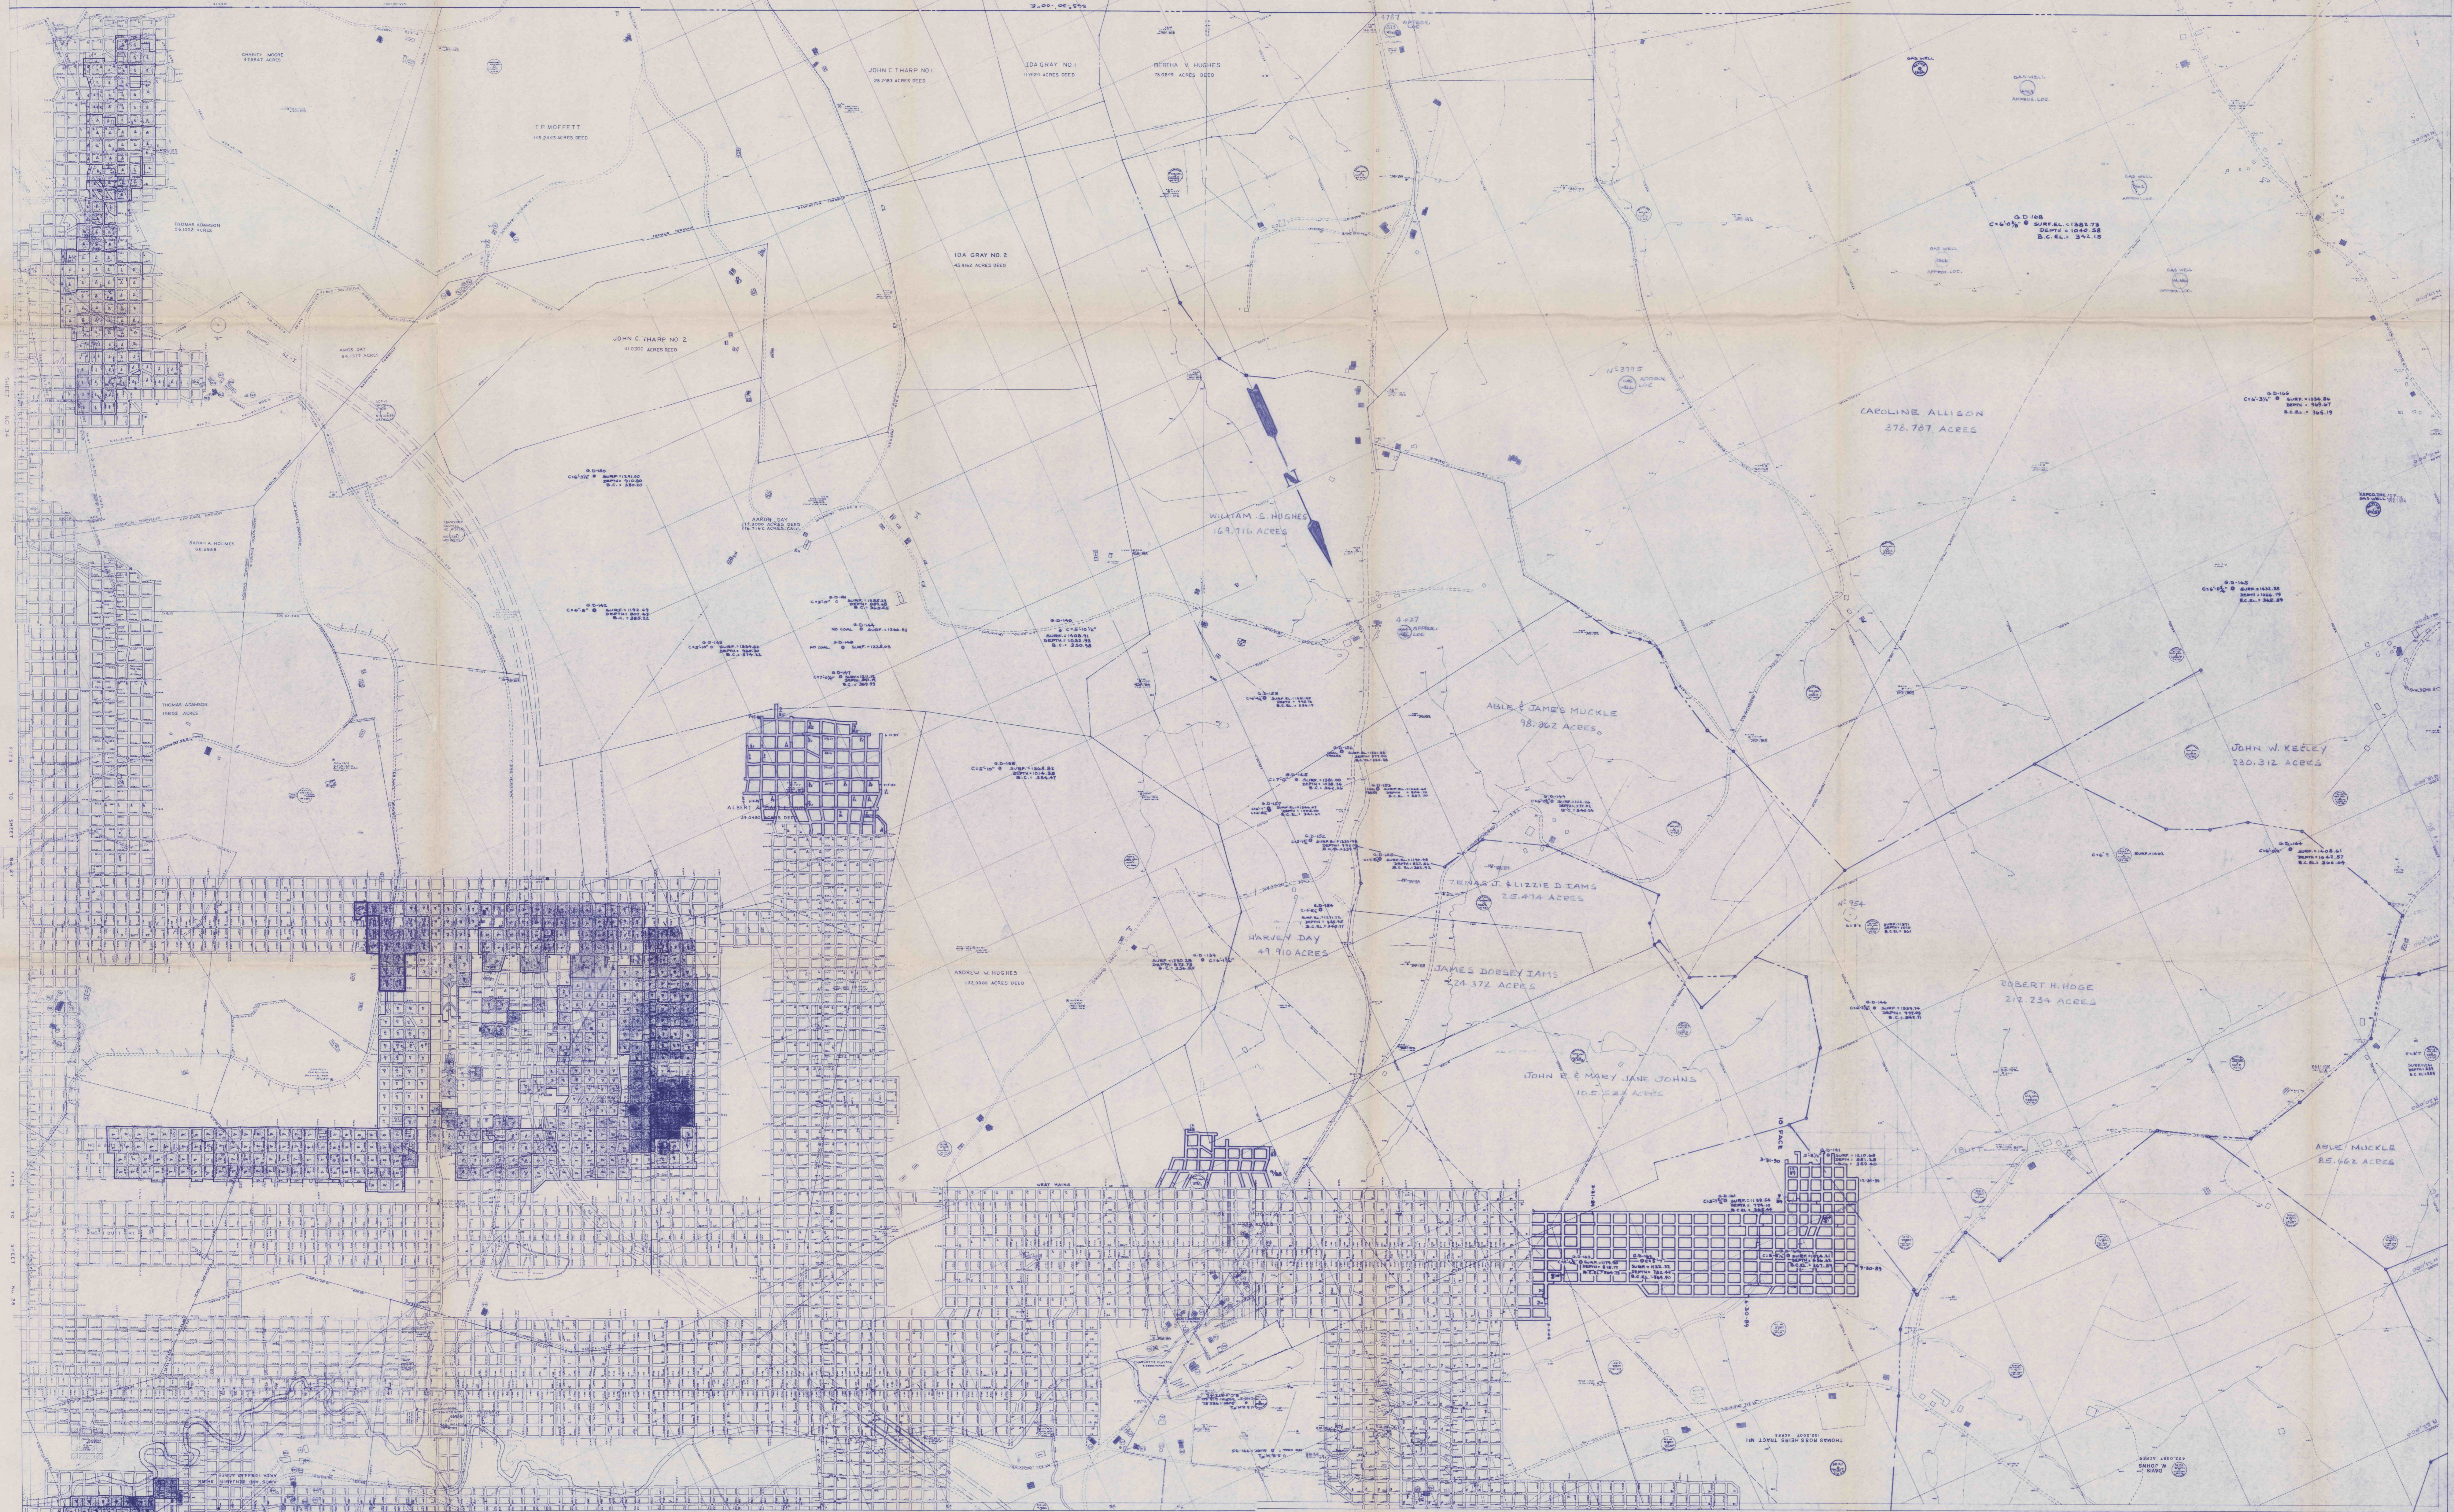

RECEIVED  
JUL 3 1990  



FIT TO SHEET No 3

FIT TO SHEET No 7

FIT TO SHEET No 4

FIT TO SHEET No 5