


To -  
GATEWAY  
July 16, 1985

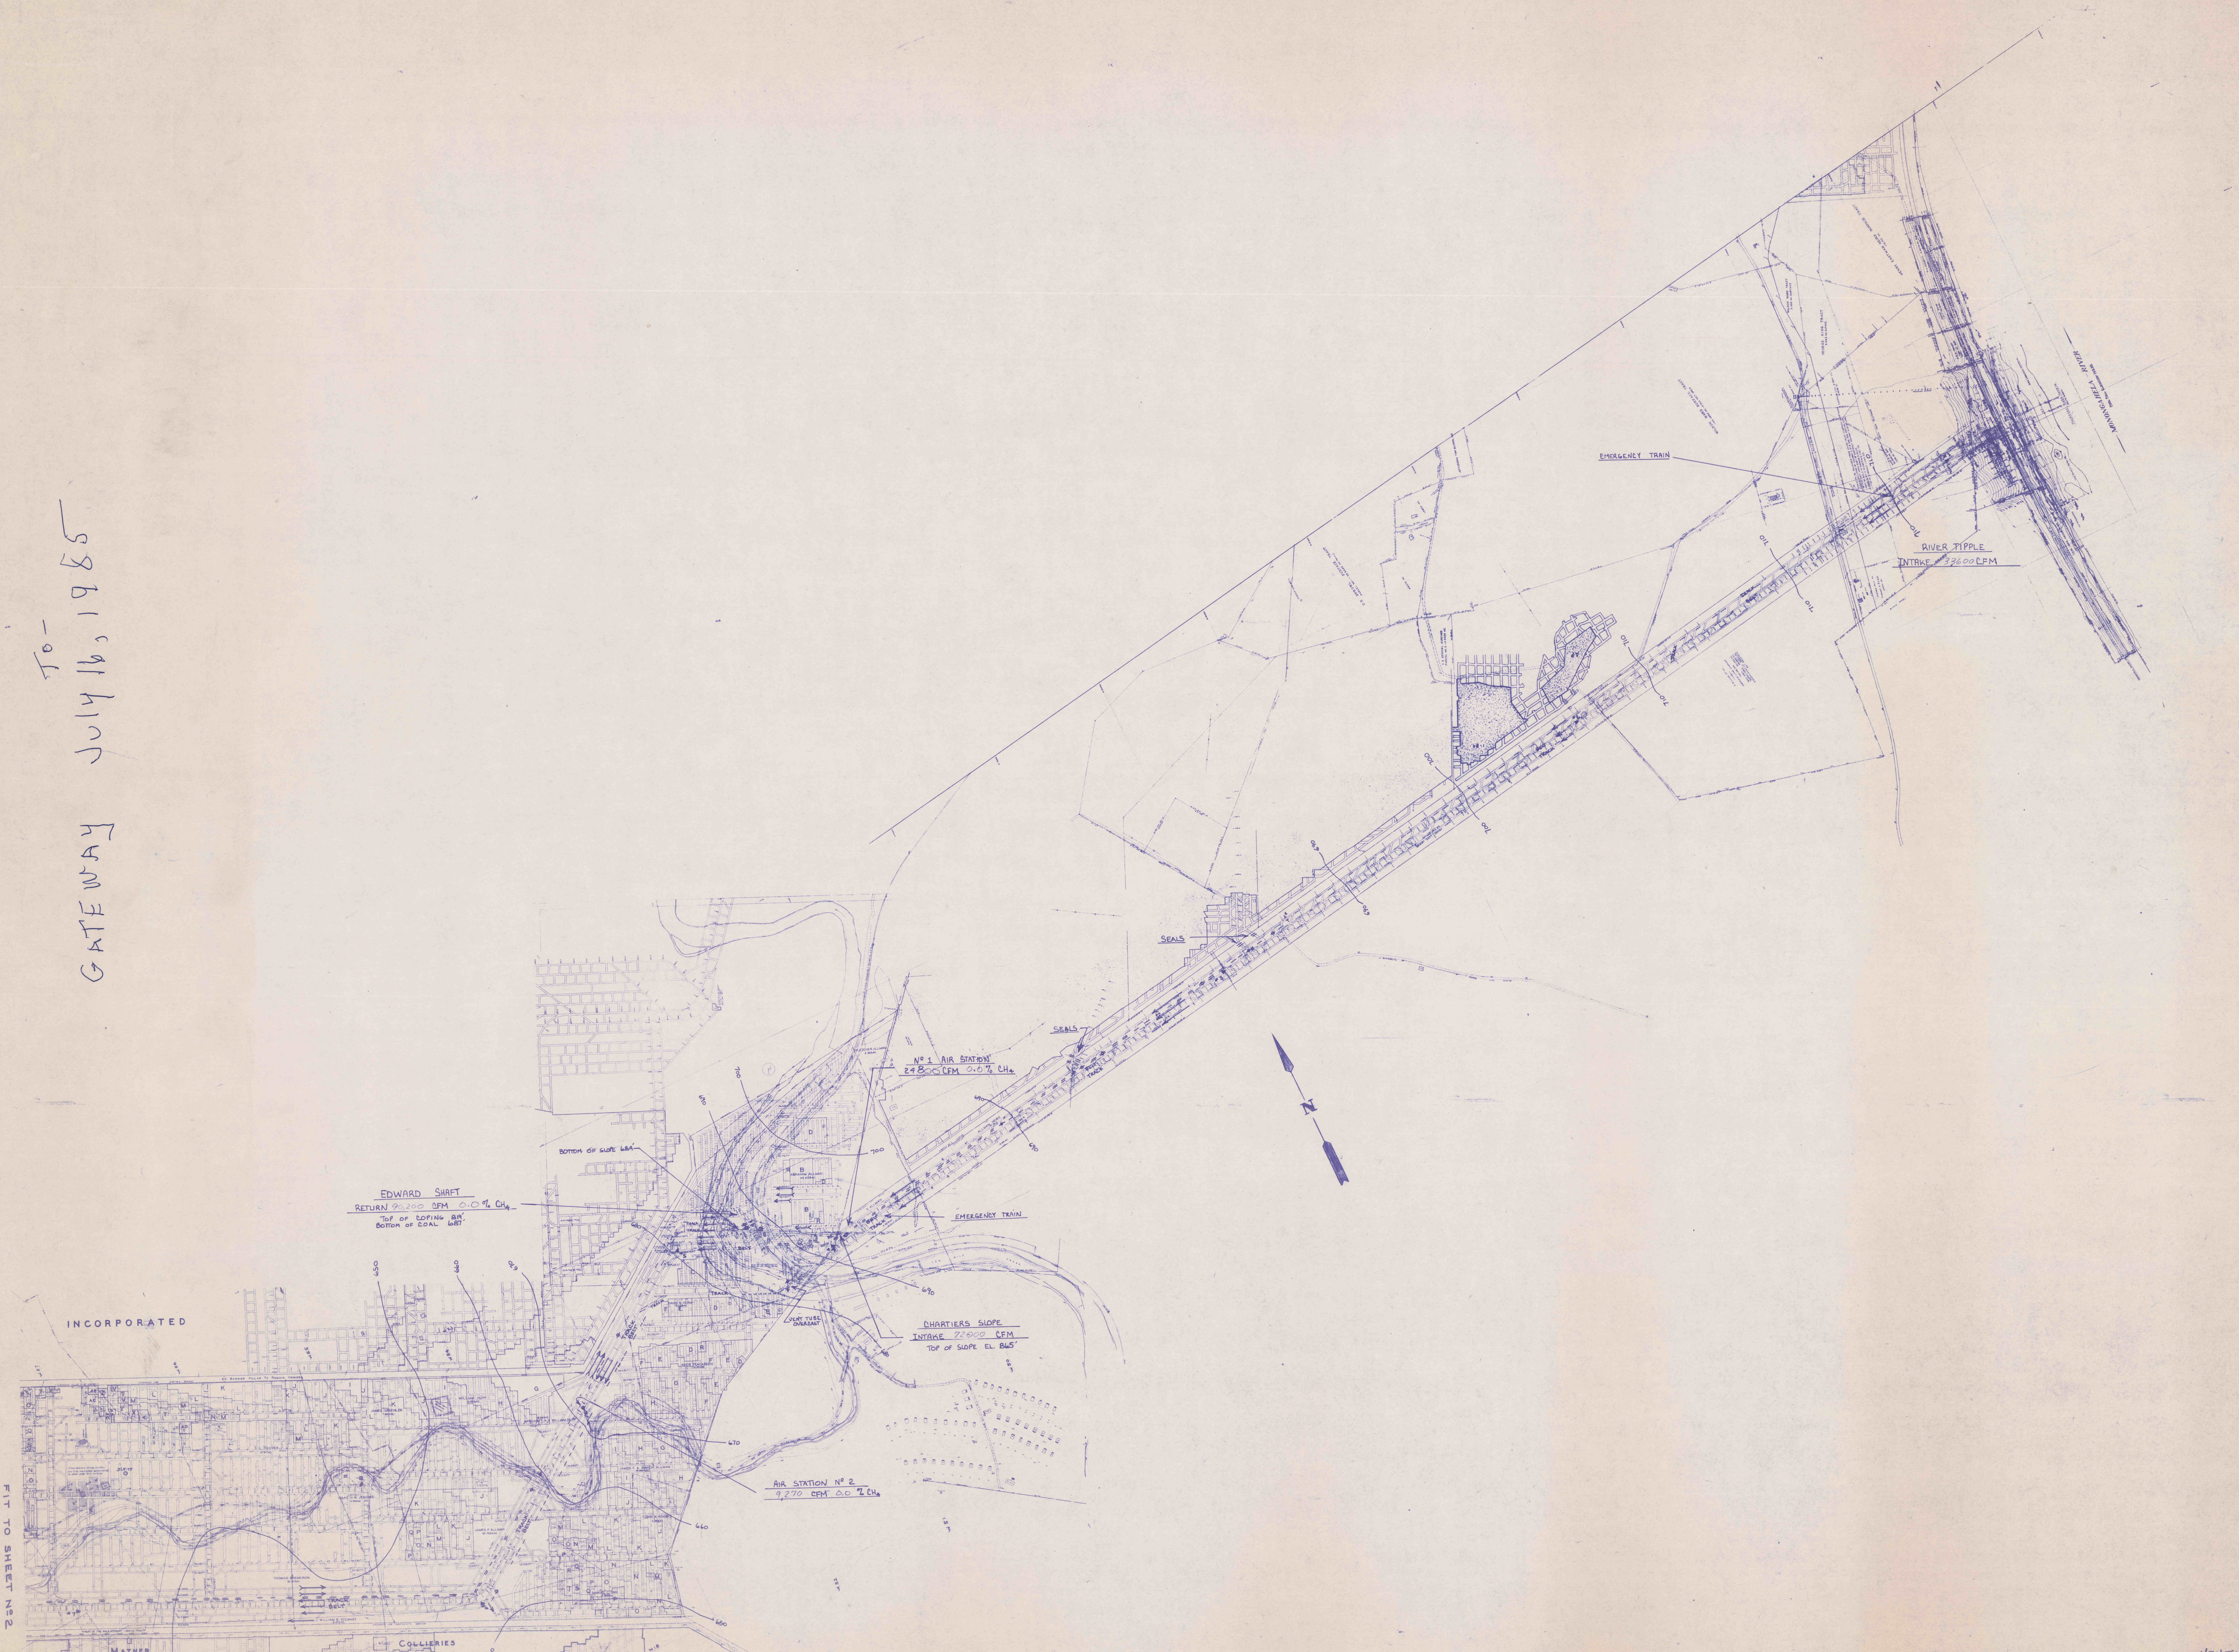

INCORPORATED

Fit to SHEET No 2