


LEASEHOLD OF THE PENNA. COAL & COKE GROUP

LEASEHOLD OF THE PENNA. COAL & COKE GROUP

FITTING COAL & COKE CO.

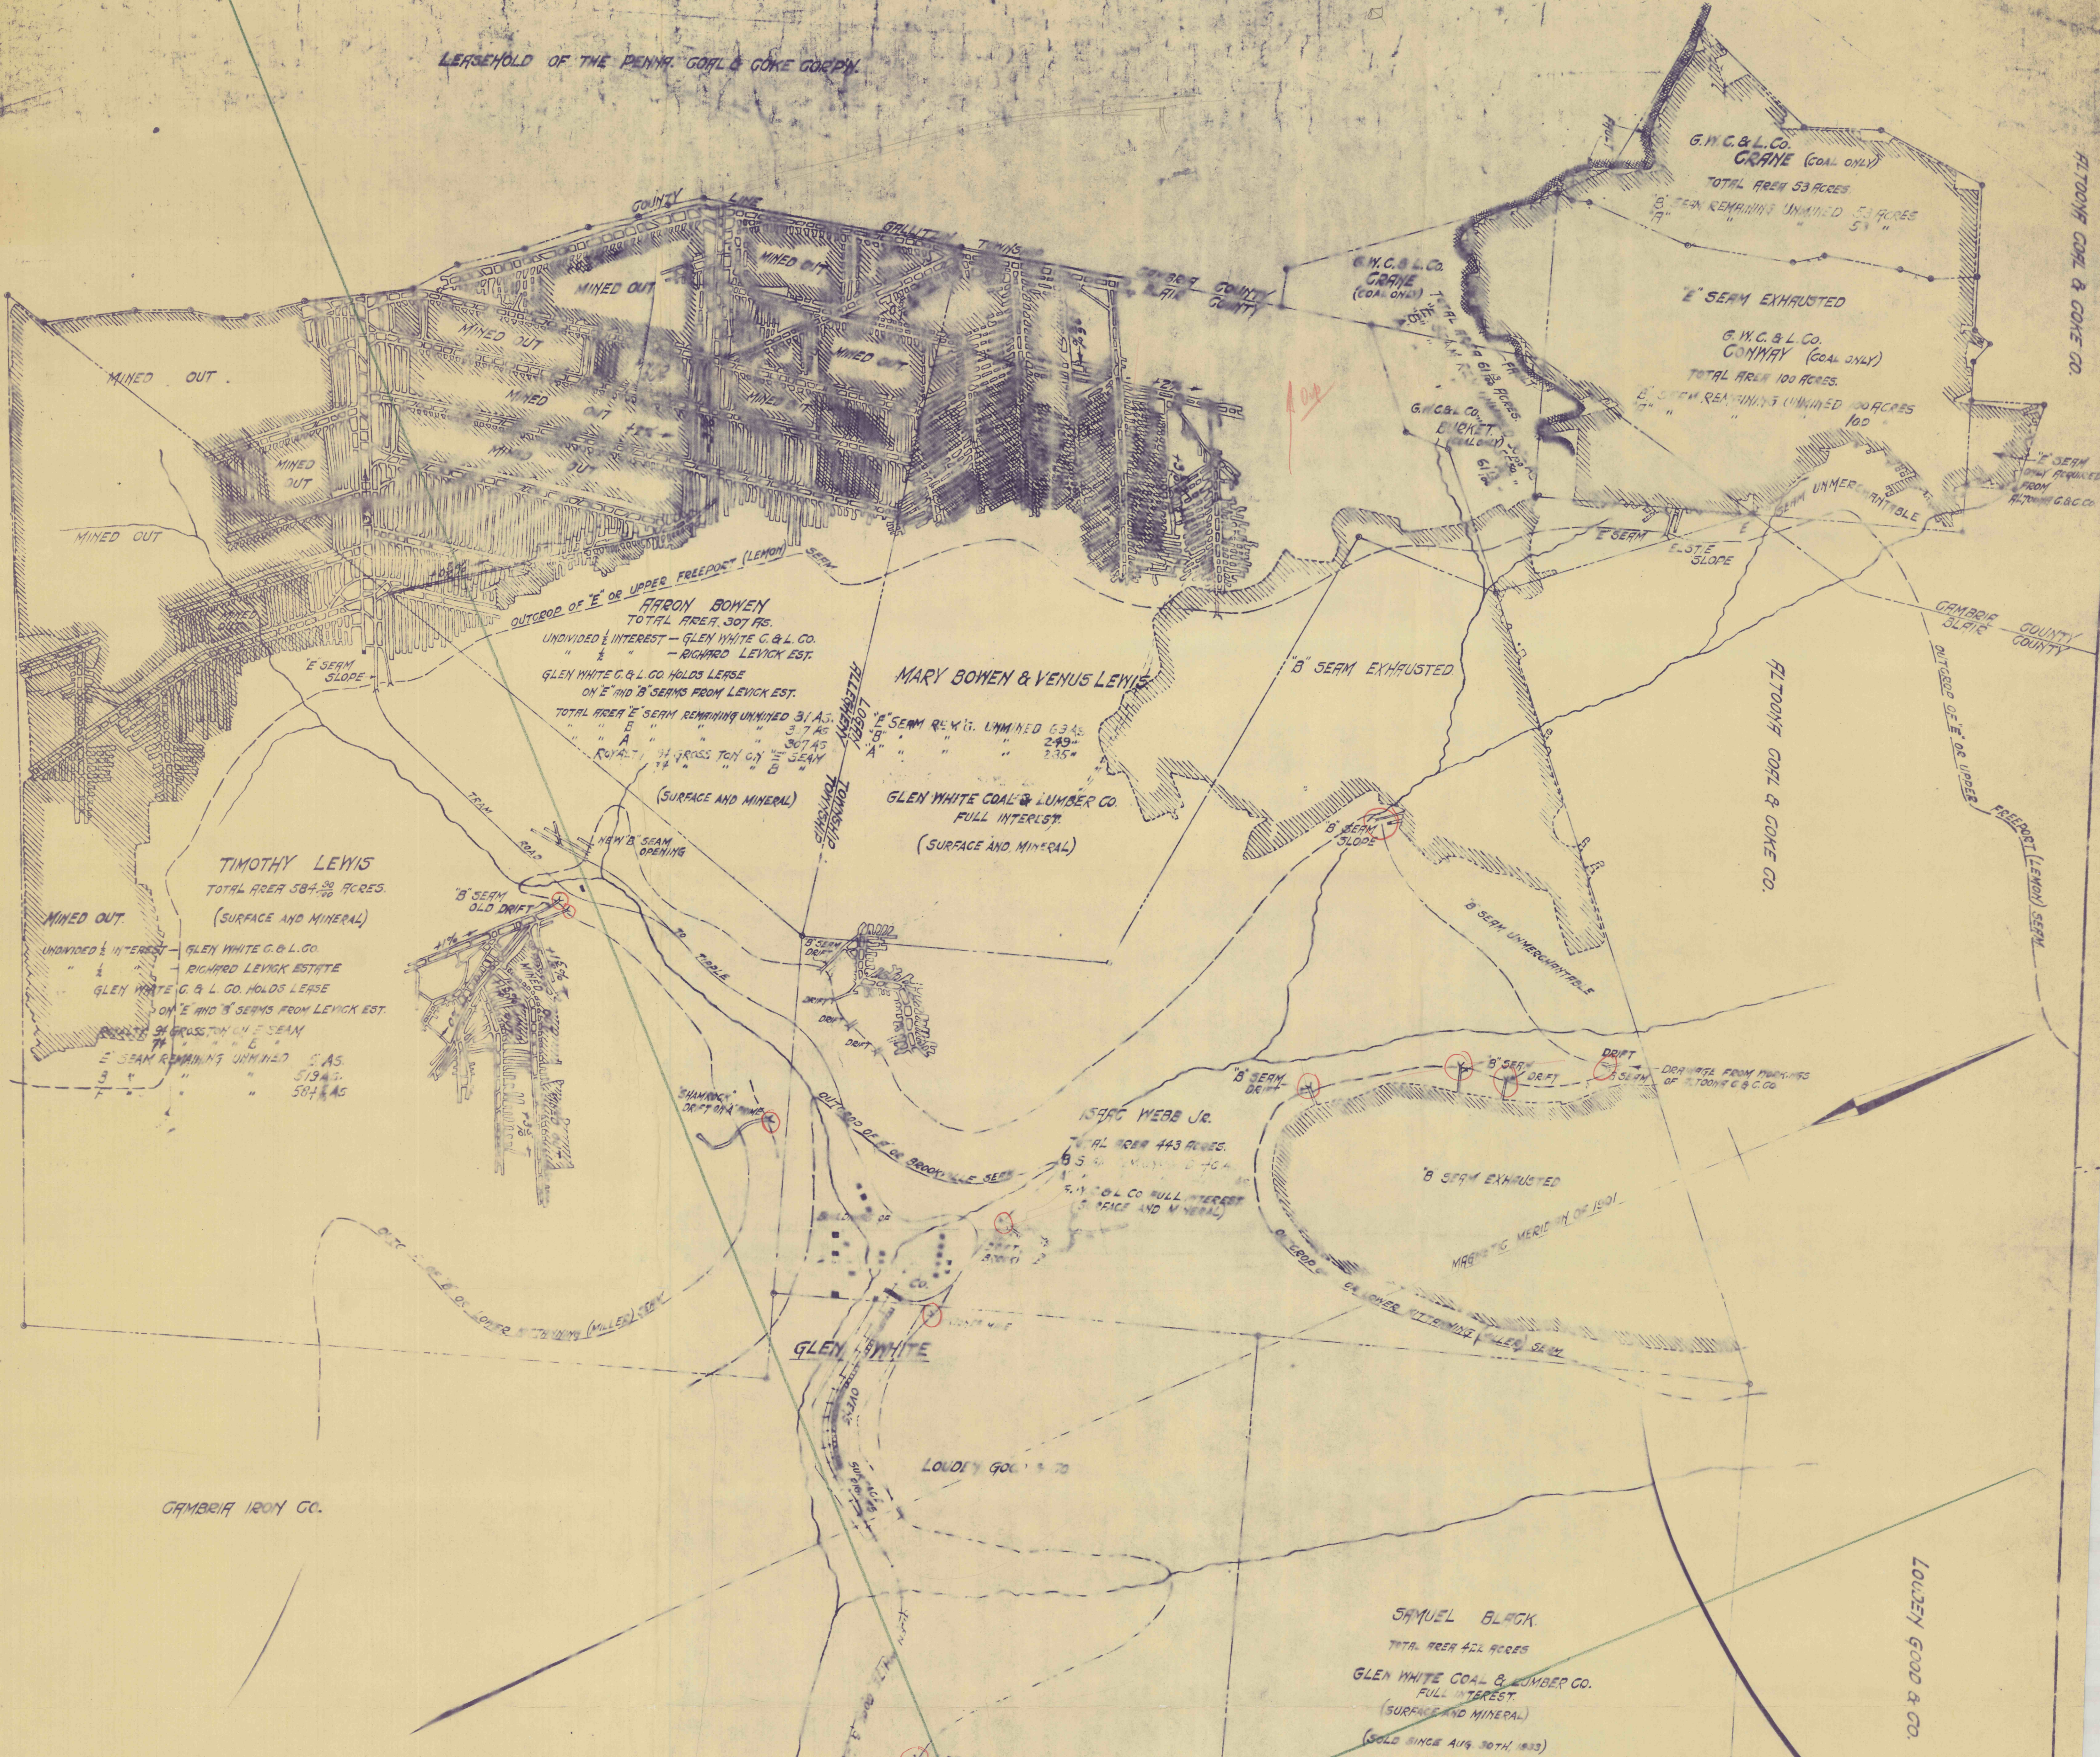

MAP SHOWING COAL LANDS

AND MINE WORKINGS

OF THE

GLEN WHITE COAL AND LUMBER CO.


SCALE: 1"=400'

REVISED AUG. 30TH, 1931
APRIL 25TH, 1928
MAY 30TH, 1928

J.S. LYMAN JR.
ENGINEER
PITTSBURGH, PA.

AVERAGE THICKNESS 'E' SEAM 4'-0"
" " " " 'B' " 2'-0"
" " " " 'A' " 3'-0" TO 3'-6"