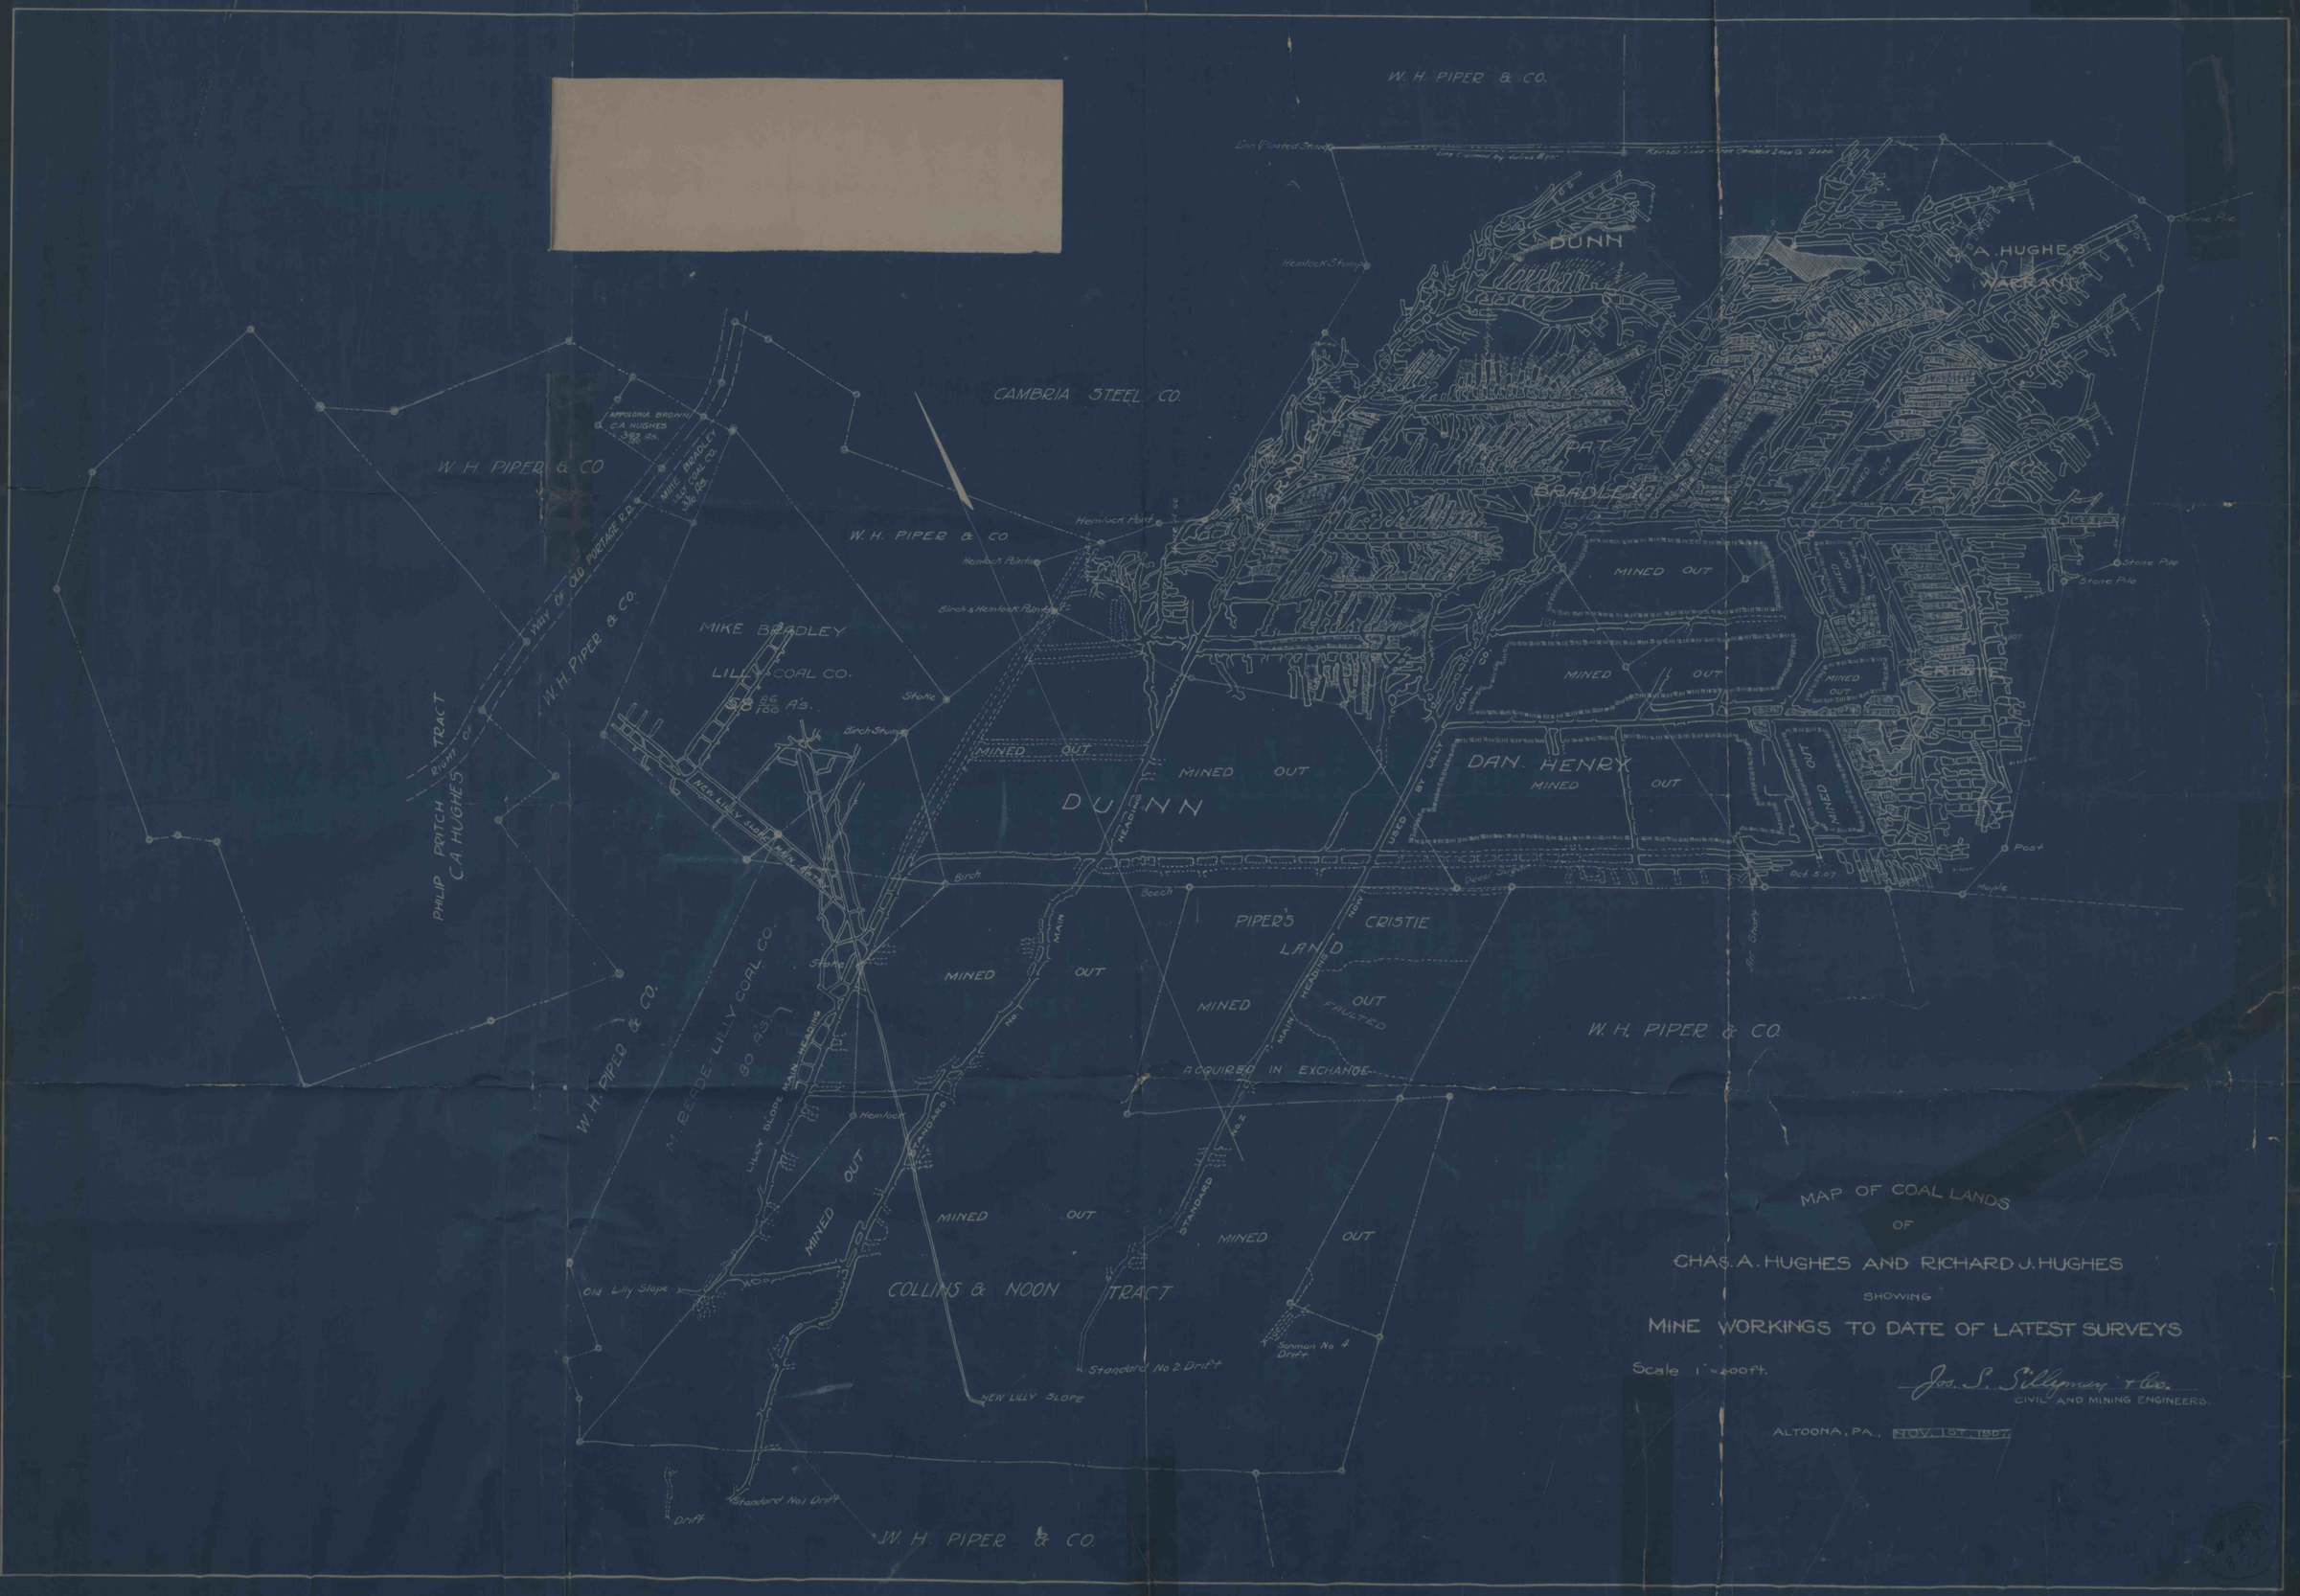

MAP OF COAL LANDS
OF
CHAS. A. HUGHES AND RICHARD J. HUGHES
SHOWING
MINE WORKINGS TO DATE OF LATEST SURVEYS

Scale 1" = 400 ft.

Jos. S. Sillyman & Co.
CIVIL AND MINING ENGINEERS.

ALTOONA, PA., NOV. 1ST, 1907.