

HAULAGE WAY Red

WORK AREAS Black

AIR FLOW GREEN

WATER Blue

NO. 9 MAIN
NO. 10 MAIN
NO. 11 LINE
NO. 12 MAIN
NO. 12 LINE

16" BORE HOLE

WATER

AIR BORE HOLE

06" AIR SHAFT
10 1/2" AIR SHAFT


LINE RIGHT
BUTT RIGHT
LINE RIGHT

W

W

BORE HOLE

12 LINE RIGHT
11 BUTT RIGHT
11 LINE RIGHT

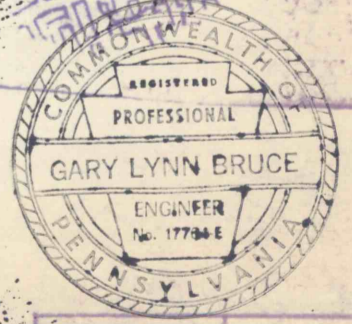

REVISION DATES

JAN. 1, 1976	MAR. 16, 1977
JAN. 1, 1977	FEB. 28, 1978
JAN. 1, 1978	MAY 8, 1979
JAN. 1, 1980	NOV. 11, 1981
JAN. 1, 1981	JAN. 1, 1982
DEC. 2, 1982	JAN. 1, 1983
JULY 1, 1983	

Gary L. Bruce P.E.
71183



BRADYS BEND CORPORATION
UNDERGROUND STORAGE

FORMERLY
MICHIGAN LIMESTONE DIVISION
UNITED STATES STEEL CORP.
DETROIT, MICHIGAN
KAYLOR MINE
ARMSTRONG COUNTY, PENNSYLVANIA
SCALE 1" = 400'
MARCH 1949
REV. JAN. 1, 1960