


MAP OF
**KEYSTONE SHAFT & SEWICKLEY
 ARONA AND MADISON MINES**


OF THE
KEYSTONE COAL & COKE CO.

SITUATE IN
 HEMPFIELD & SEWICKLEY TOWNSHIPS
 WESTMORELAND COUNTY
PENNSYLVANIA

SCALE: 1 IN. = 400 FT.

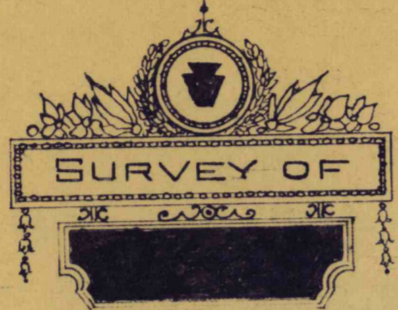




MAY 24, 1938 - FINAL

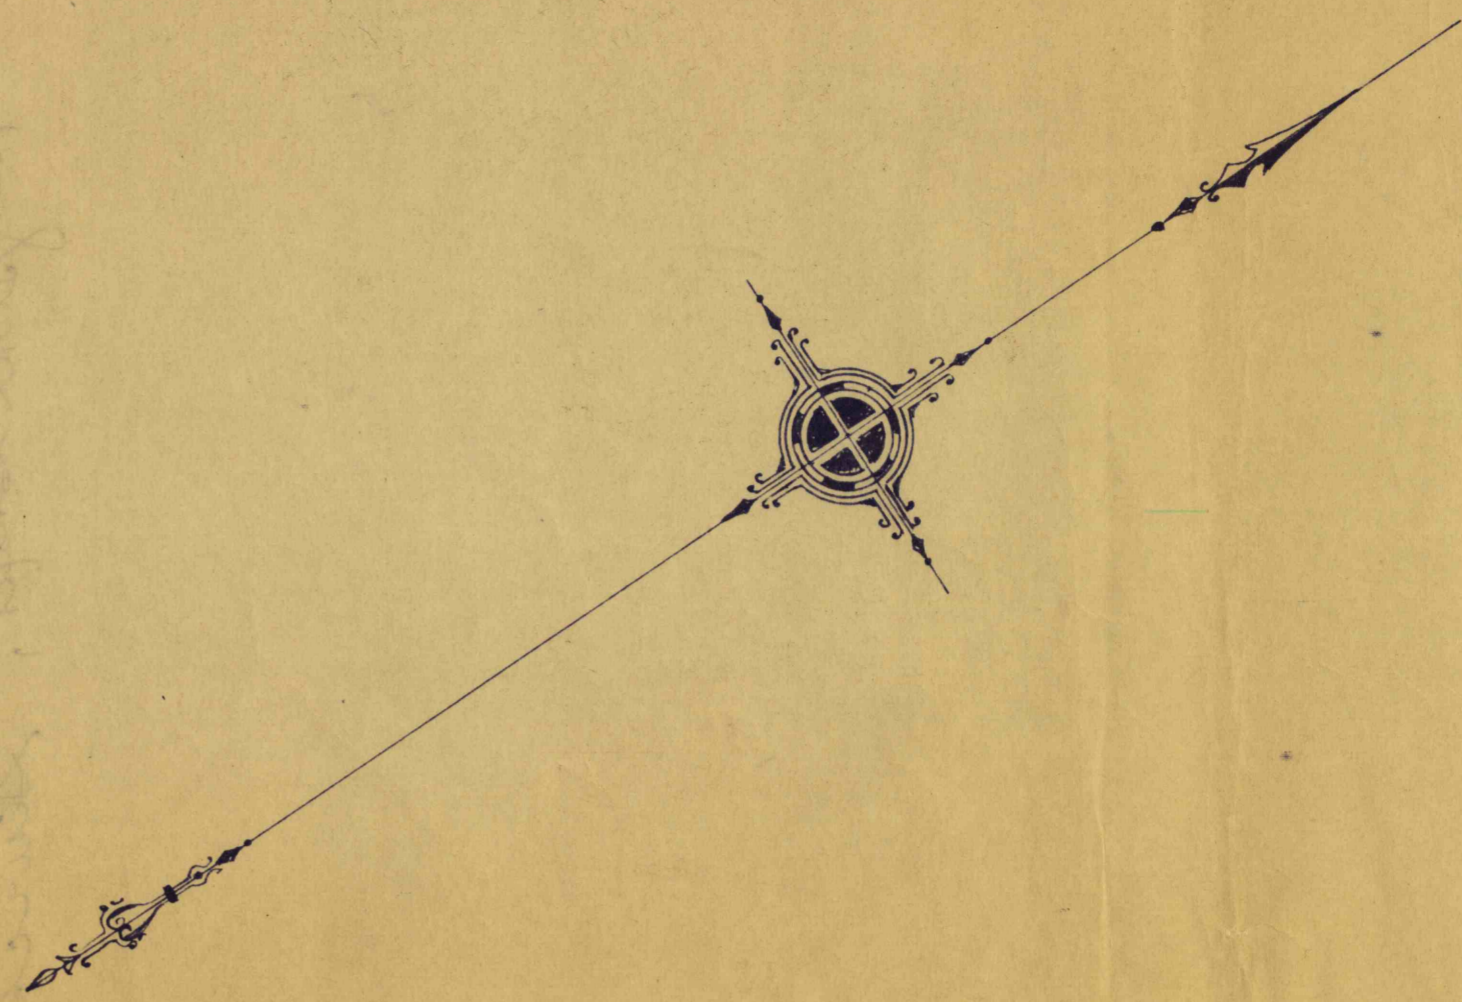

KEYSTONE SHAFT MINE : 1 INCH = 400 FEET

KEYSTONE SHAFT MINE : 1 INCH = 400 FEET

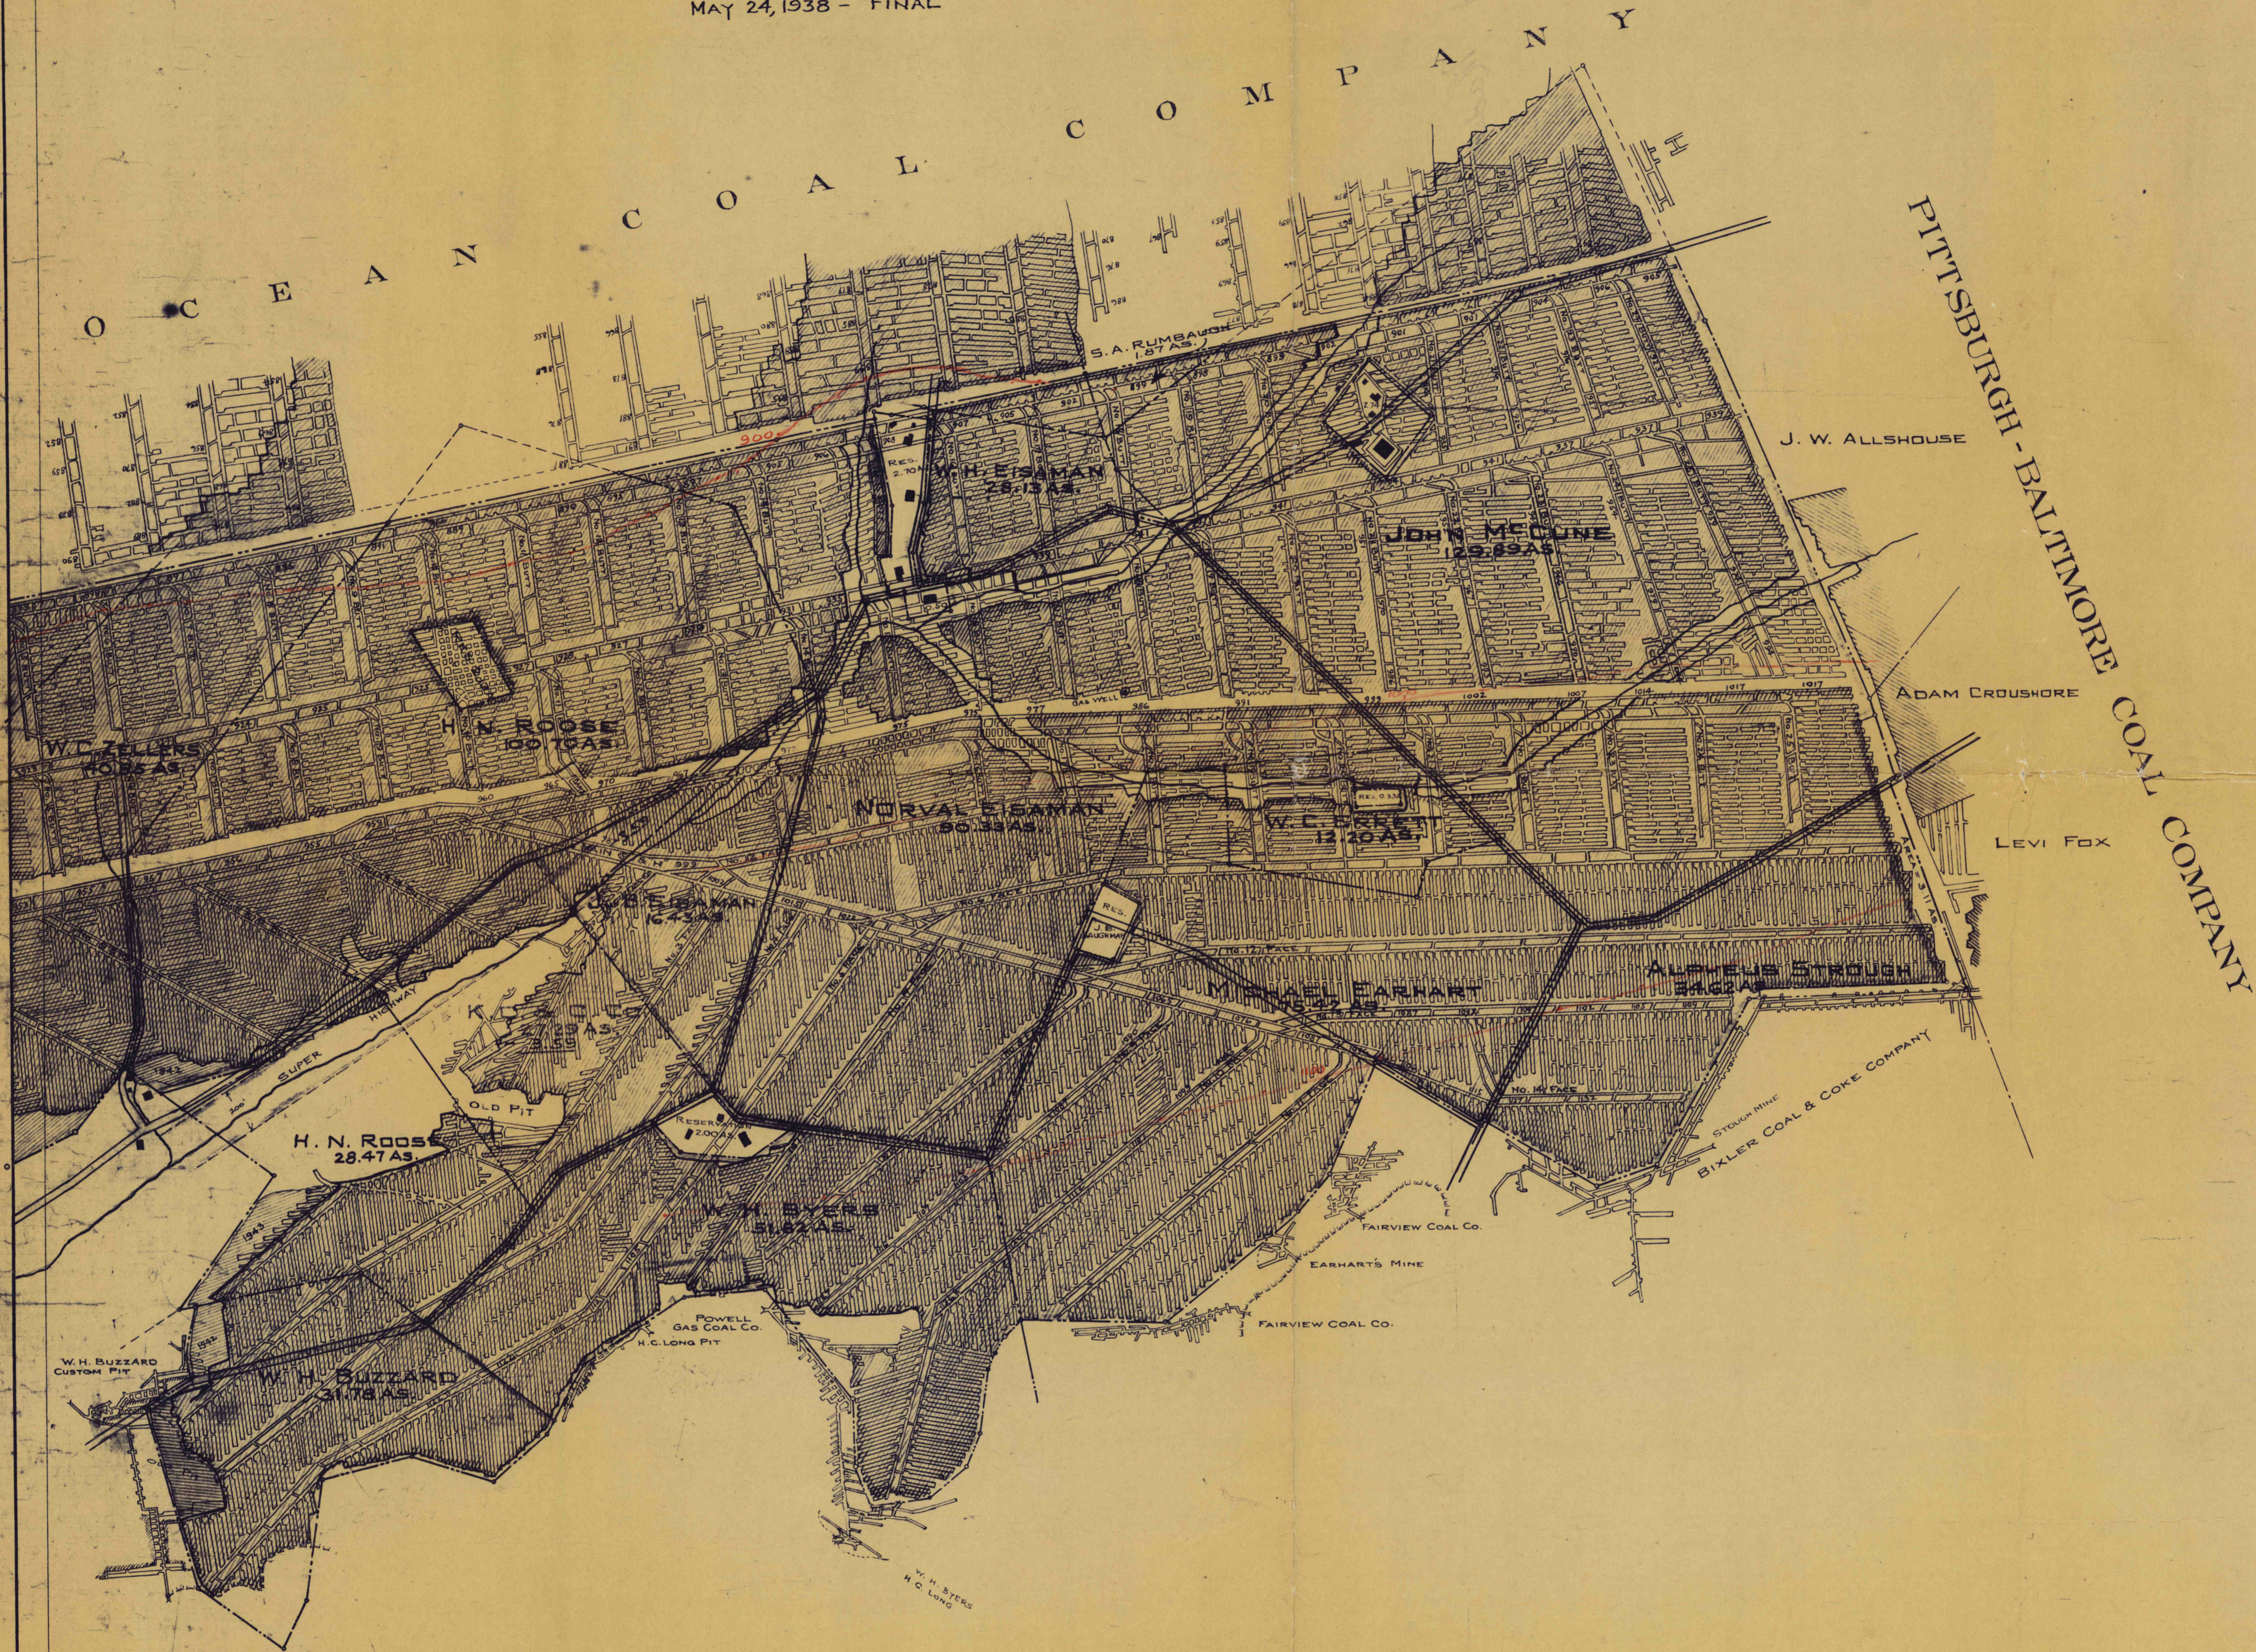

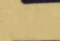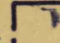BOUNDARY LINE OF COAL AREA OWNED SHOWN : 
 AREA OF SURFACE OWNED SHOWN : 

#1480
 8-13-37
 C.C.