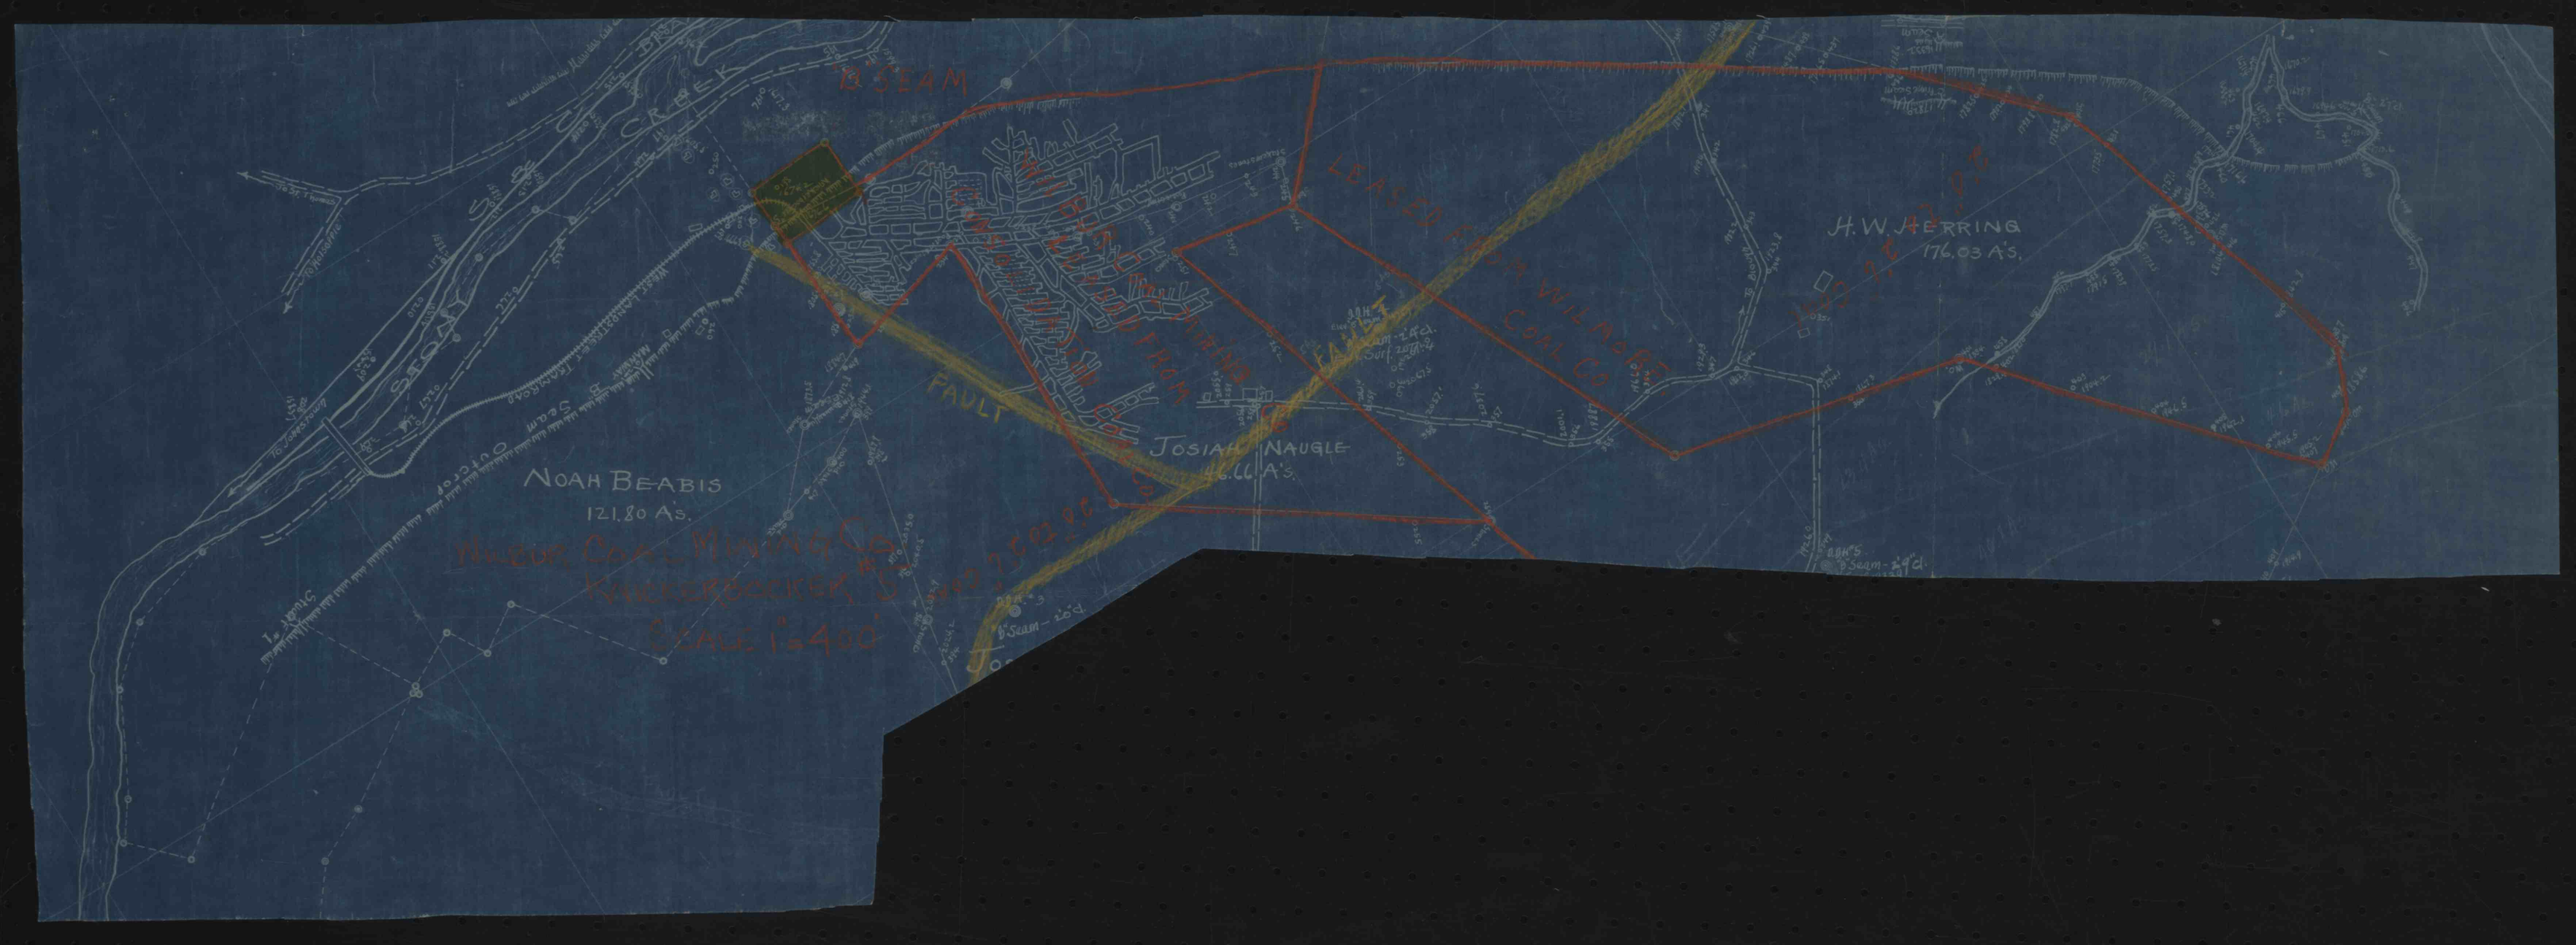

D SEAM
LEASED FROM WILMORE COAL CO
H.W. HERRING
176.03 A's.
FAULT
JOSIAH NAUGLE
46.66 A's.
NOAH BEABIS
121.80 A's.
NUCUR COAL MINING CO.
KNICKERBOCKER, "S"
SCALE 1"=400'
CREEK
STONY