


Commercial Coal Mining Co.  
Colliery #384  
Fayette, Blacklick Township Penna.  
Scale - 1" = 400' 7-1-20

214  
6-27-77  
C.C.

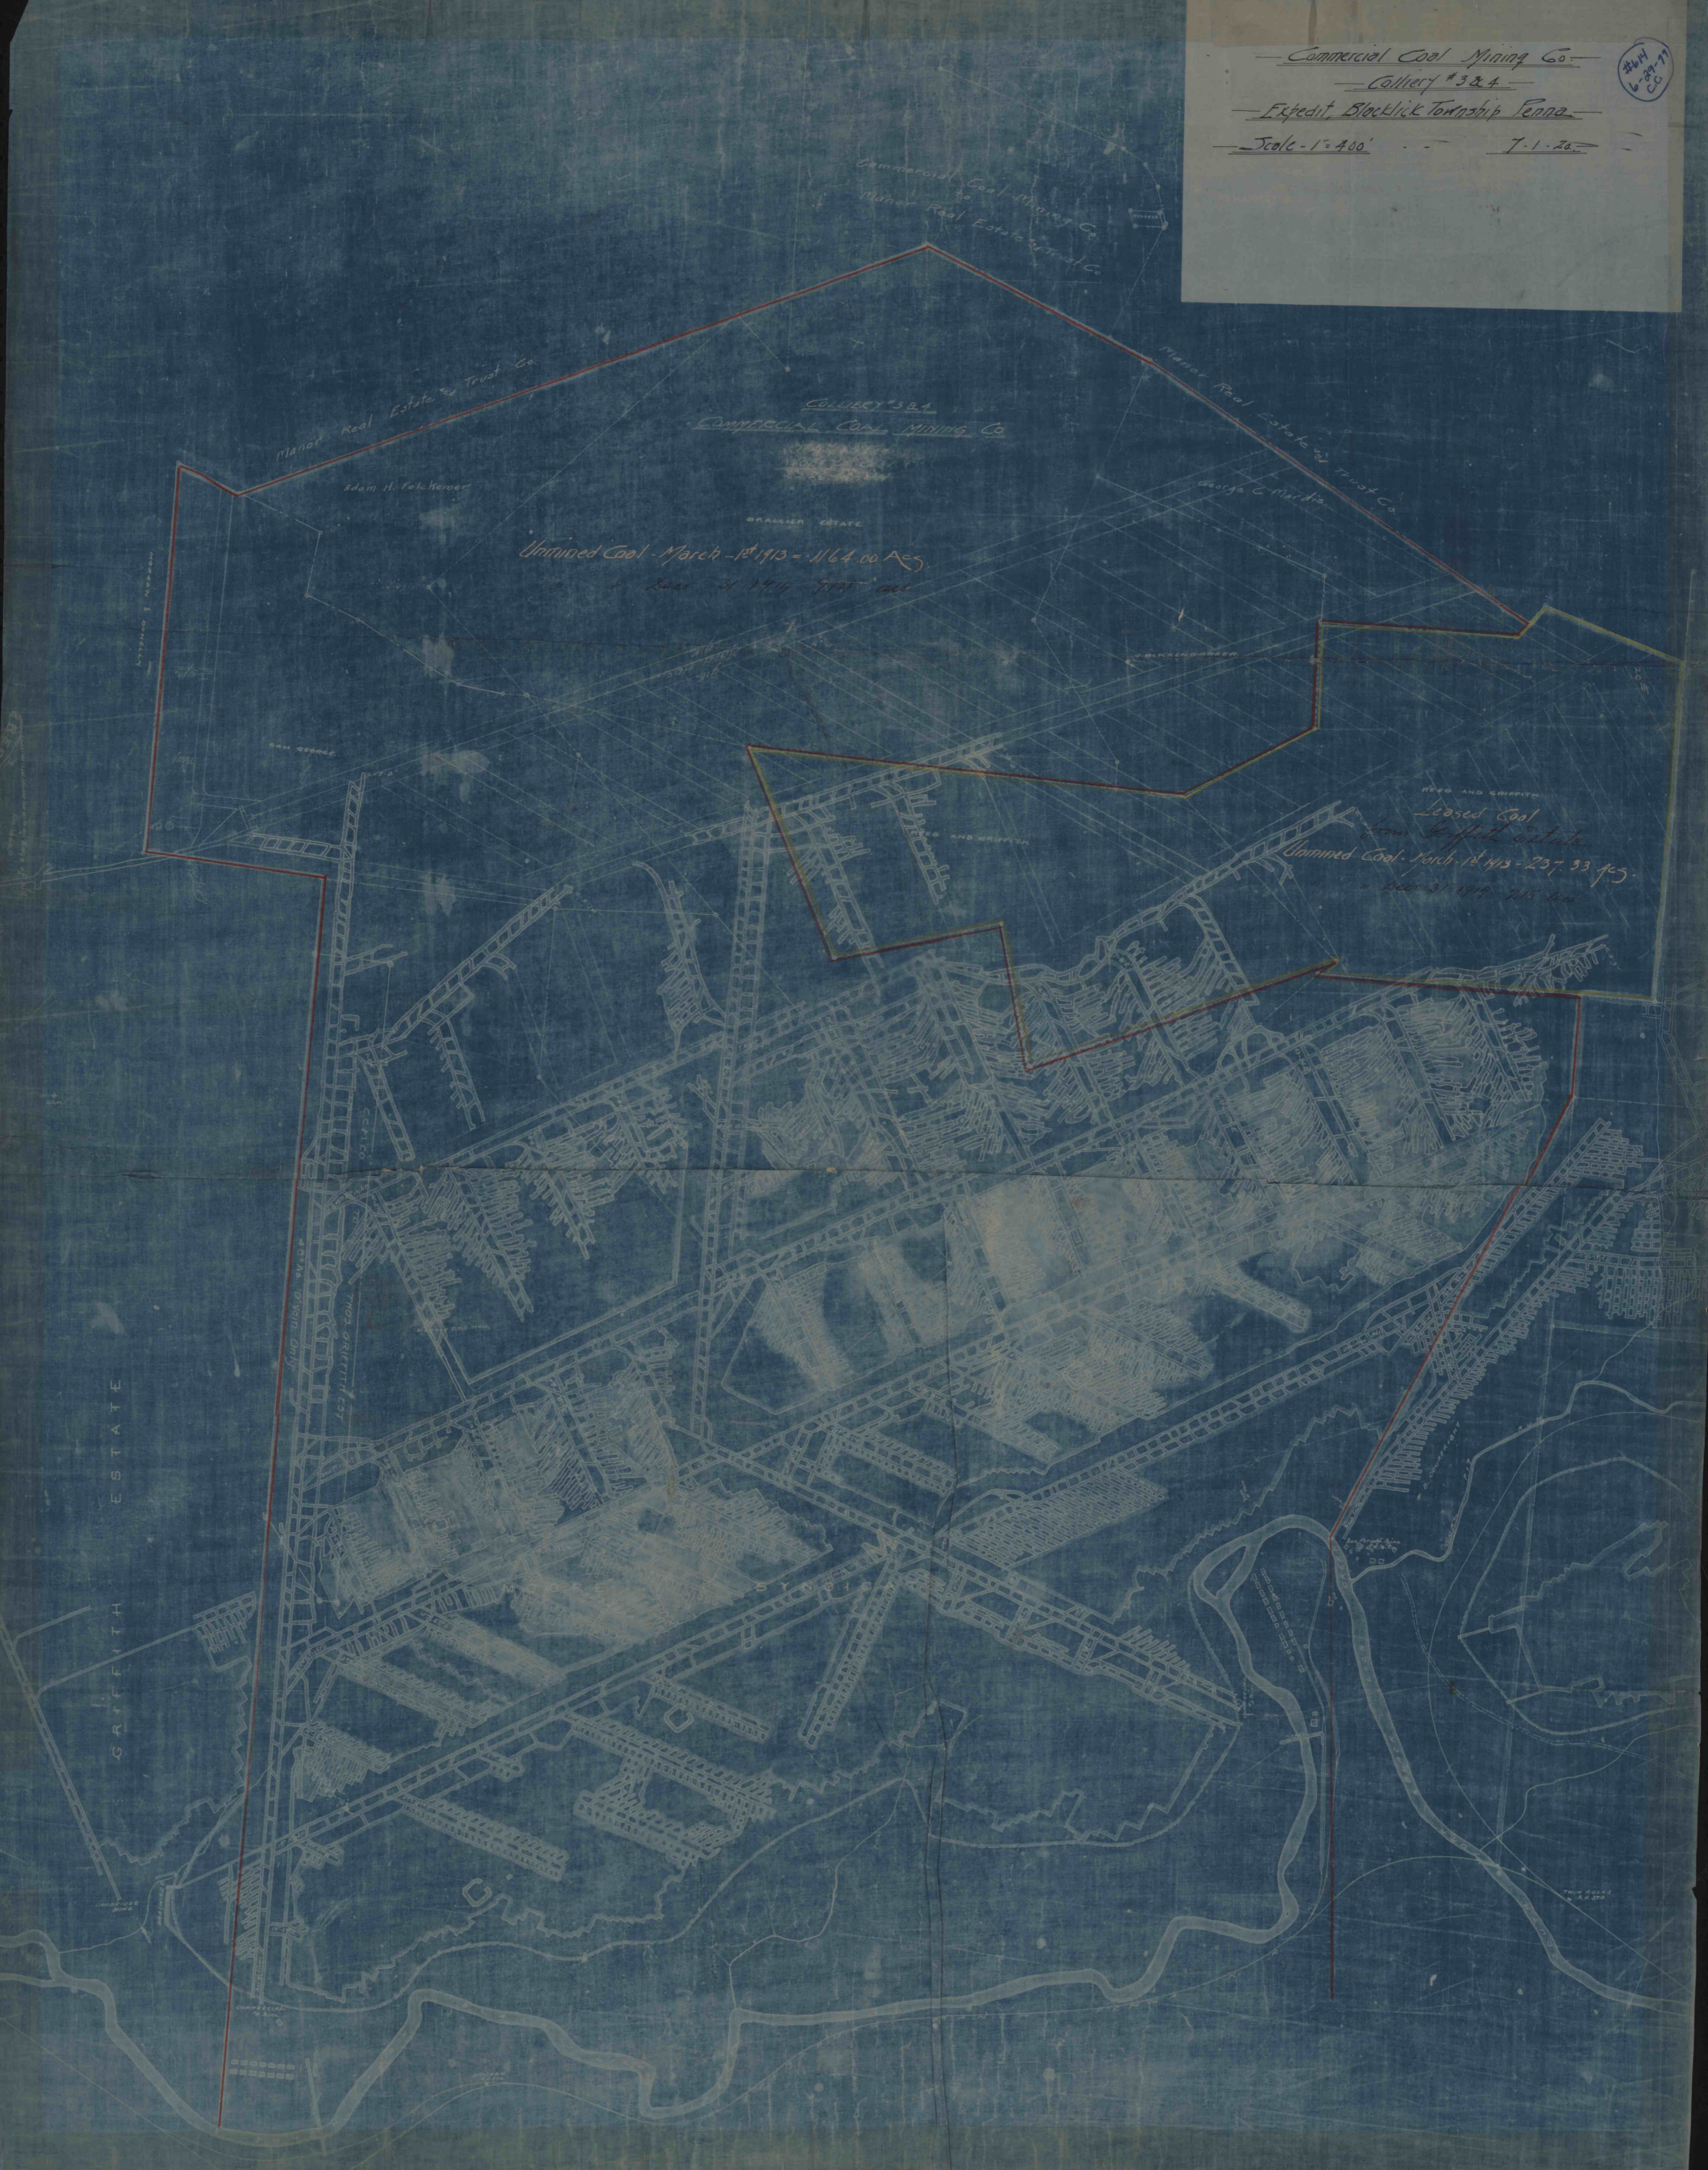

Manor Real Estate Trust Co.

COLLIERY #384  
COMMERCIAL COAL MINING CO.

Adam H. Falk Kerner

GRANIER ESTATE

Unmined Coal - March - 12 1913 - 1164.00 AC.  
Dec 31 1914 999' coal

Manor Real Estate Trust Co.  
George C. Nantz

Leased Coal  
from Griffith Estate  
Unmined Coal - March - 12 1913 - 237.33 AC.  
Dec 31 1914 215' coal

GRIFITH ESTATE

MS. GRIFITH EST.

WATER

THE RIVER