


I HEREBY CERTIFY THAT THE PRINTED MATERIAL ON THIS MAP CORRECTLY SHOWS THE MINE AND PROPERTY OF INLAND STEEL COAL COMPANY, LANGASHIRE NO 25 MINE AS OF AUGUST 1, 1985. THIS MAP SHOWS THE FINAL WORKINGS OF THE MINE PRIOR TO SEALING.

I FURTHER CERTIFY THAT THIS MAP WAS REPRODUCED UNDER MY JURISDICTION, FROM THE FIELD SURVEYS, AND THAT THE SURVEYS ON THE SURFACE AND UNDERGROUND ARE CORRECTLY COORDINATED, AND THE MAP IS CORRECT TO THE BEST OF MY KNOWLEDGE AND BELIEF.

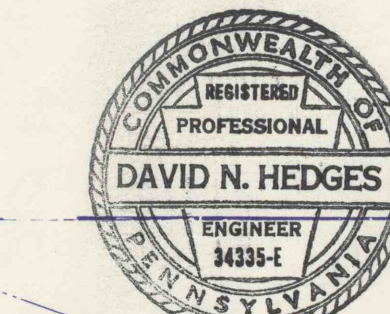

David N. Hedges
 DAVID N. HEDGES, P.E.
 PROJECT ENGINEER
 REGISTERED PROFESSIONAL ENGINEER OF
 THE COMMONWEALTH OF PENNSYLVANIA
 NO. PE-03433-E

USBM 36-00838
LANGASHIRE NO 25 'D' SEAM
SCALE 1" = 400'
POSTED TO 8-1-85

