


INTAKE REGULATOR
RETURN REGULATOR
DARK
9-1-54
14,000'

PROTECT THIS AREA FROM 50 FEET FROM EDGE OF 100' RAD. PROTECTION

PROTECT THIS AREA FROM 50 FEET FROM EDGE OF 100' RAD. PROTECTION

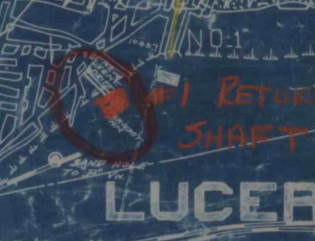

LUCERN