


MAP OF MAPLE RIDGE COLLIERY  
 BENNS CREEK COAL MINING CO. "LESSEE"  
 ON PROPERTY OF CAMBRIA MINING & MF'G COMPANY  
 BENNS CREEK, PA.  
 "SCALE" 1"=400'

MADE BY Geo. H. Ayres Eng'g.

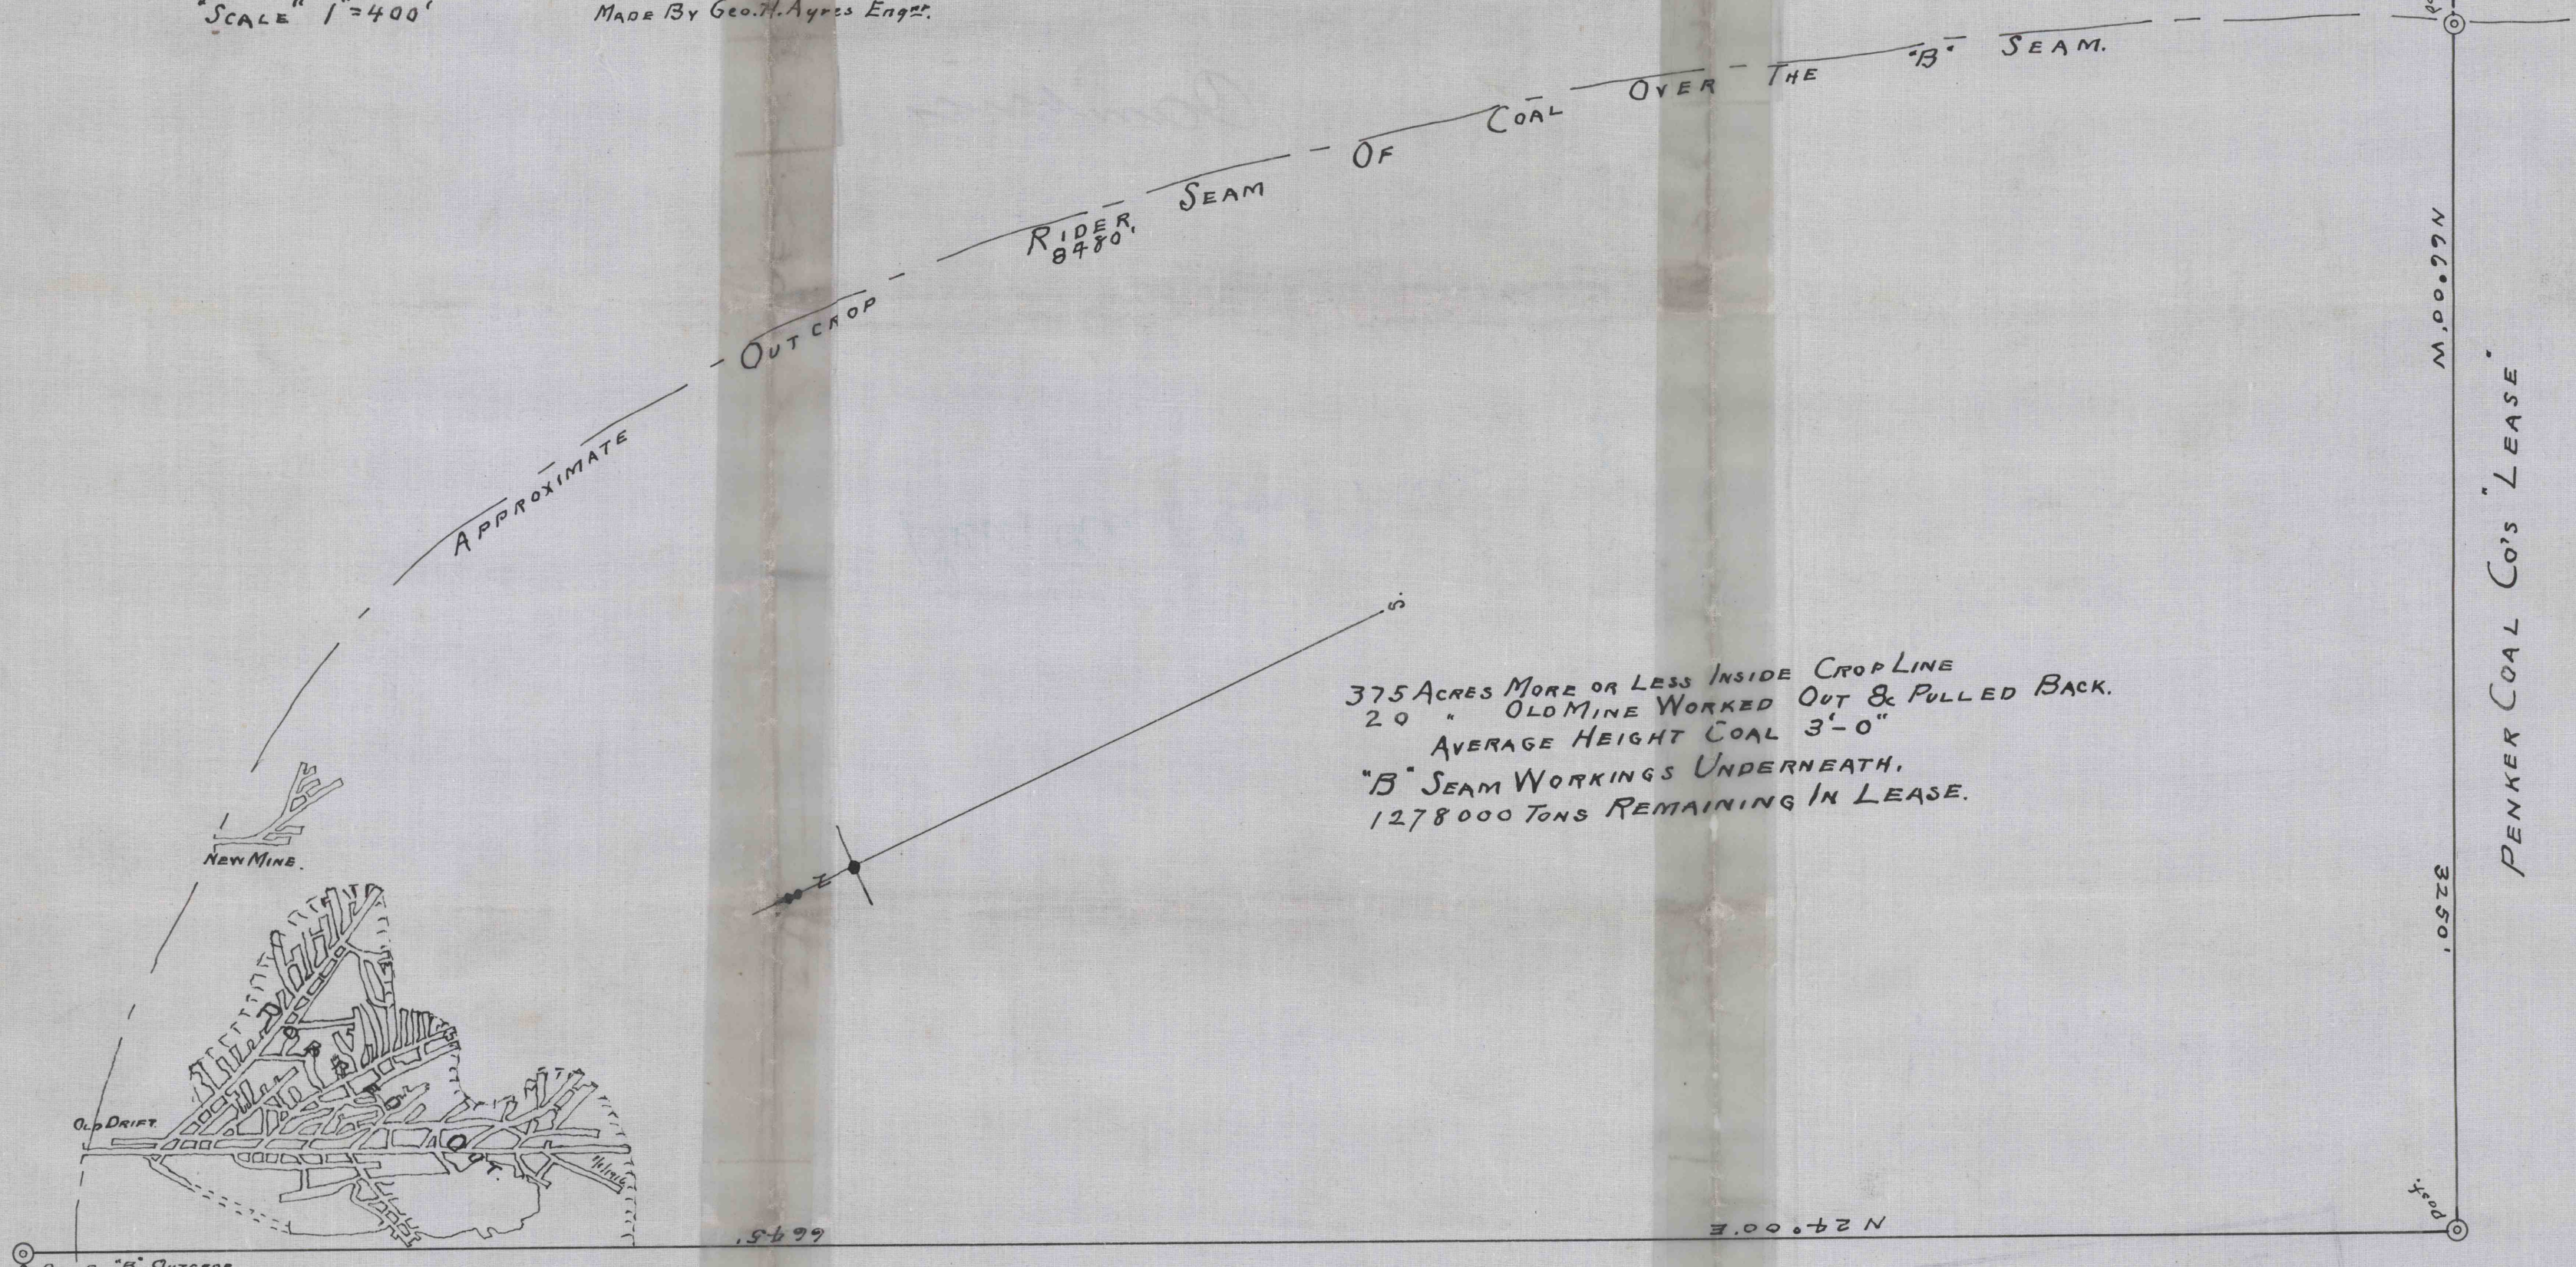

M. J. LEISENRING & Co.

PROPERTY OF THE  
 DEPARTMENT OF THE  
 AUDITOR GENERAL'S