


MINE MAP
 WORTHVILLE MINE *Pheasant Hollow*
 RINGGOLD TOWNSHIP, JEFFERSON COUNTY, PA.
 SCALE 1"=400' JUNE 8, 1956
 WALTER J. ZIMMERMAN SURVEYOR ENGINEER PUNXSUTAW, PA.

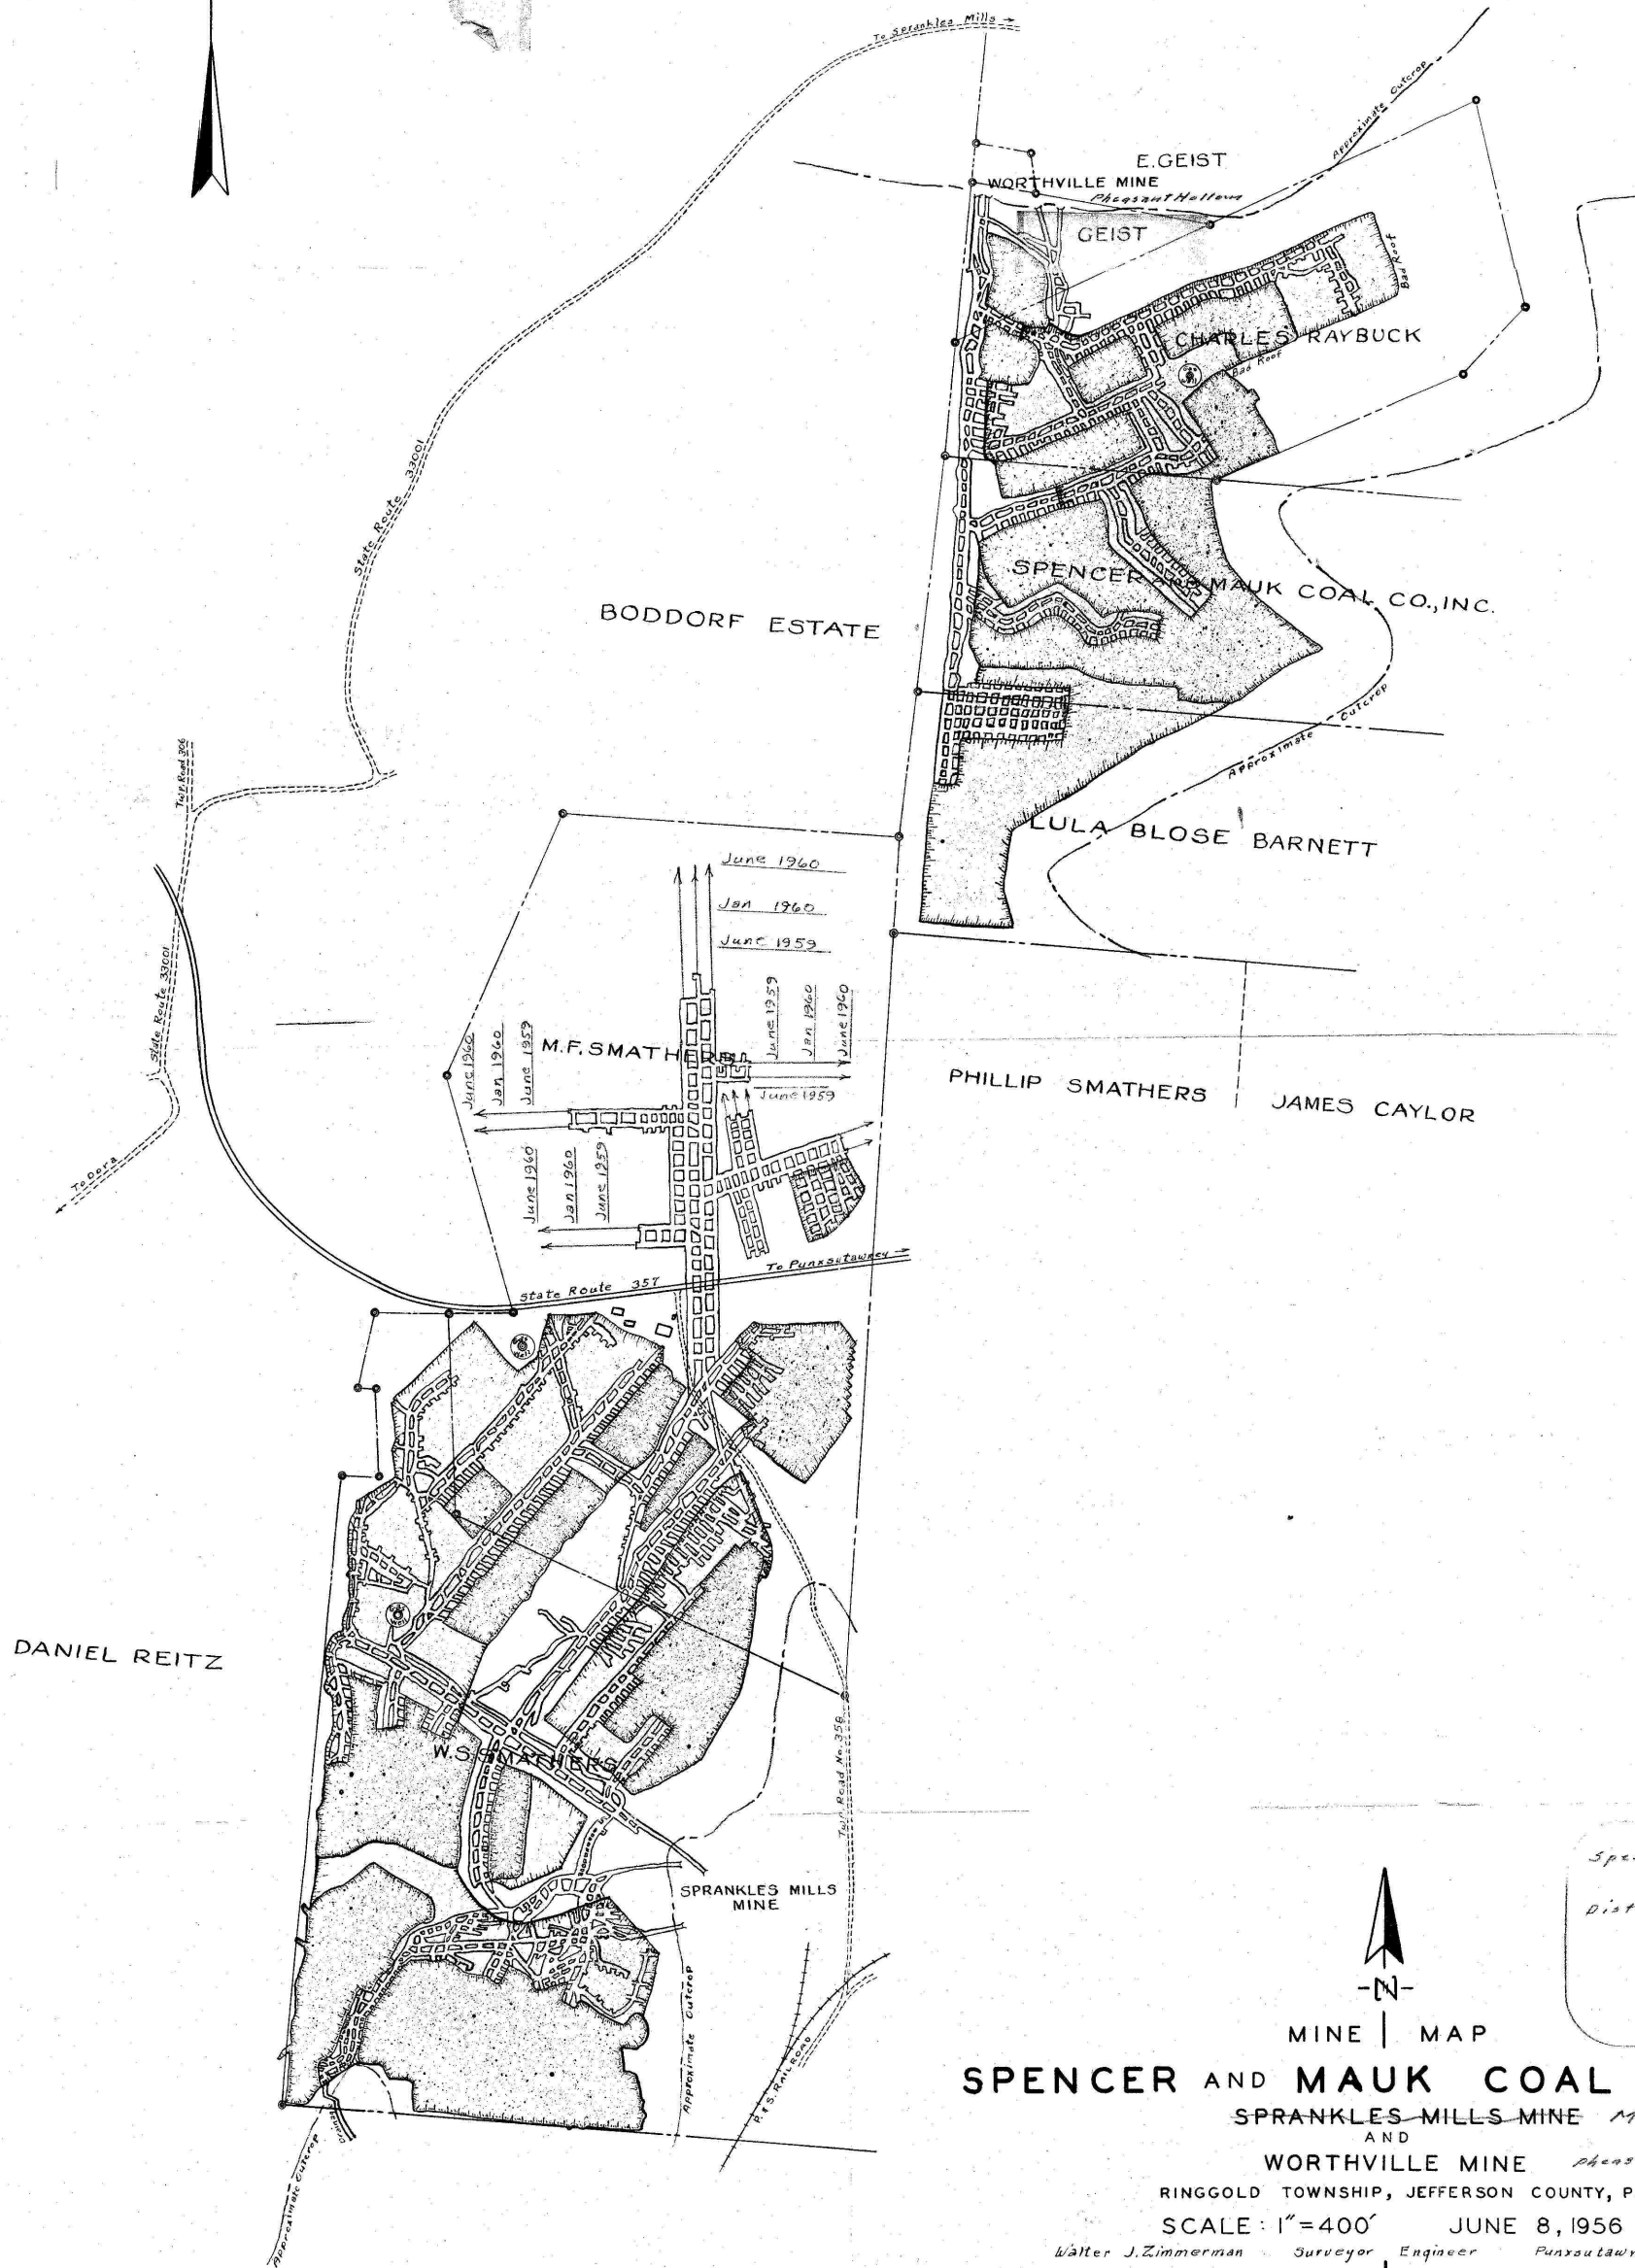

MINE MAP
SPENCER AND MAUK COAL CO., INC.
 SPRANKLES MILLS MINE *Mauk*
 AND
 WORTHVILLE MINE *Pheasant Hollow*
 RINGGOLD TOWNSHIP, JEFFERSON COUNTY, PA.
 SCALE 1"=400' JUNE 8, 1956
 Walter J. Zimmerman Surveyor Engineer Punxsutaw, Pa.

MAR 2 1959
 Spencer & Mauk Coal Co.
 "Mauk"
 District 17 1957 Annual

#1749
 12-15-99
 C.C.