


■ Coal Area
 ■ Mined out - Mining Completed
 No Dwellings
 Date April 17, 1967 to Oct. 17, 1967

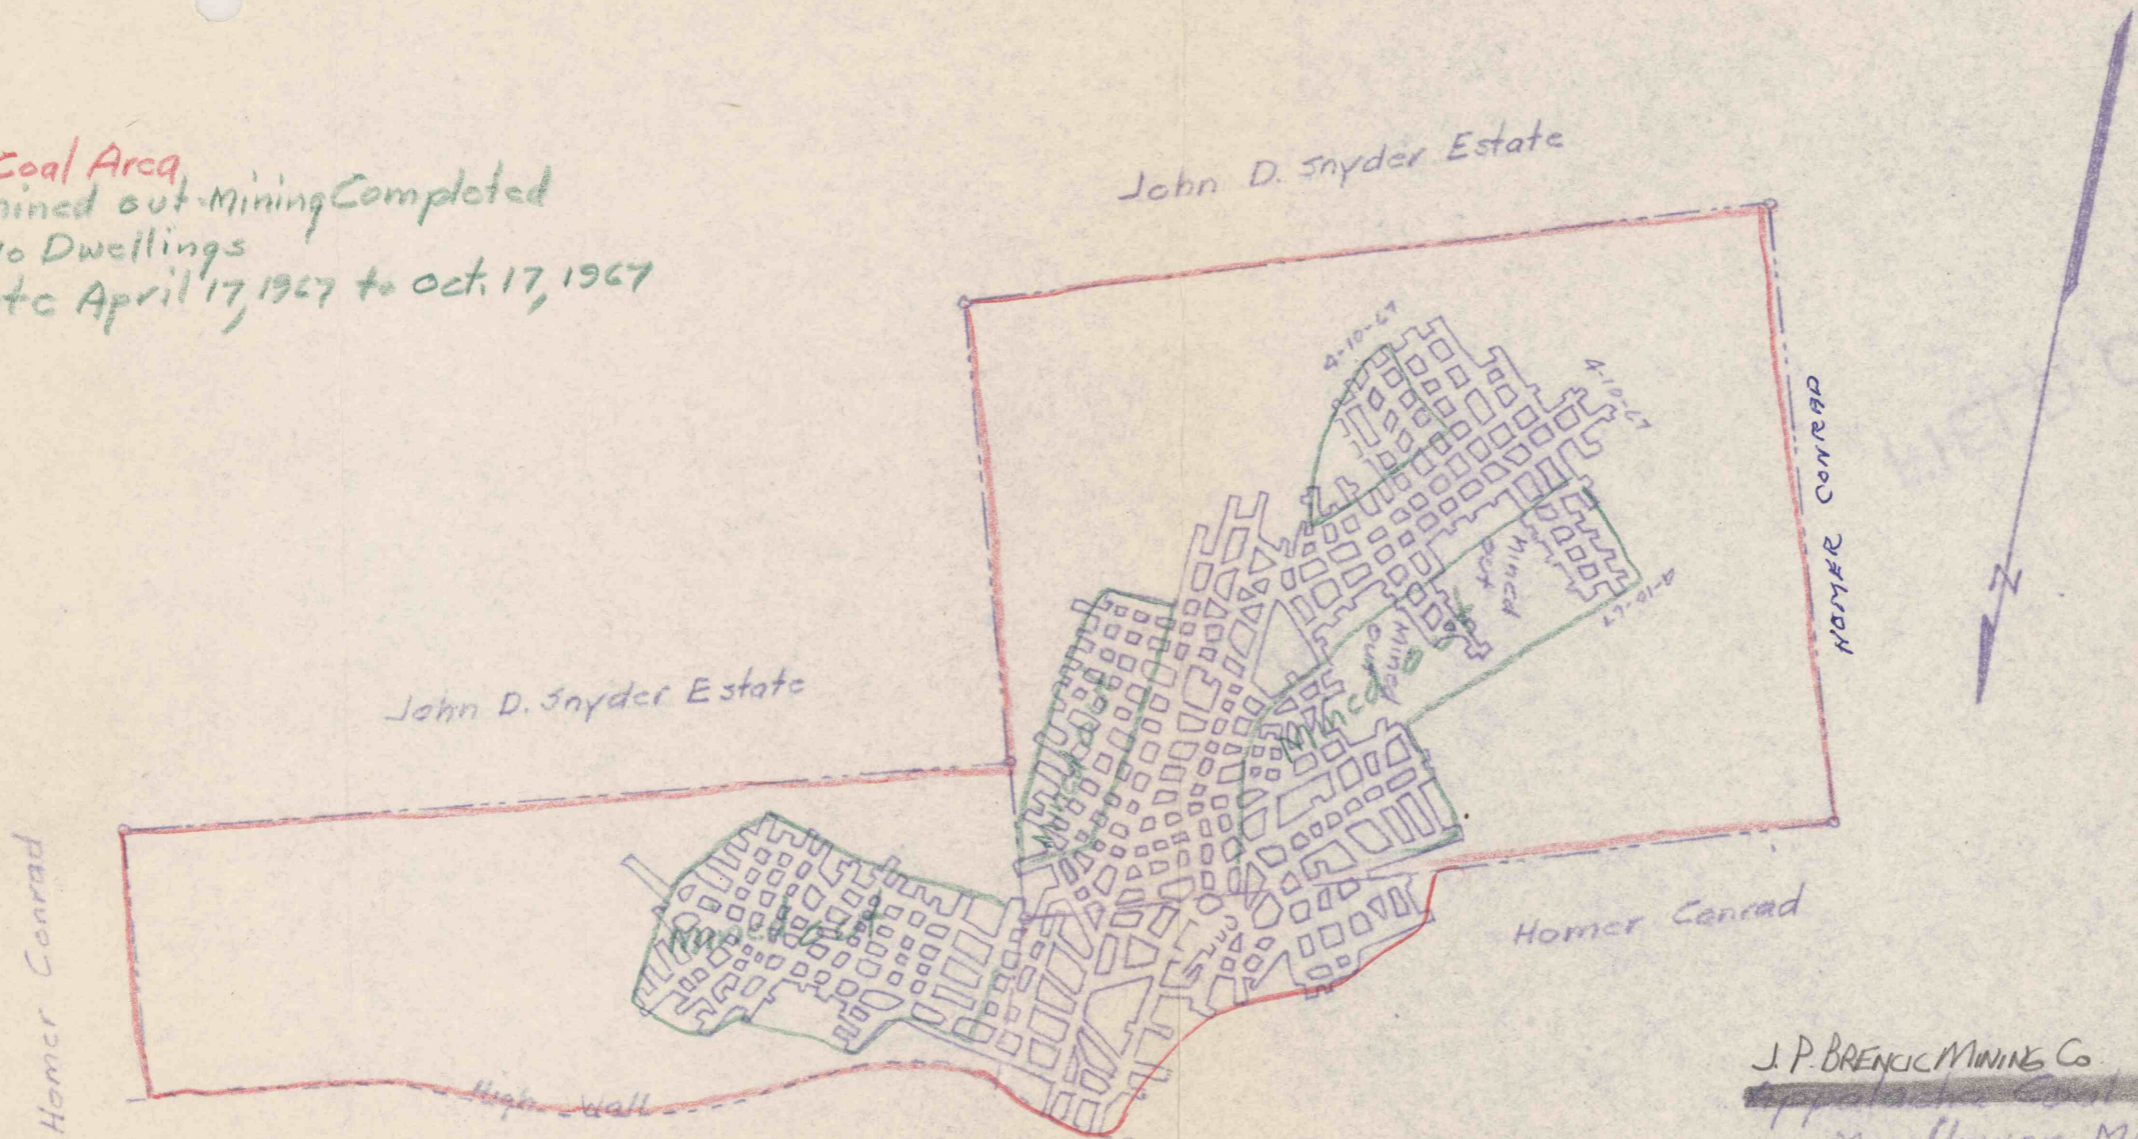

J.P. BRANCIE MINING Co.
~~Appalachian Coal Company~~
 Mayflower Mine
 J. Phillip Brancie Operator
 Brushvalley Twp., Indiana Co., Pa.
 Scale 1"=400' April 13, 1967
 Graft Engineering Co.
 Blairsville, Pa