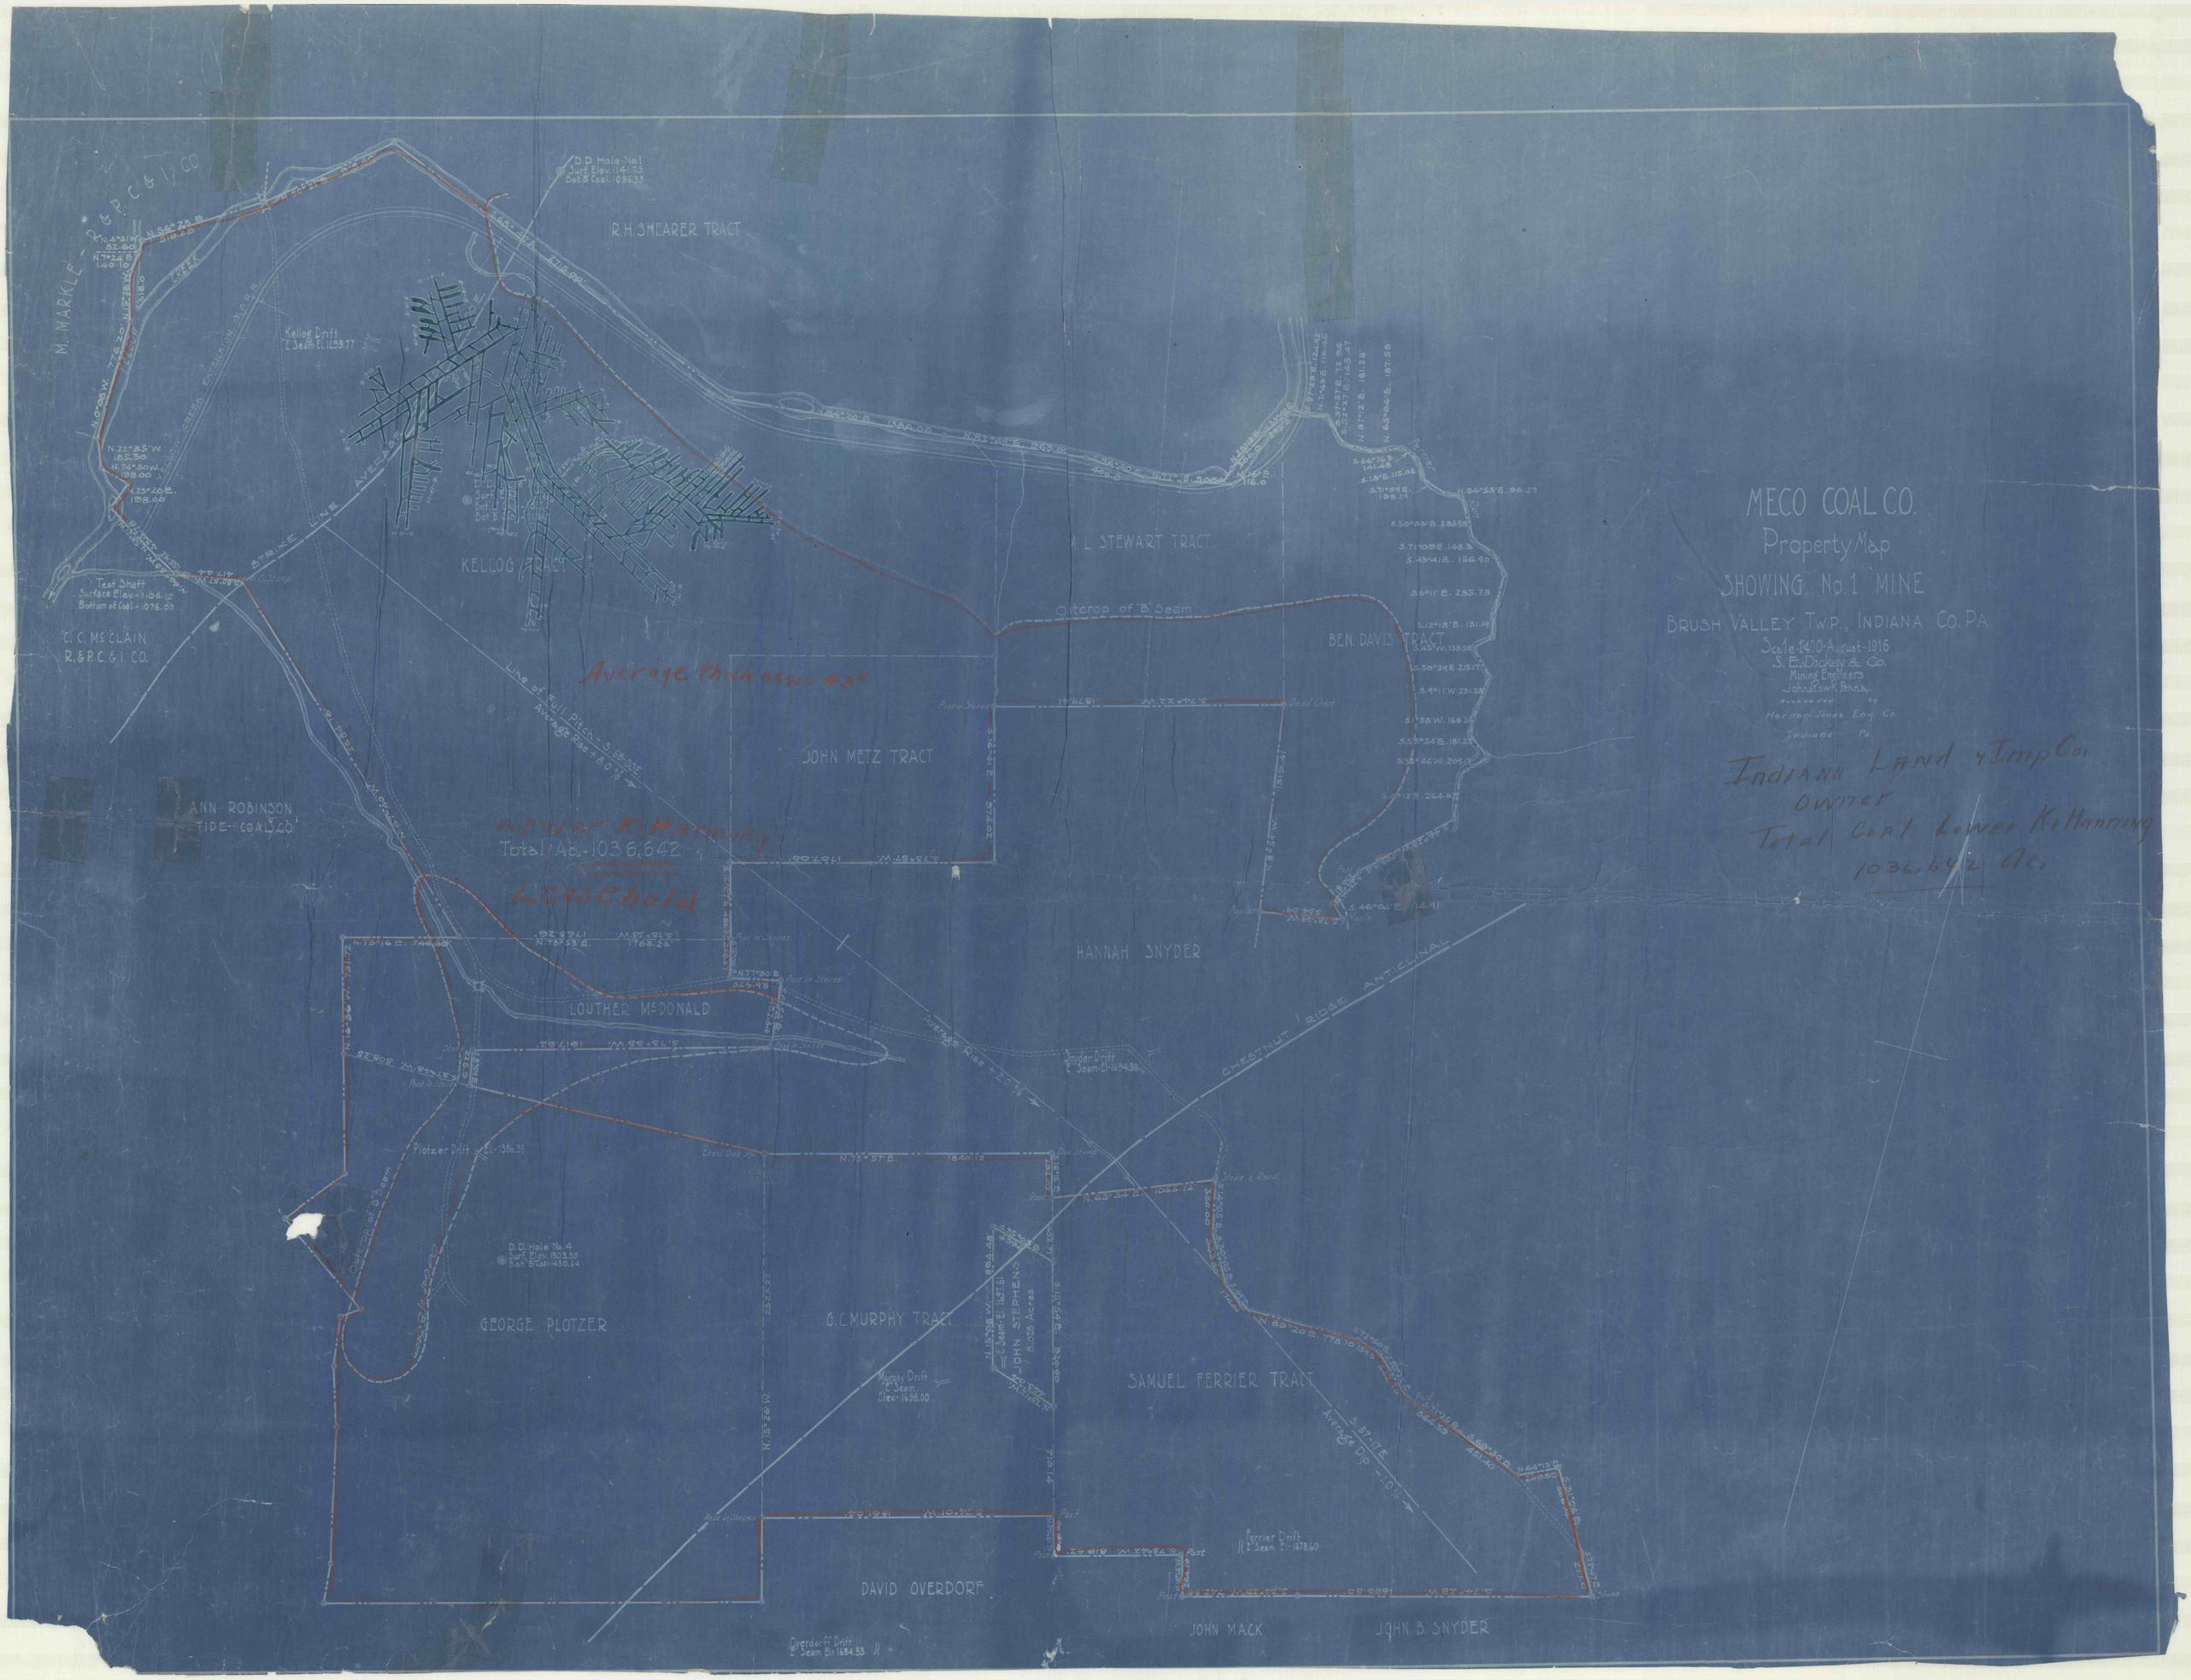
MECO COAL CO.
Property Map
SHOWING No. 1 MINE
BRUSH VALLEY TWP., INDIANA CO. PA.
Scale 1:400 - August - 1916
S. E. Dickey & Co.
Mining Engineers
Johnstown Penna.
Succeeded by
Horner-Jones Eng. Co.
Indiana Pa.
Indiana Land & Imp Co.
Owner
Total Coal Lower Kittanning
1036.642 Ac.
Average thickness 4.8"
Lower Kittanning
Total Ac. - 1036.642
Leasehold
R.H. SHEARER TRACT
KELLOG TRACT
M. L. STEWART TRACT
BEN. DAVIS TRACT
JOHN METZ TRACT
HANNAH SNYDER
LOUTHER McDONALD
GEORGE PLOTZER
G. C. MURPHY TRACT
SAMUEL FERRIER TRACT
DAVID OVERDORF
JOHN MACK
JOHN B. SNYDER
ANN ROBINSON
TIDE COAL CO.
C. C. McCLAIN
R. & P. C. & I. CO.
M. MARKLE - R. & P. C. & I. CO.
STRIKE LINE AVERAGE
CHESTNUT RIDGE ANTICLINAL
Outcrop of "B" Seam
Line of Full Pitch - S. 68.00 E.
Average Rise + 8.0 %
Average Rise + 2.0 %
Average Dip - 1.0 %
Kellog Drift
E Seam El. 1299.77
Test Shaft
Surface Elev. - 1106.19
Bottom of Coal - 1076.00
D.D. Hole No. 1
Surf. Elev. 1141.73
Bot. B Coal 1096.33
D.D. Hole No. 4
Surf. Elev. 1503.39
Bot. B Coal 1430.64
Plotzer Drift
Murphy Drift
E Seam
Elev. - 1698.00
Ferrier Drift
E Seam El. - 1678.60
Overdorff Drift
E Seam El. 1684.53
Snyder Drift
E Seam El. 1694.38
Post in Stones
Dead Chest
Stake & Road
Post
Stone