

SOMERS MINE No. 4.
PITTSBURGH COAL CO.

SOMERS MINE No. 2.
PITTSBURGH COAL CO.

KENNEDY MINE
HENDERSON COAL CO.

M. C. & C. C. CO.
MONESSEN MINE

MINED OUT BY
L. P. CARTER COAL WORKS.
CARTER

MONONGAHELA RIVER

LEGEND.

- (A) Coal Reserve Under House And Barn.
- (B) Ribs And Stumps Left In To Support Shaft.
- (C) Mining Rights Reserved.
- (E) Gas Well.
- (D) Shaft.

MONESSEN COAL AND COKE CO.
ALICIA, PA.

SUBJECT Mine Map.

FOR Monessen Mine
Rostraver Township
Westmoreland County, Pa.



SCALE 1-in. = 400-Feet.

DRAWN BY DATE
TRACED BY R.L.F. W.A.A. Jan. 20, 1929.

CHECKED BY
REVISED 6-30-1932, 12-17-1932, 5-22-1933, 12-27-1933,
6-26-1934.

DATE PRINTED DRAWING NUMBER
6/20/34 719.

Drawer No. 44.

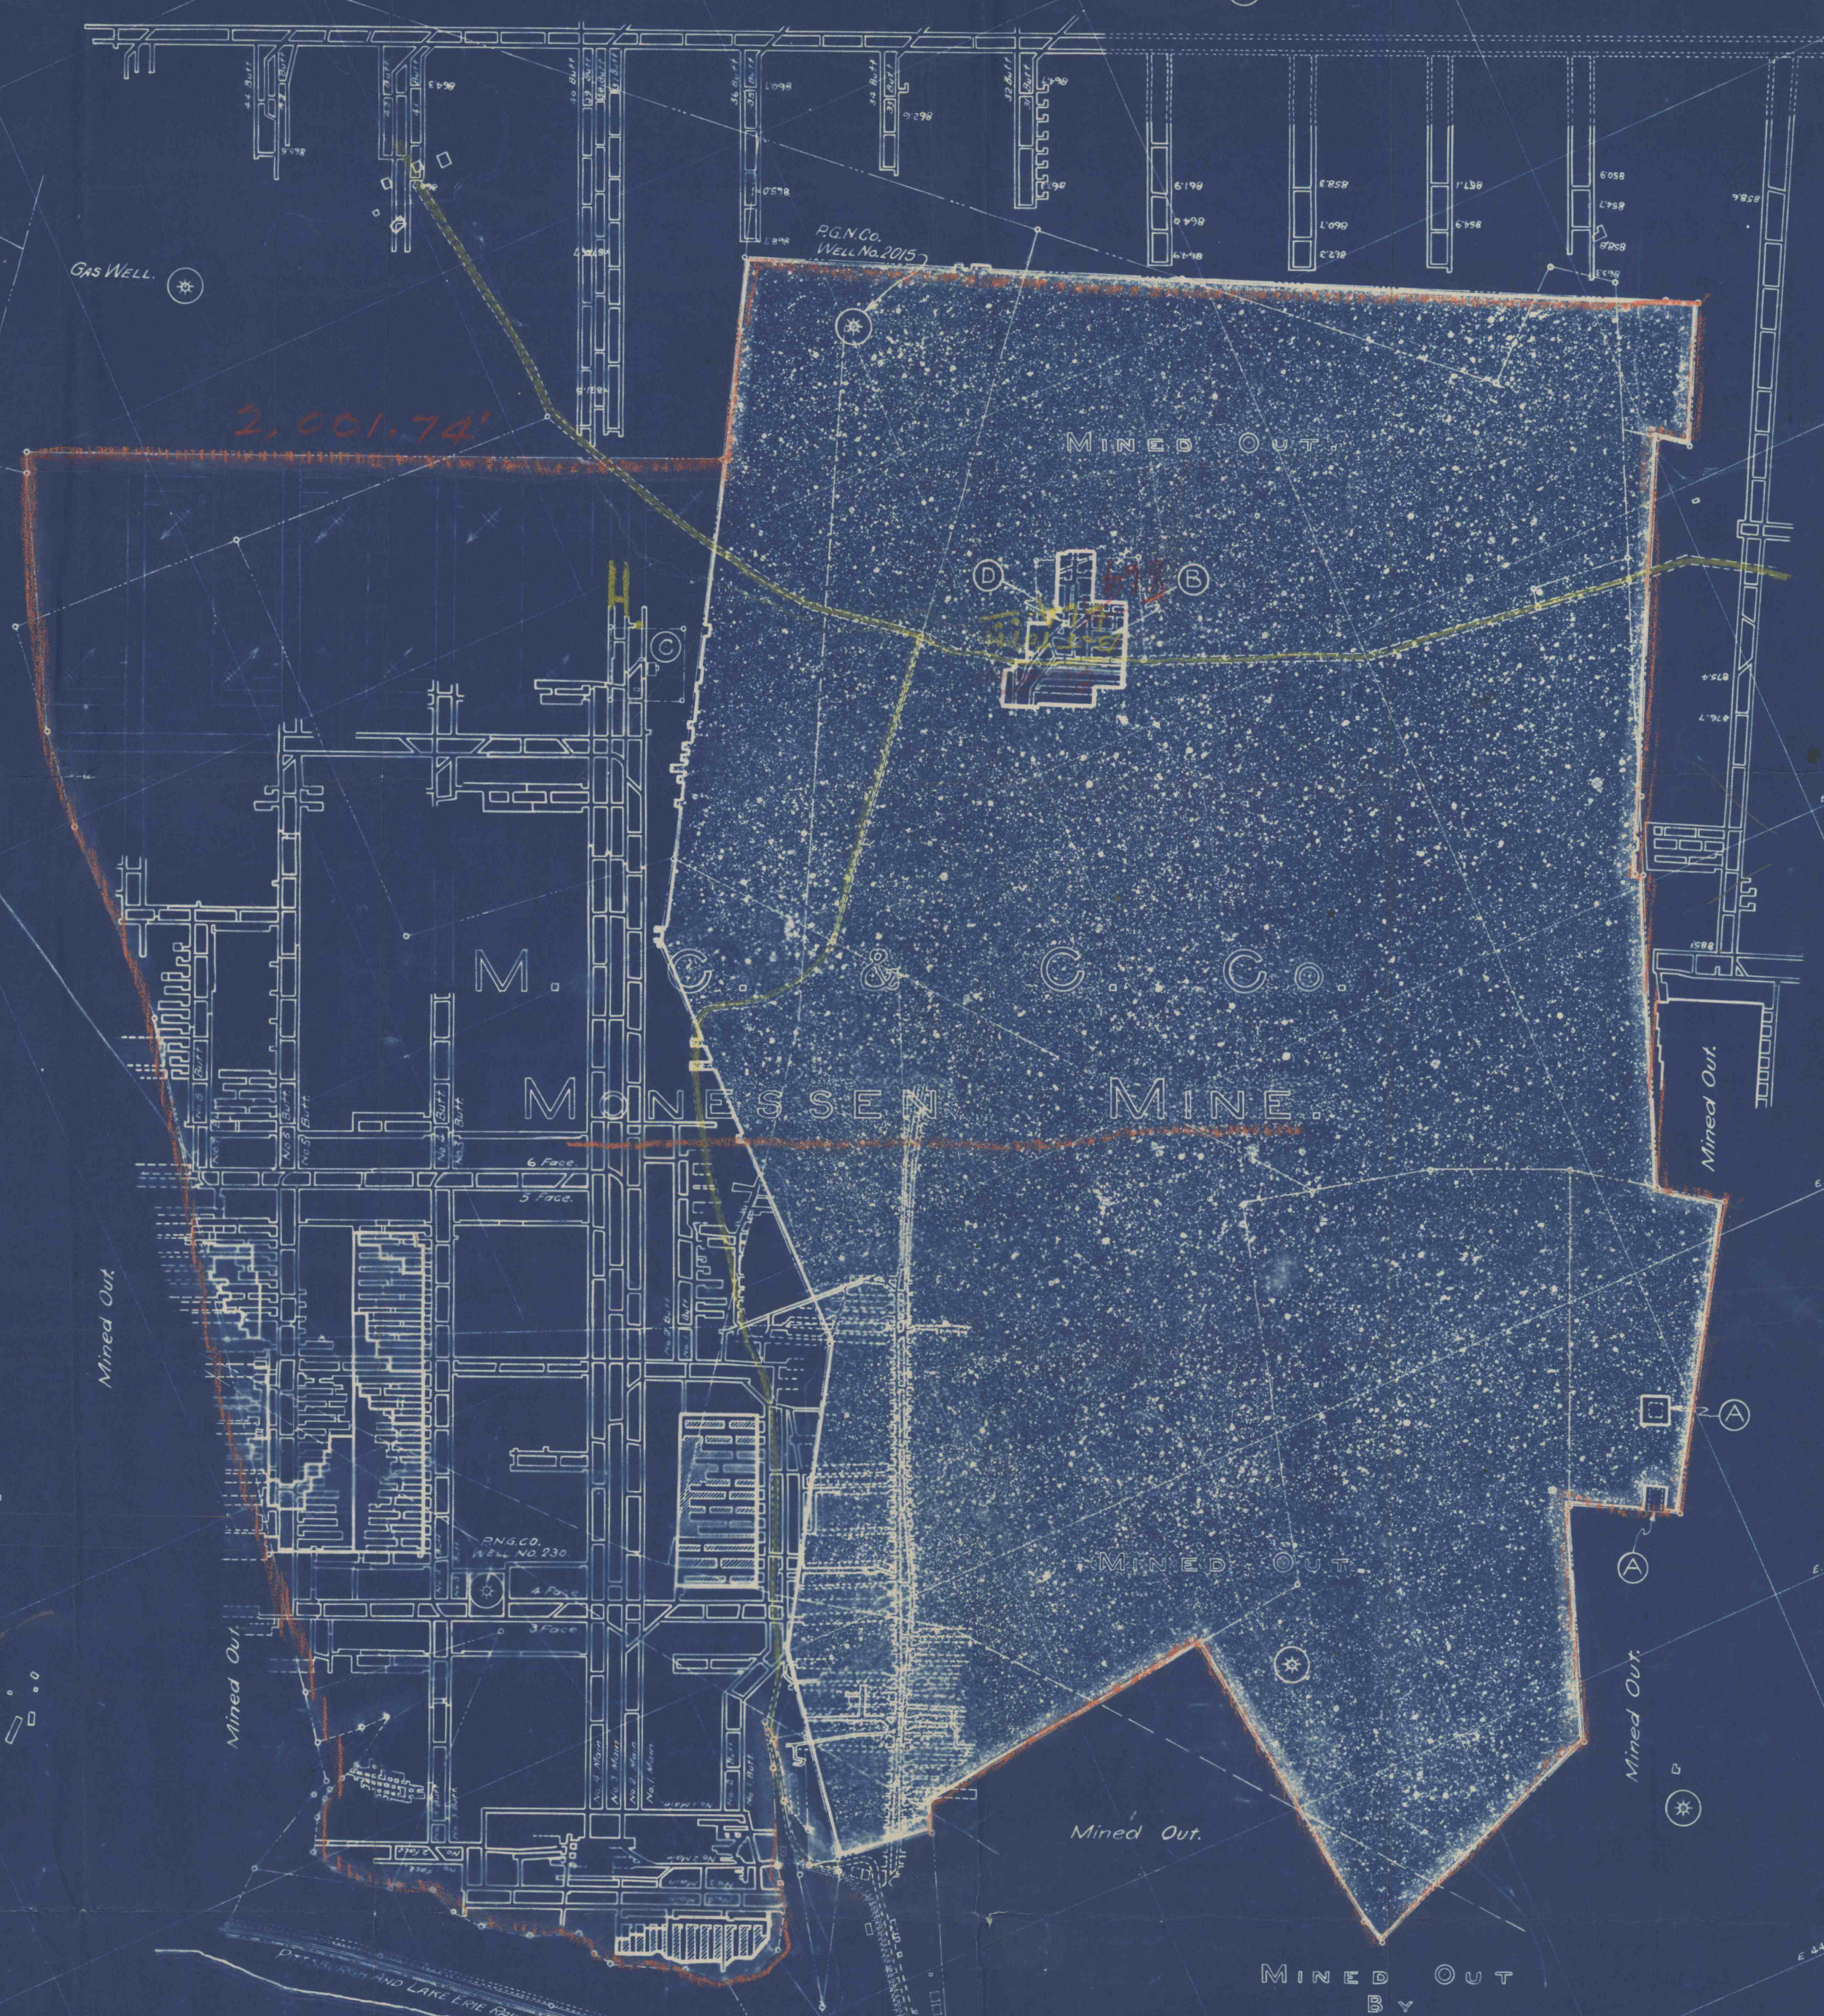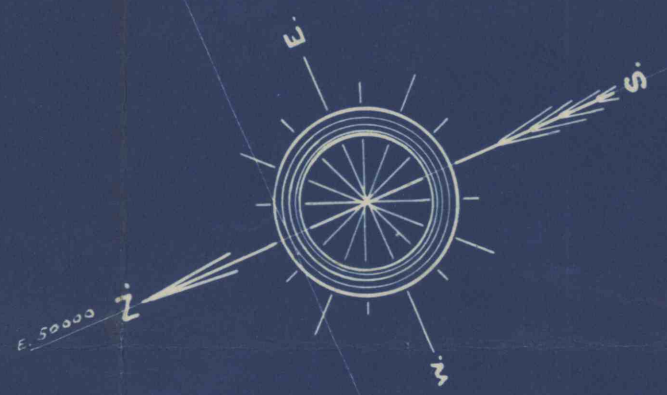


