


NEMAQUIN MINE  
THE BUCKEYE COAL CO.

PROPERTY MAP SHOWING  
MINE WORK  
AS OF 4-27-1966  
Scale - 1" = 400'

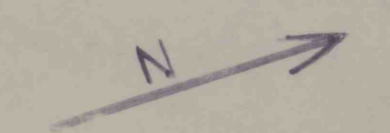

- LEGEND**
- = Mined Previous to 19
  - = " During
  - = Gas Well - Producing
  - = " " Abandoned
  - = Test Hole (Diamond Drill)
  - = Highway

THE BUCKEYE COAL CO.  
NEMAQUIN MINE  
GREENE COUNTY MINE MAP  
SCALE: 1"=400'  
DATE: 7-19-66  
DWG # 66-01  
SHEET 10-1  
BLOWN UP FROM 8 1/2" SCALE MAP  
INDEX MAP IS ON SHEET 10-4

