


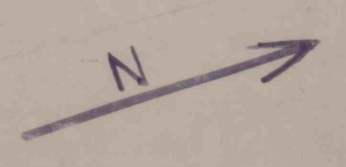

NEMAQUIN MINE
THE BUCKEYE COAL CO.
 PROPERTY MAP SHOWING
 MINE WORK
 AS OF 4-27-1966
 Scale - 1" = 400'



- LEGEND**
- = Mined Previous to 19
 - = " During
 - = Gas Well - Producing
 - = " " Abandoned
 - = Test Hole (Diamond Drill)
 - = Highway

THE BUCKEYE COAL CO.
 NEMAQUIN MINE
 GREENE COUNTY MINE MAP
 SCALE: 1" = 400'
 DATE: 7-19-66
 DWG. # 64-051
 SHEET NO. 2
 BLOWN UP FROM 800 SCALE MAP
 INDEX MAP IS ON SHEET NO. 1
 DEEP MINE SAFETY



