

ALBERT BURNETT  
P. P. & K - COAL

WEAVER & BETTS

JOSIAH THOMPSON  
P. P. & K

PEAL, PEACOCK, & KERR  
BURNETT - COAL


HOFFMAN  
P. P. & K

BURNETT - FEE

A. O. TATE

JAMES THOMPSON  
P. P. & K

EST  
COAL

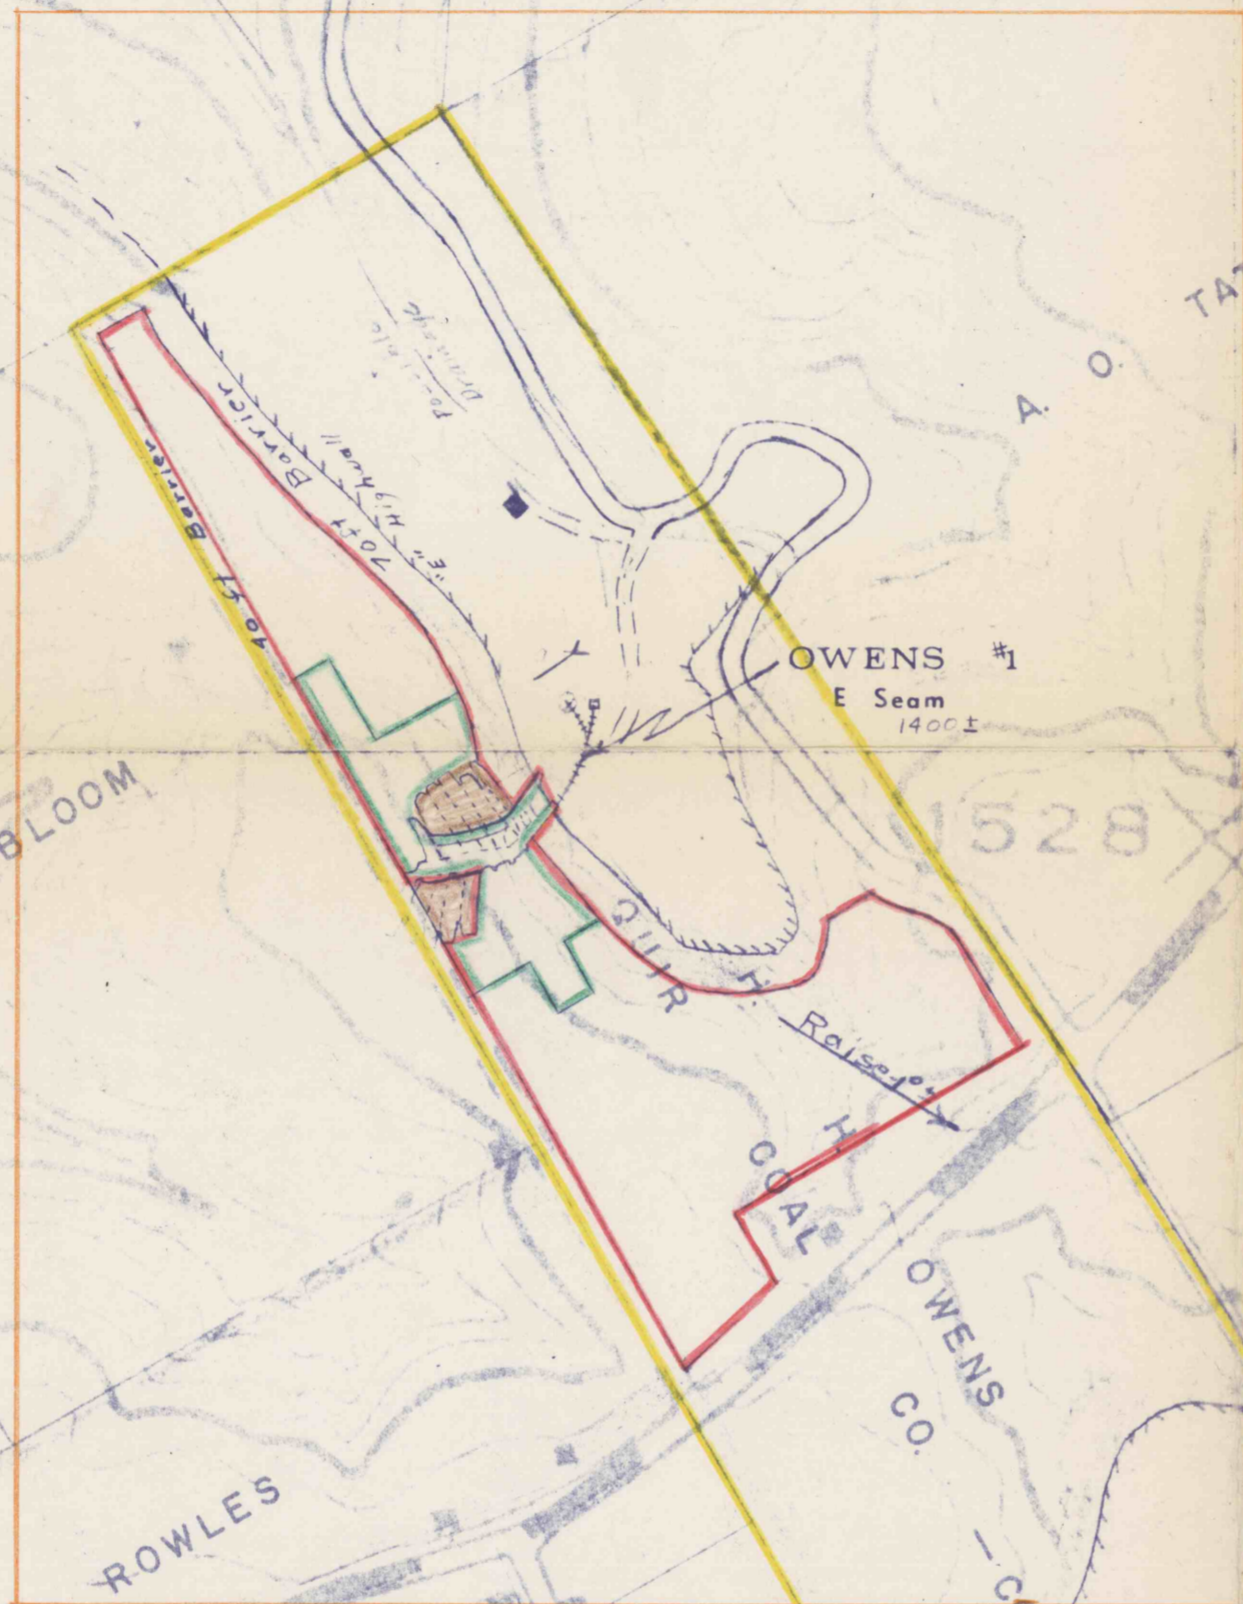

- Surface Land Over Mine □
- Extent Operations Under Permit 21 Acres □
- Workings for Six Months □
- AUGUST 27, 1966 to FEBRUARY 27, 1967
- Area Shown on 100 ft □
- Area Previously Mined □

A. C. TATE EST.  
COAL COMPANY - COAL

WM. BRESSLER  
HARVEY ROWLES - COAL

ROWLES

OWENS CO.

HARVEY

ROBERT

ROWLES - COAL

OSCAR MILLER

STACY  
AARON ROWLES - COAL

MILTON REED

Revised: 9/13/66 - for Subsidence - J.W.H.

ELENSKY BROTHERS


DEEP MINE MAP

LAWRENCE TWP., CLEARFIELD CO., PA.

SCALE - 1 inch = 400 feet

APRIL 19, 1965  
CLEARFIELD, PA.

JOHN W. HESS  
ENGINEER

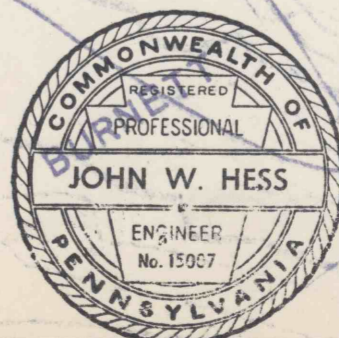

#2013  
12-25-99  
CC