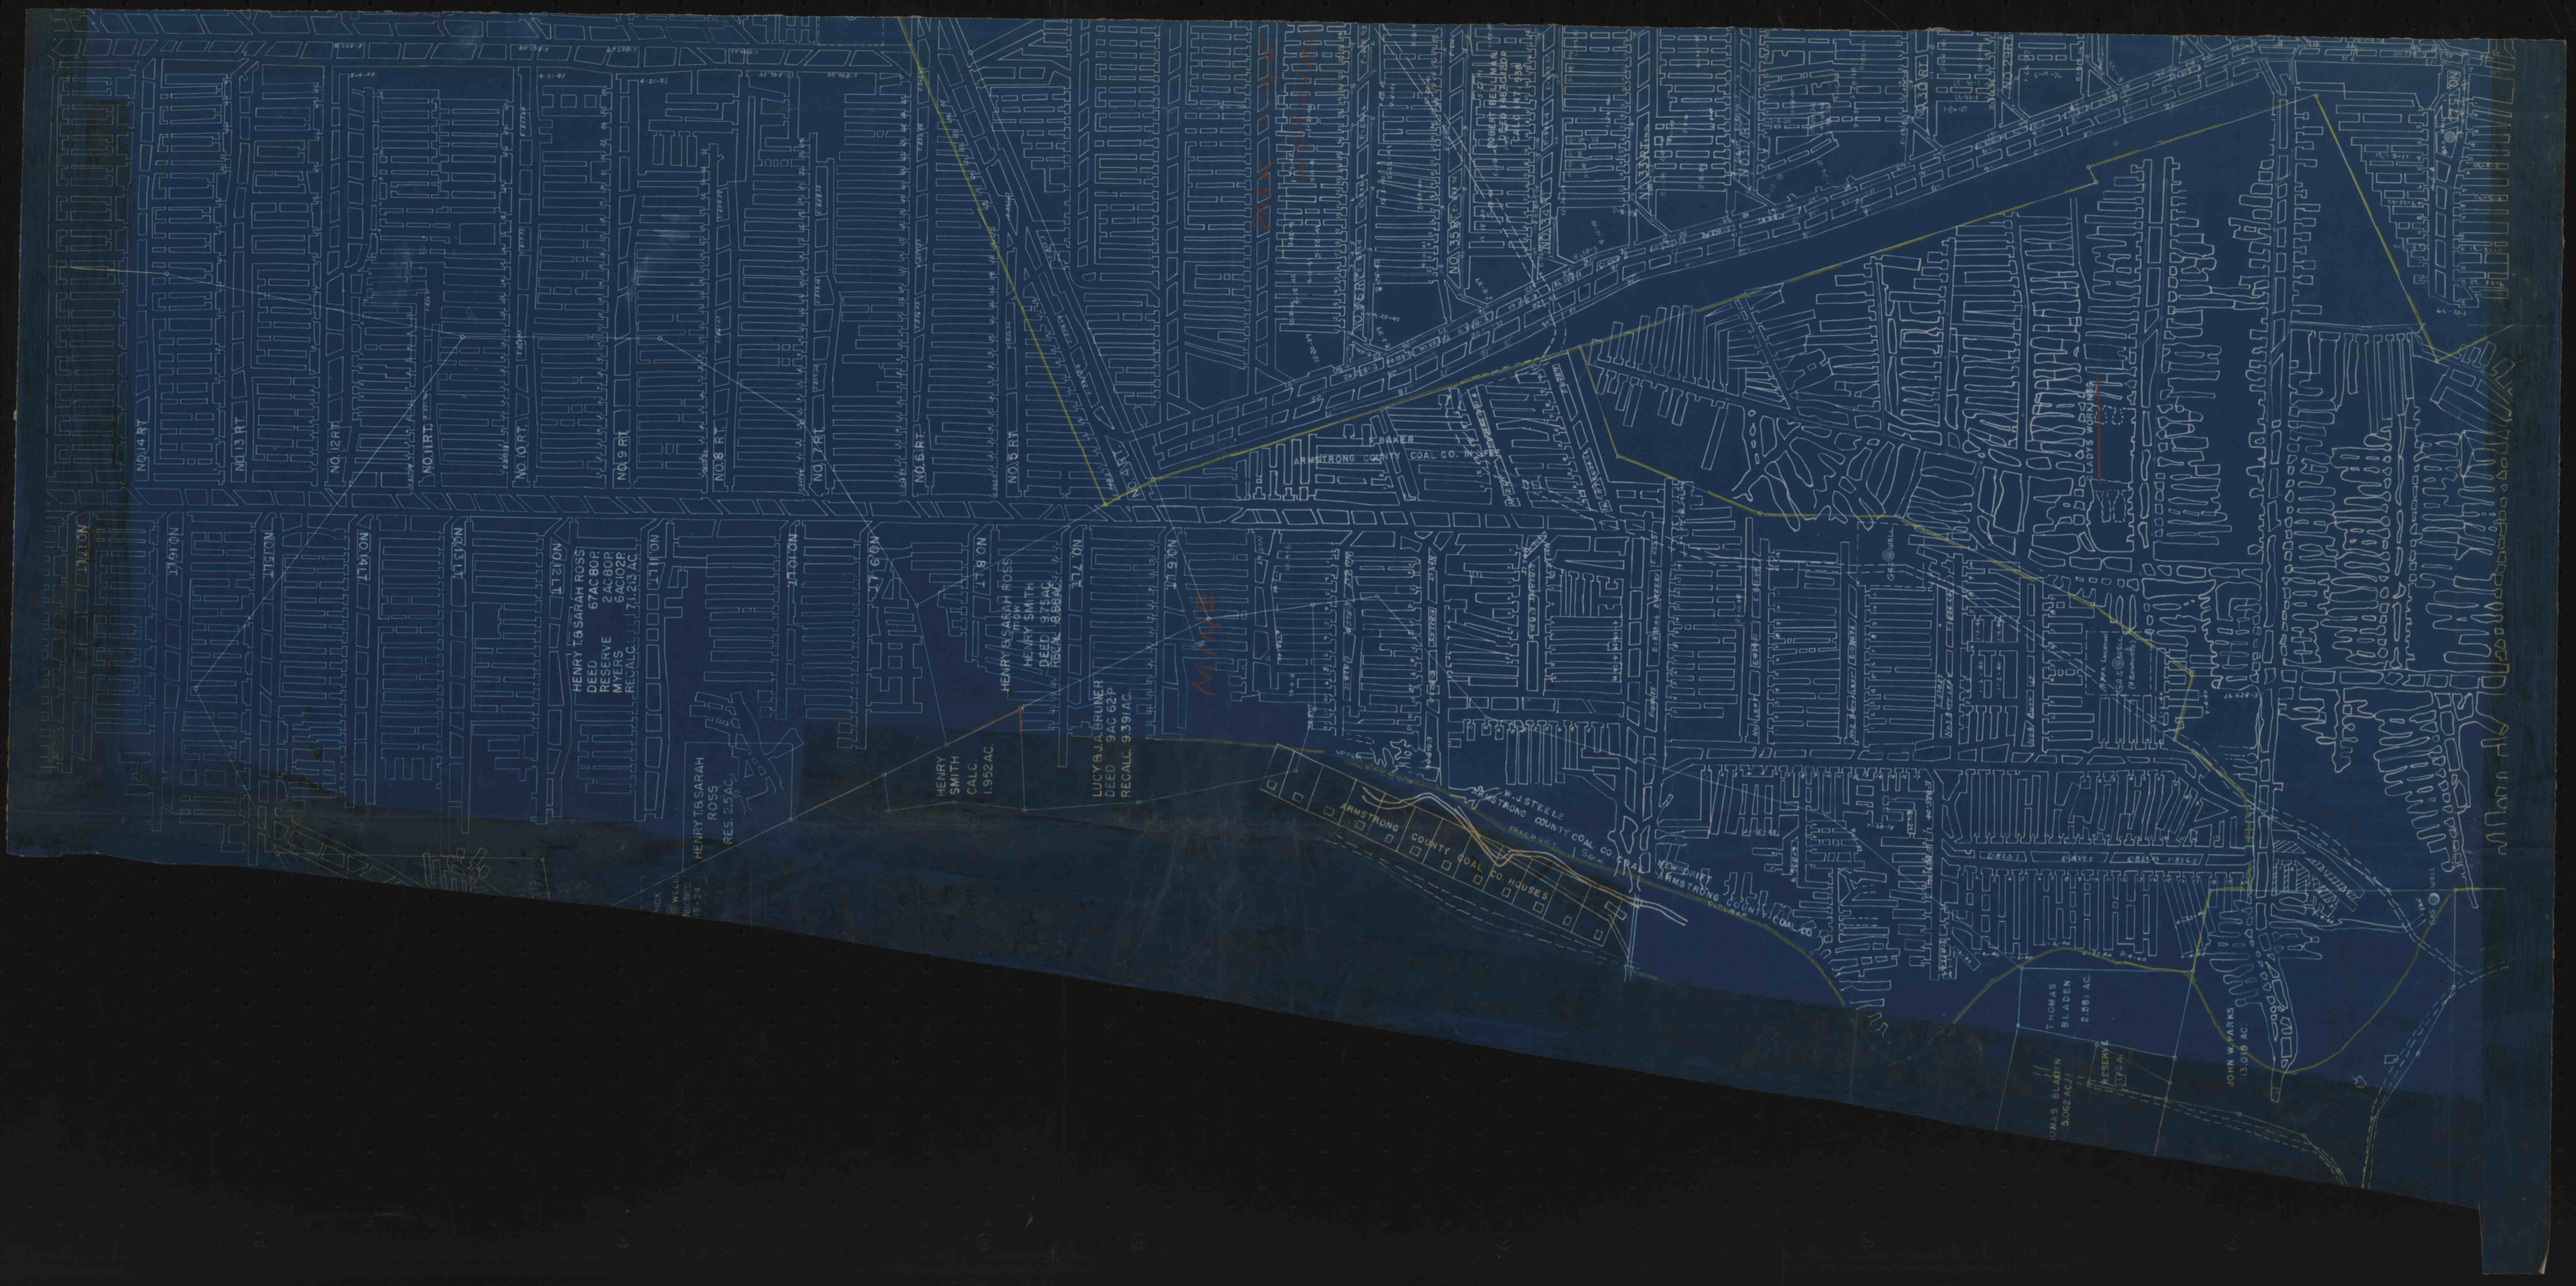
NO.14 RT.
NO.13 RT.
NO.12RT.
NO.11RT.
NO.10RT.
NO.9 RT.
NO.8 RT.
NO.7 RT.
NO.6 RT.
NO.5 RT.
NO.38
NO.39
HENRY & SARAH ROSS
DEED 67AC 80P.
RESERVE 2AC 80P.
MYERS 6AC 102P.
RECAL. 77.215 AC.
HENRY & SARAH ROSS
DEED
RECAL. 1.59 AC.
HENRY & SARAH ROSS
DEED
HENRY SMITH
DEED 9.75AC.
RECAL. 8.86AC.
HENRY SMITH
CALC
1.952AC.
LUCY & J.A. BRUNER
DEED 9AC 62P
RECAL. 9.39AC.
J. BAKER
ARMSTRONG COUNTY COAL CO. IN FEE
ARMSTRONG COUNTY COAL CO. HOUSES
W. & J. STEELE
ARMSTRONG COUNTY COAL CO.
ARMSTRONG COUNTY COAL CO.
LADYS WORKMEN
THOMAS BLADEN
2.89 AC.
RESERVE
1.72 AC.
JOHN W. PARKS
13.06 AC.