


#2067
12-29-1917
C.L.

1-C-168

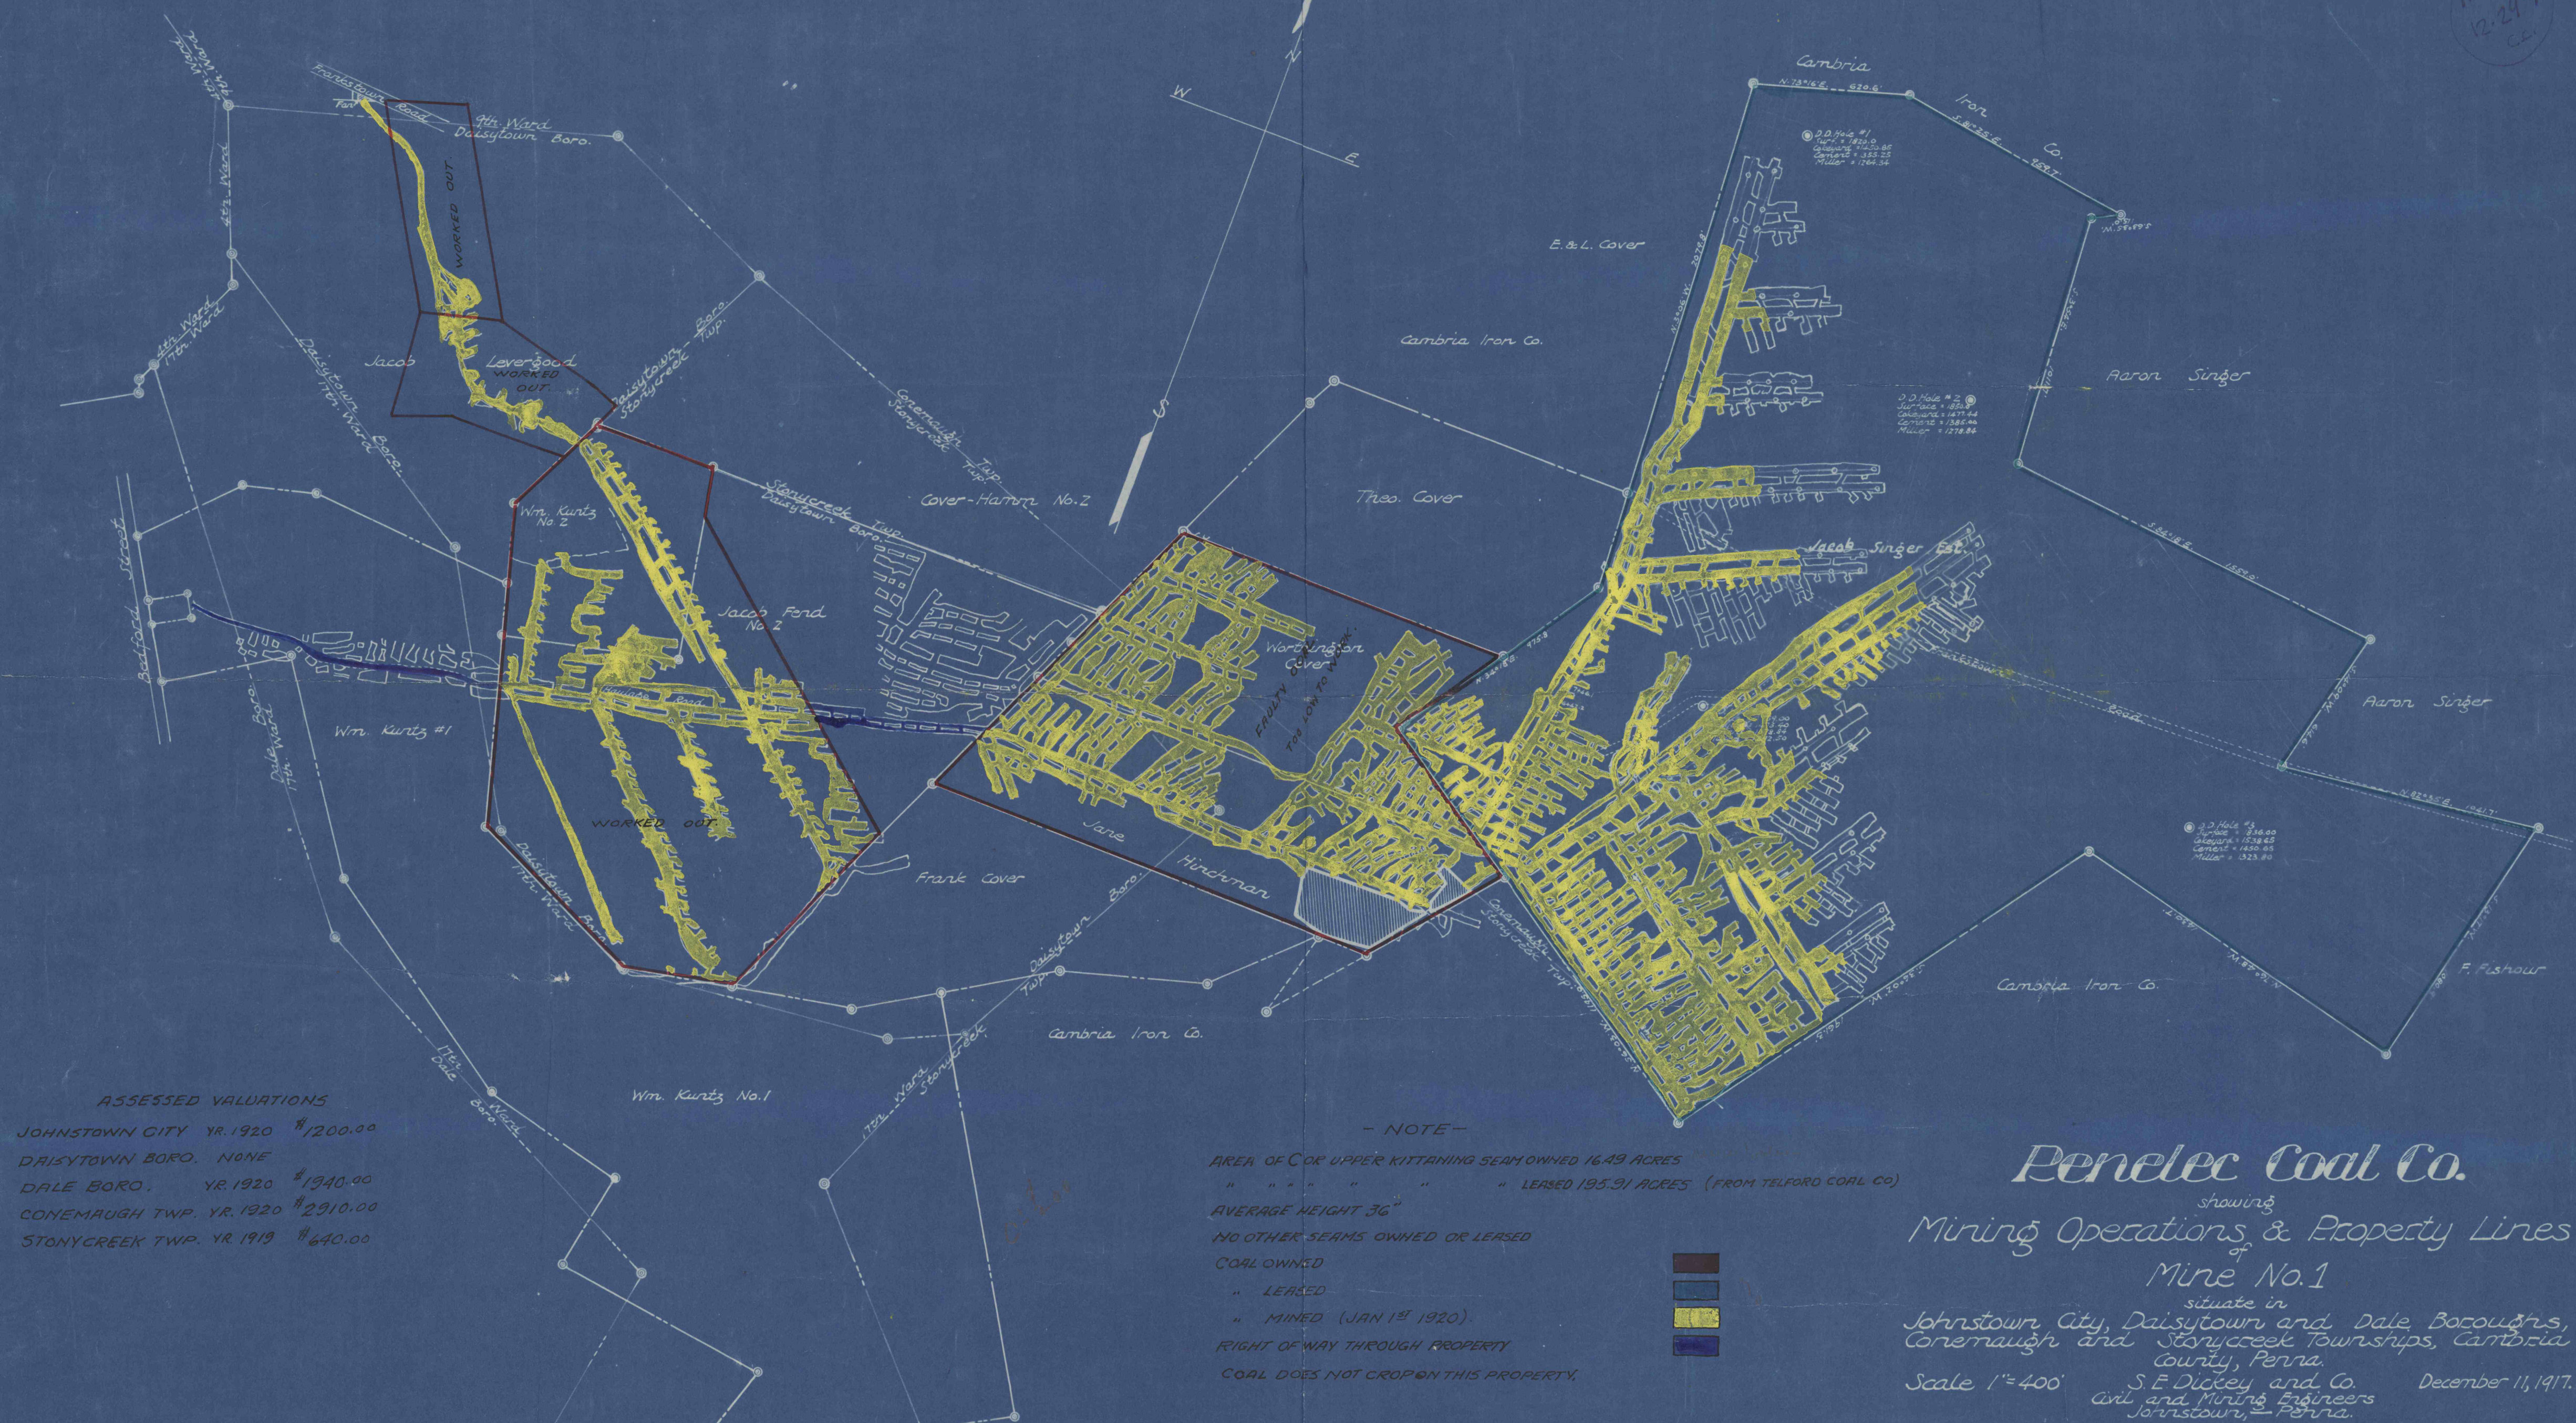

ASSESSED VALUATIONS

JOHNSTOWN CITY	YR. 1920	\$1200.00
DAISYTOWN BORO.	NONE	
DALE BORO.	YR. 1920	\$1940.00
CONEMAUGH TWP.	YR. 1920	\$2910.00
STONYCREEK TWP.	YR. 1919	\$640.00

- NOTE -
 AREA OF COAL UPPER KITTANNING SEAM OWNED 16.49 ACRES
 " " " " " " LEASED 195.91 ACRES (FROM TELFORD COAL CO.)
 AVERAGE HEIGHT 36'
 NO OTHER SEAMS OWNED OR LEASED
 COAL OWNED
 " LEASED
 " MINED (JAN 1ST 1920).
 RIGHT OF WAY THROUGH PROPERTY
 COAL DOES NOT CROP ON THIS PROPERTY.



Penelec Coal Co.
 showing
 Mining Operations & Property Lines
 of
 Mine No. 1
 situate in
 Johnstown City, Daisytown and Dale Boroughs,
 Conemaugh and Stonycreek Townships, Cambria
 County, Penna.
 Scale 1" = 400'
 S. E. Dickey and Co.
 Civil and Mining Engineers
 Johnstown, Penna.
 December 11, 1917.

EXHIBIT "A"