


DEEP MINE PROPERTY MAP
 THE PENN HILL COAL CO.
 CHERRY HILL TWP. INDIANA Co, Pa.
 JULY 5, 1966 SCALE-1"=400'
 SEAM - B. - DRAWN BY - J.C.P.

MINE SUBSIDENCE MAP.

- SUBSIDENCE BOUNDARY
- 6 MONTH EXTENSION

SEAL

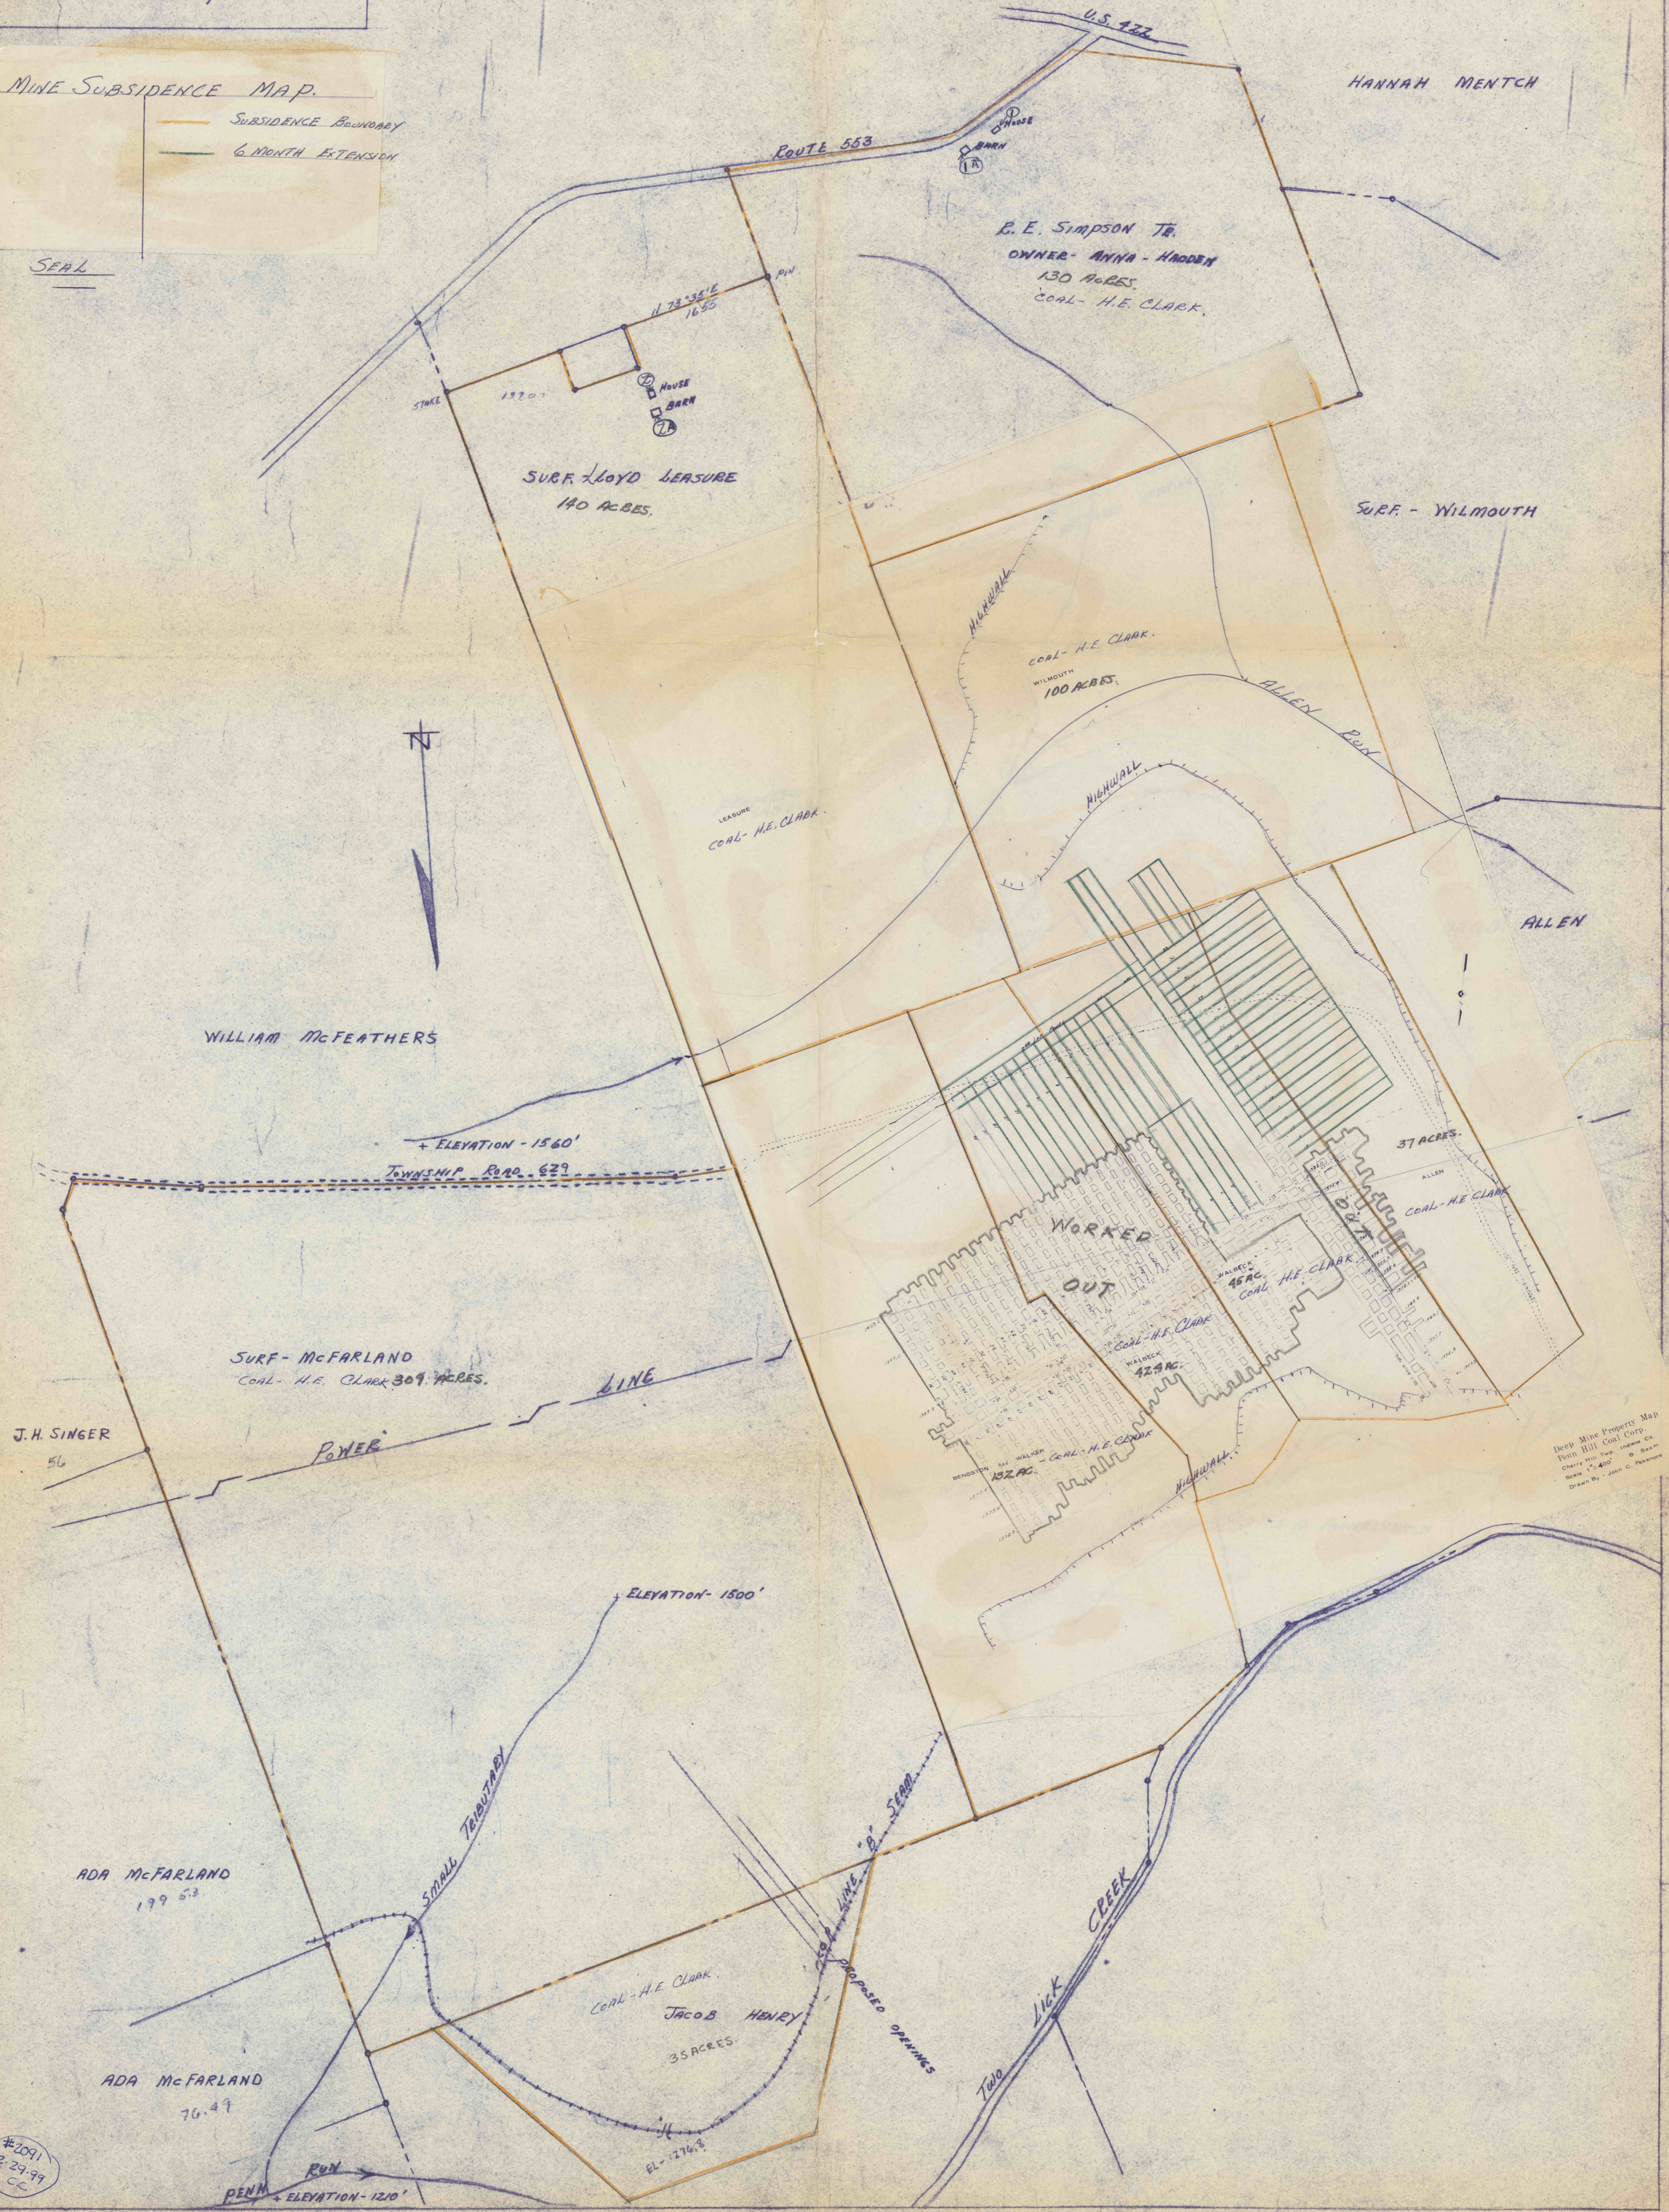

Deep Mine Property Map
 Penn Hill Coal Corp.
 Cherry Hill Twp. Indiana Co.
 Scale 1"=400' B 62-1
 Drawn By - John C. Pearson

#2091
 2-29-79
 CC