PENNSYLVANIA COLLIERIES - INC.

Map of Pretoria #1 and #2 Mines.

In Upper Kitanning Seam.

Paint Township - Somerset County - Pa.

Scale - 1" = 400 - June 26-1920

Horner - Jones Eng Co
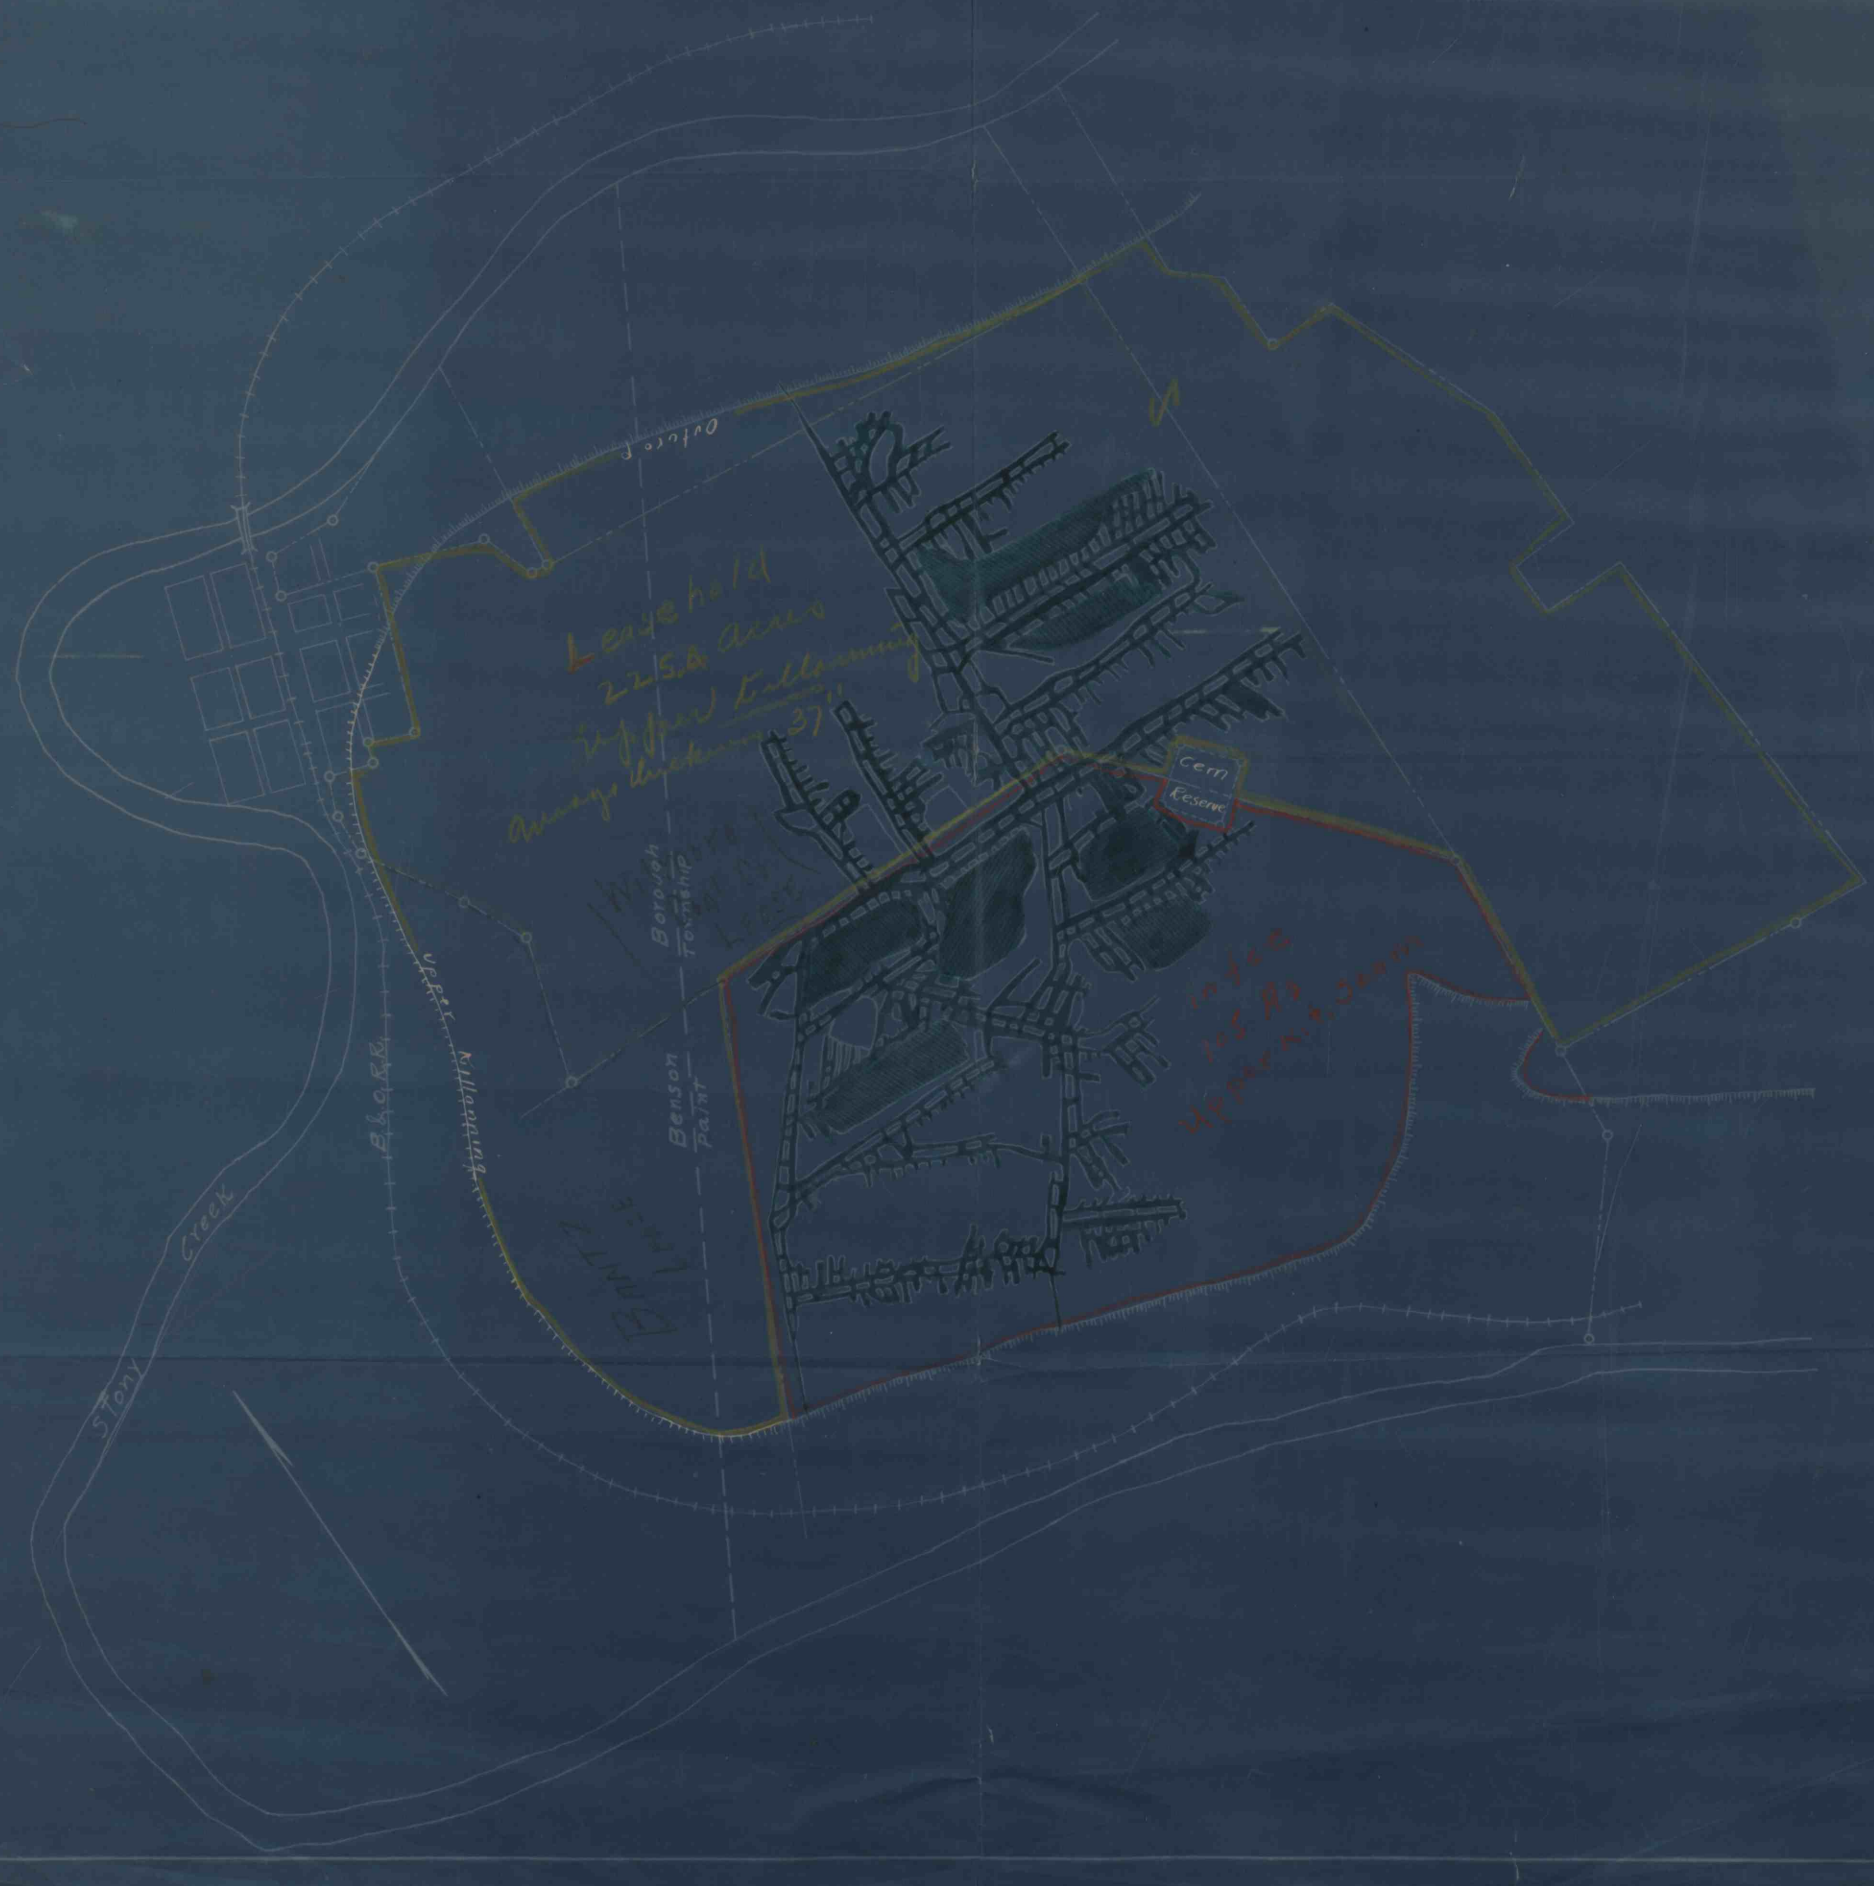
Indiana - Pa.