

GEORGE DILL  
MIN.

OLIVIN DODGE  
MIN.

CHARLES BROOKINS  
MIN.

CHARLES BROOKINS  
MIN.

5Ac.  
MIN.

REUBEN WINSLOW EST.  
FEE

LICE  
MIN.

PROCTOR #3 MINES  
SCALE 1" = 400'

NOYES-TRACT  
PETER McCLE - LOUIS CHIAPPELLI  
IN. FEE.

REUBEN WINSLOW ESTATE  
NEW SHAWMUT MINING CO. FEE

Caledonia

Hollow

ROBT COCHRAN

CALDONIA


W.H. OSTERHOUT  
MIN.

THURSTON  
MIN.

PROCTOR #3 (CALLY #1)  
NEW SHAWMUT MNG. CO.  
ST. MARYS, PA.  
MAP OF MINE AREA FOR  
MINE SUBSIDENCE AND LAND  
CONSERVATION ACT OF 1966

- █ PRESENT MINED OUT AREA
- █ LIMIT OF MINE OPERATION
- █ SURFACE STRUCTURES
- █ AREA PROPOSED TO BE MINED OUT 11-22-66-5-22-67

DATE NOV. 22, 1966  
SCALE 1" = 400'

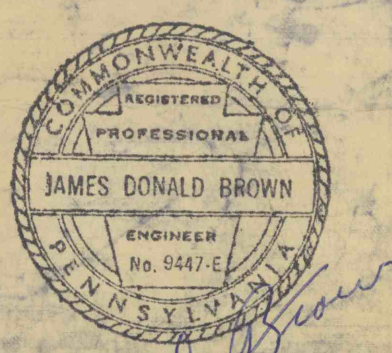

#2000  
237.4  
10