

John Marion

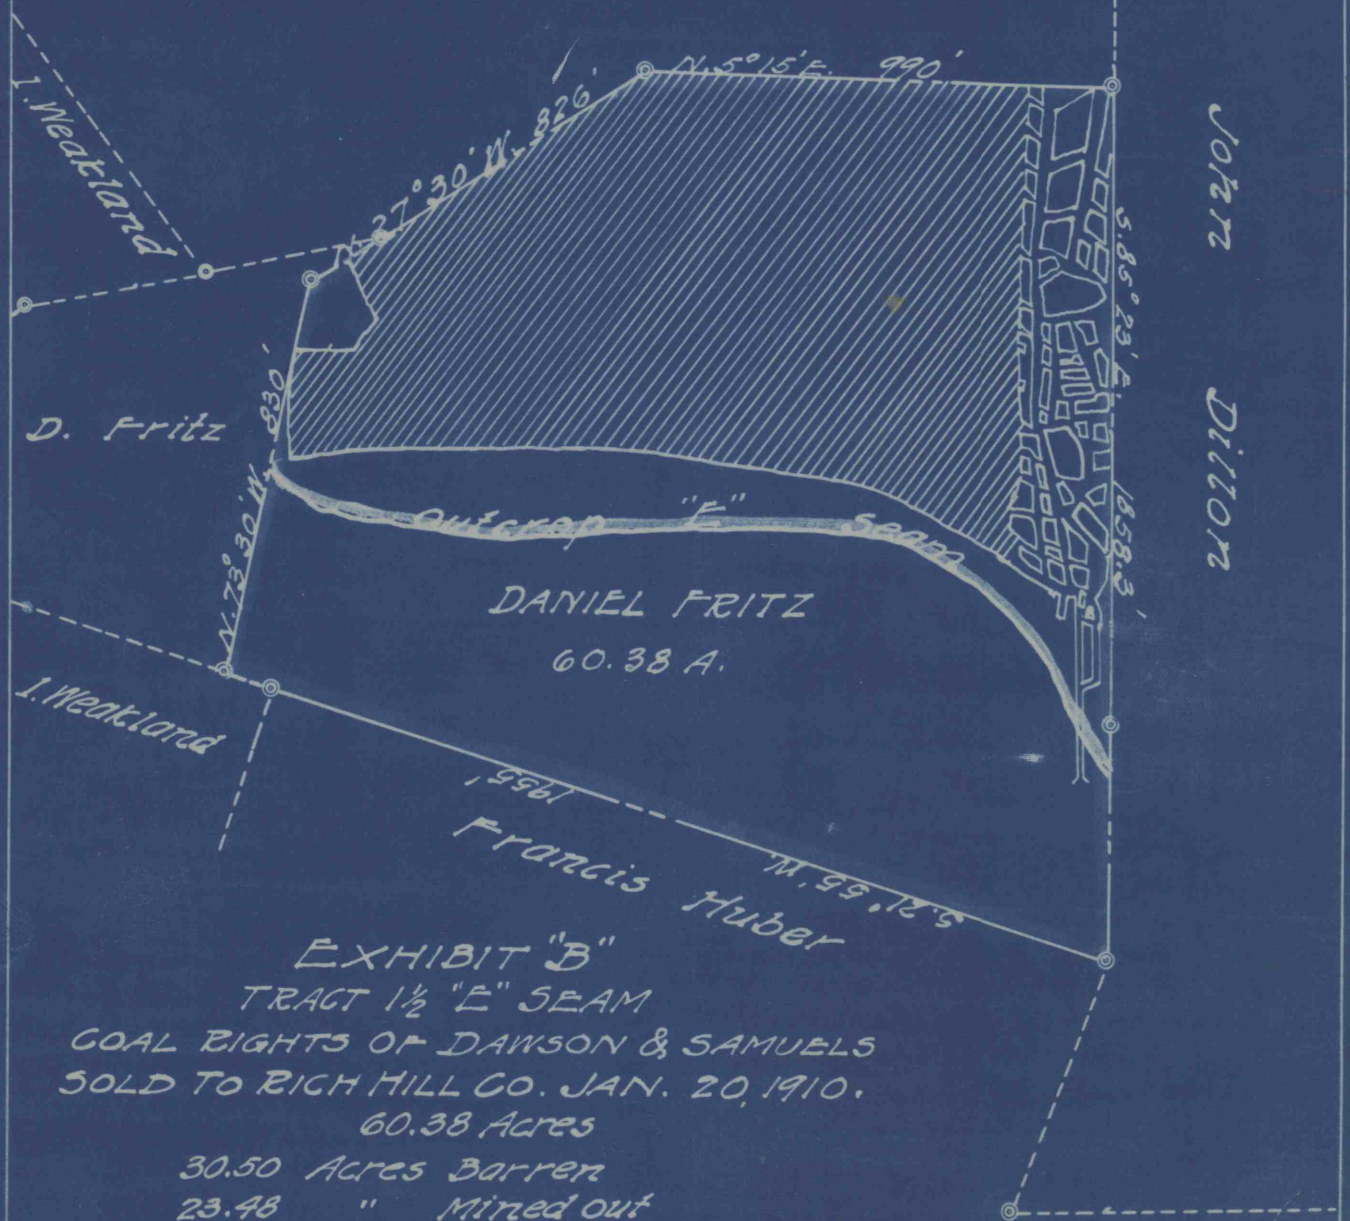


EXHIBIT "B"

TRACT 1 1/2 "E" SEAM

COAL RIGHTS OF DAWSON & SAMUELS
SOLD TO RICH HILL CO. JAN. 20, 1910.


60.38 Acres

30.50 Acres Barren

23.48 " Mined out

6.40 " Coal Remaining

20,000 Tons of Coal estimated

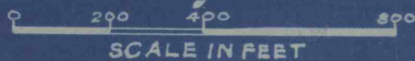

SCALE IN FEET

Rich Hill Coal Co.
Hastings, Pa.