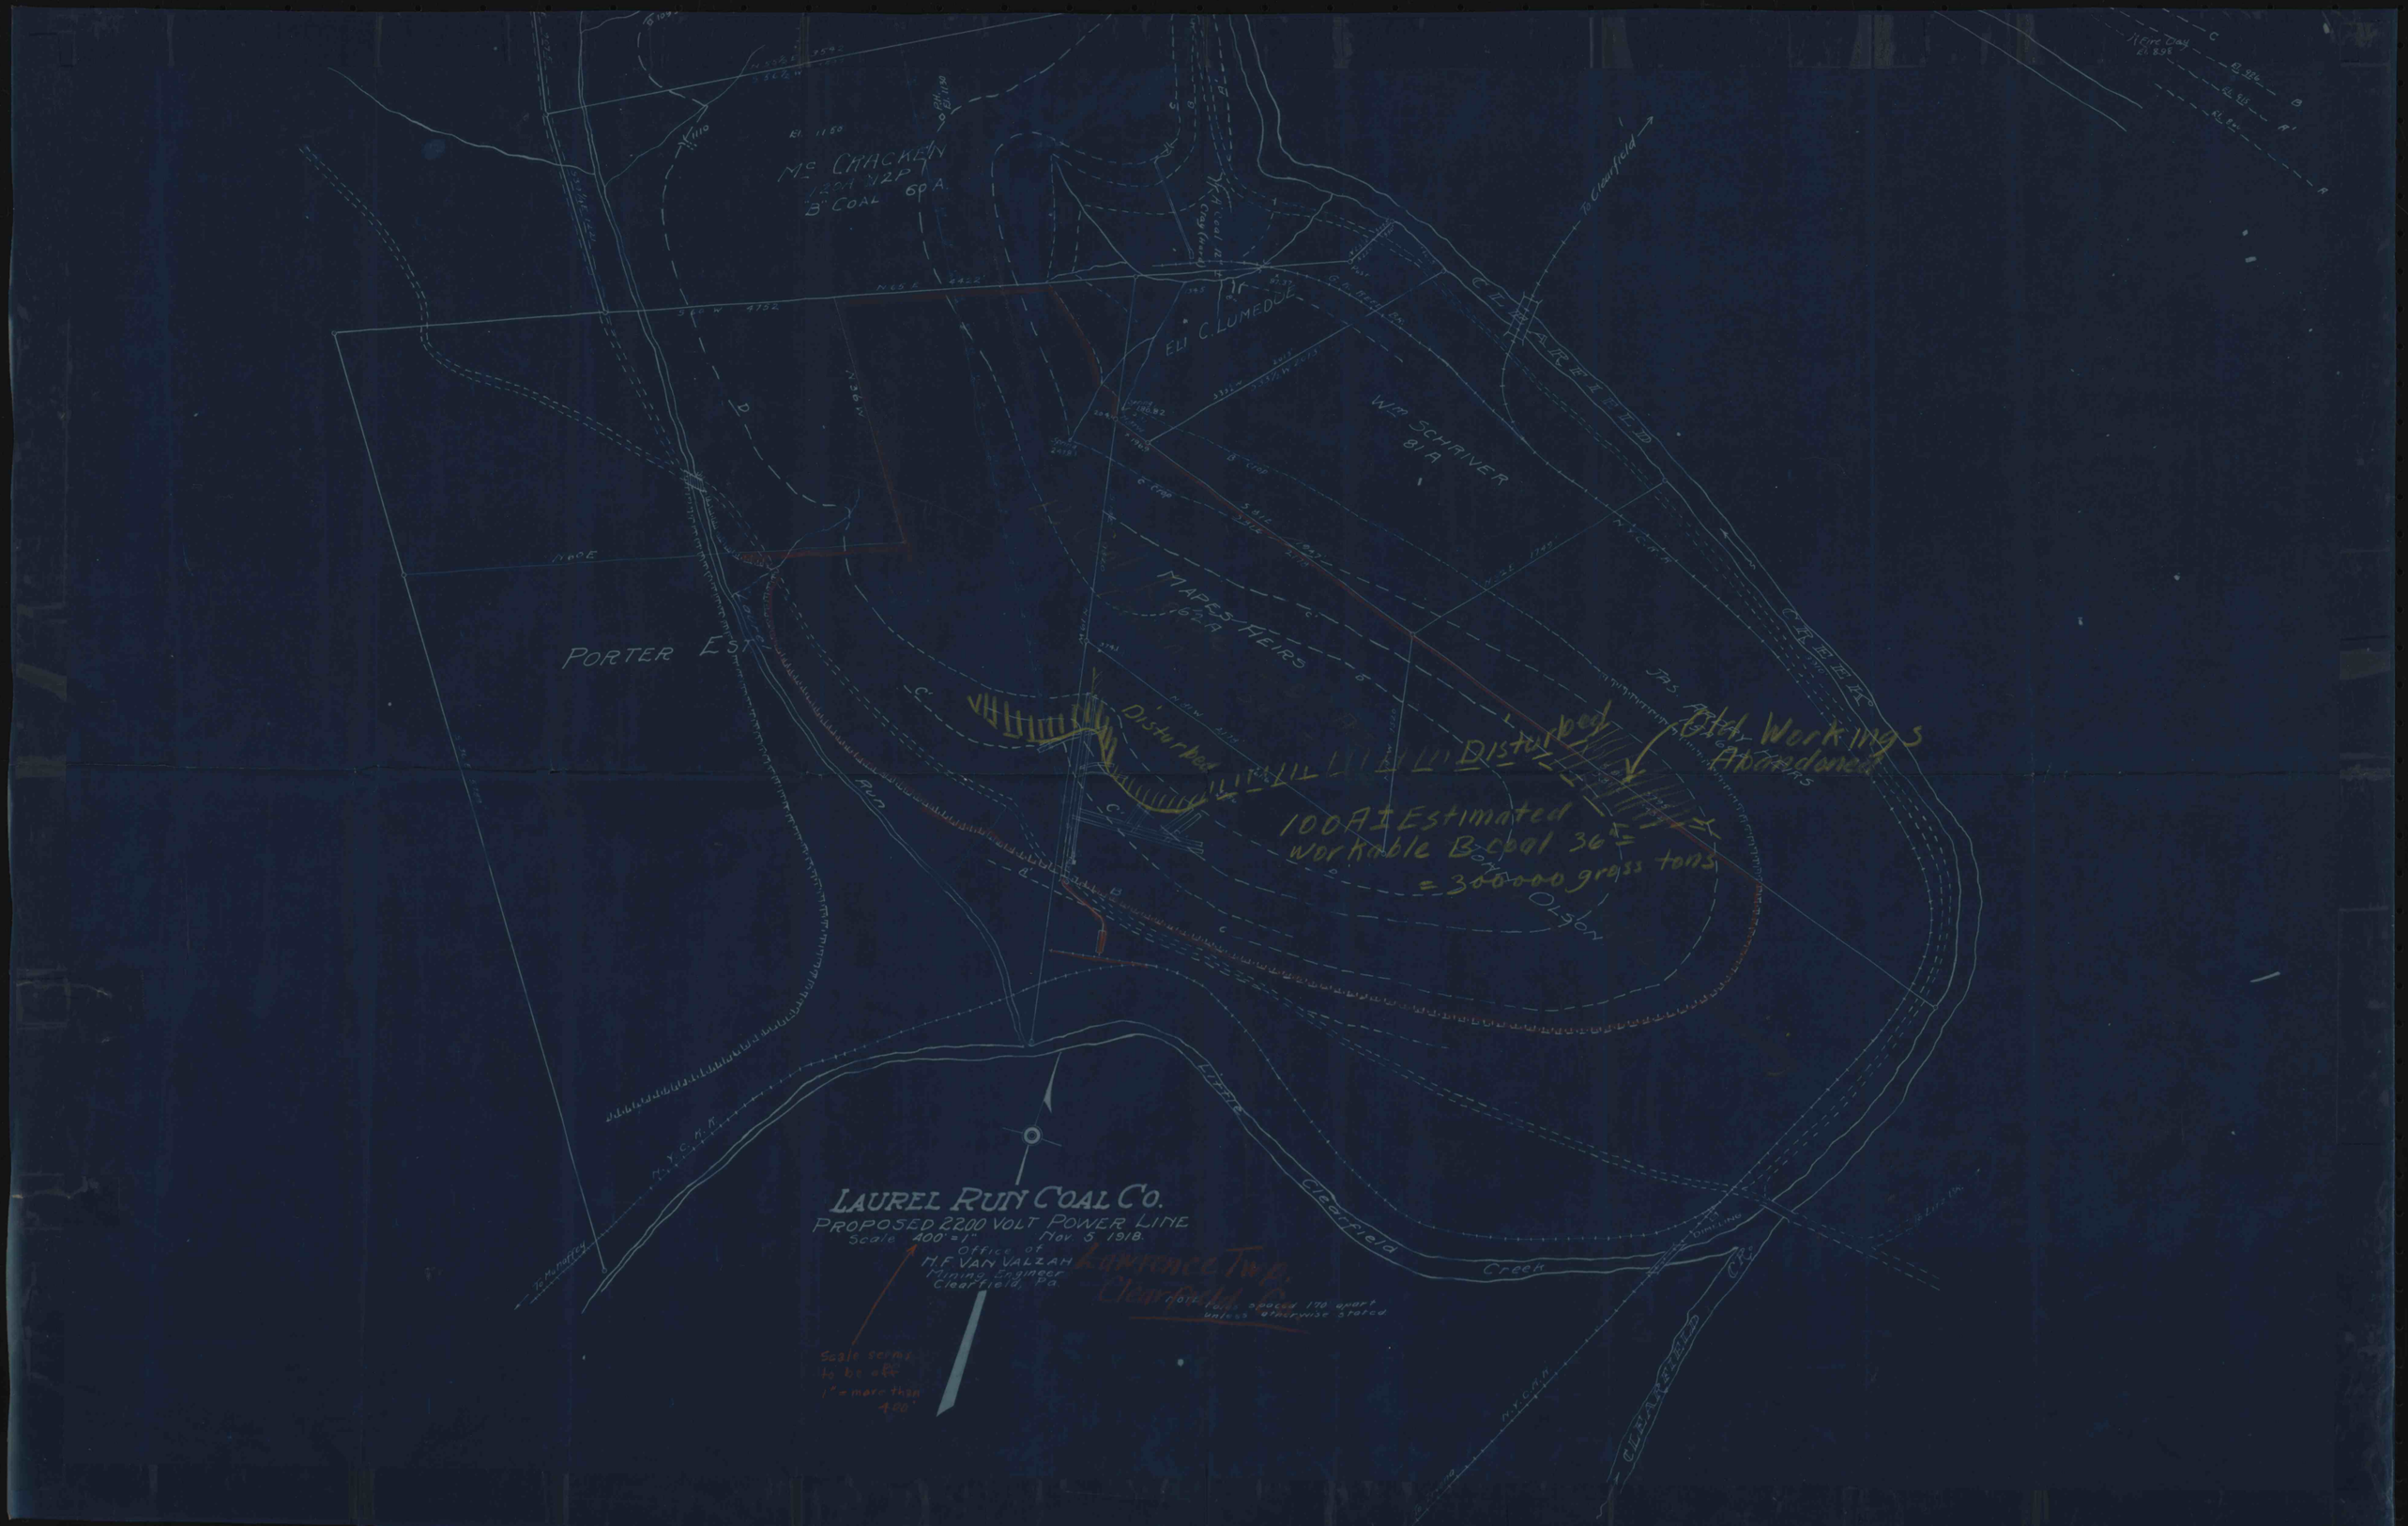

McCRACKEN
120A M2P
"B" COAL 60A
ELI C. LUMEDUE
Wm SCHRIVER
81A
MAPES HEIRS
162A
PORTER EST
CLEARFIELD
CREEK
To Clearfield
Disturbed
Old Workings
Abandoned
100A I Estimated
workable B coal 36"
= 300000 gross tons
Little
Clearfield
Creek
LAUREL RUN COAL CO.
PROPOSED 2200 VOLT POWER LINE
Scale 400' = 1"
Nov. 5 1918.
Office of
H.F. VAN VALZAH
Mining Engineer
Clearfield, Pa.
Lawrence Twp.
Clearfield Co.
Poles spaced 170 apart
unless otherwise stated
Scale seems
to be off
1" = more than
400'