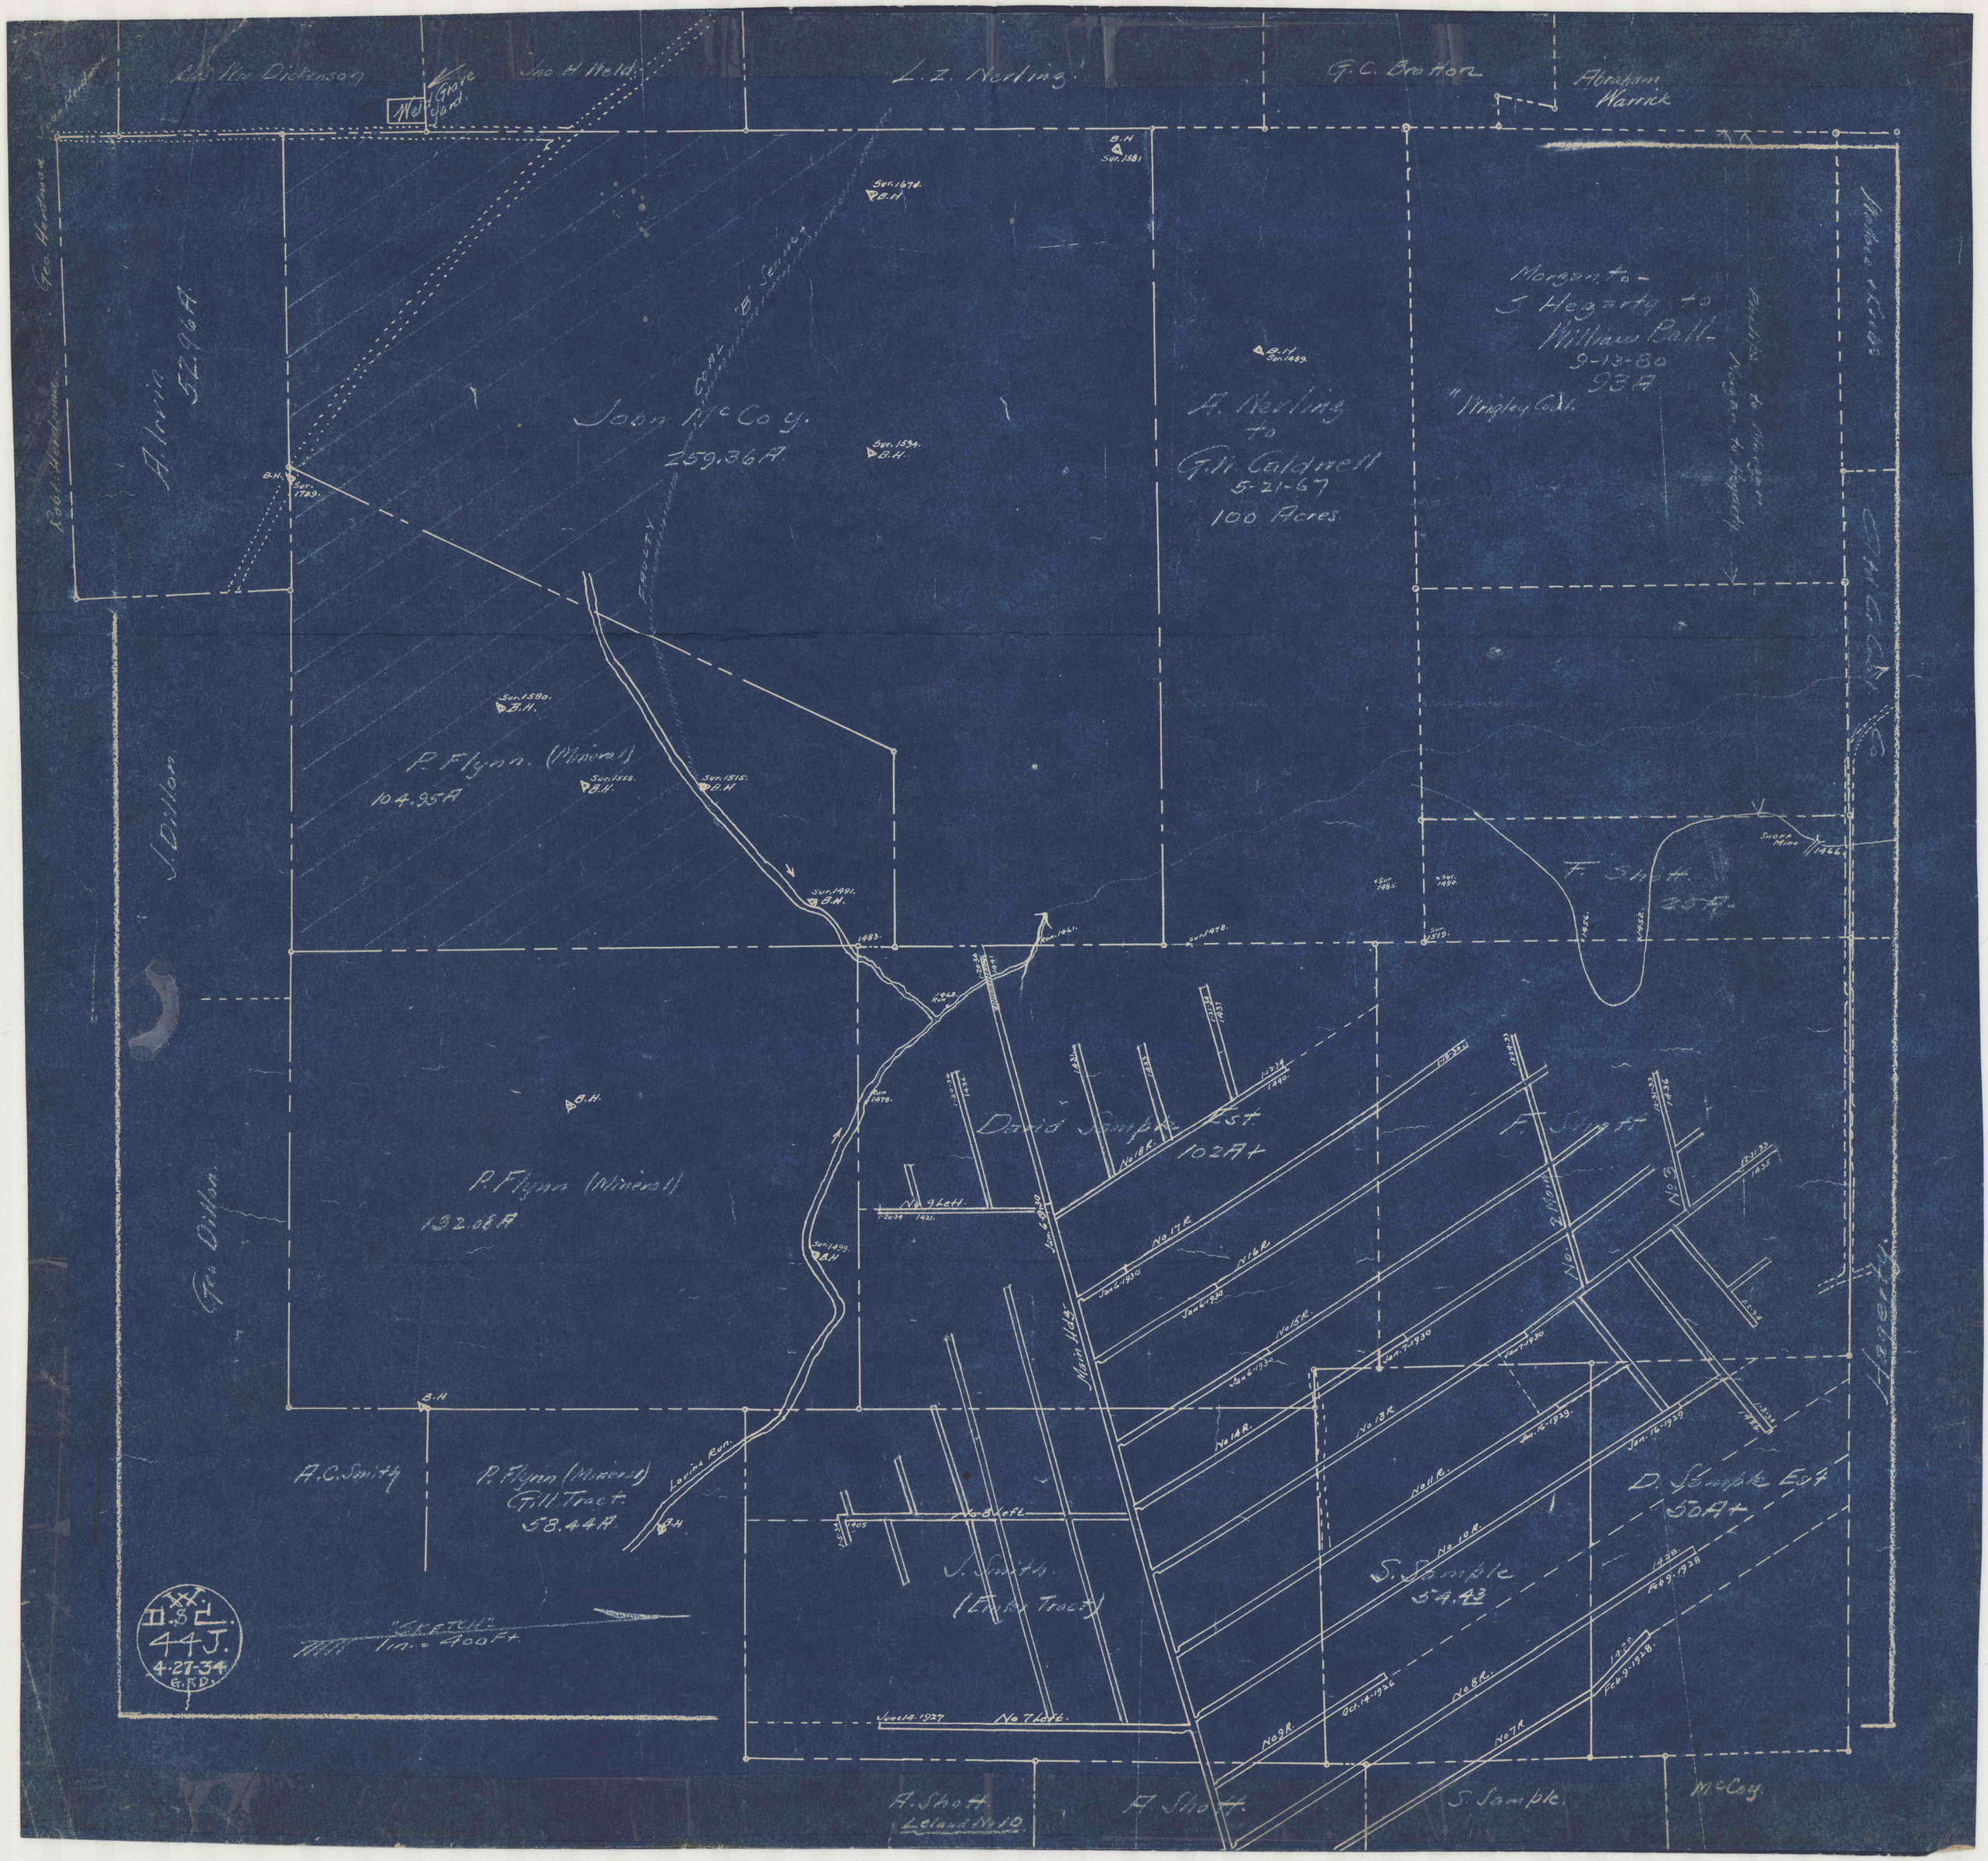
Chas Wm Dickenson
Jno H Held
L. I. Nerling
G. C. Brotton
Abraham Warrick
Geo. Henderson
Robt. Henderson
Alvin 52.96A.
Joan McCoy.
259.36A.
A. Nerling to G.H. Caldwell 5-21-67 100 Acres
Morgan to J Hegarty to William Ball 9-13-80 93A
"Wrigley Cols.
P. Flynn. (Mineral)
104.95A
P. Flynn (Mineral)
132.08A
F. Shott
25A.
David Sample Est
102A+
F. Shott
A.C. Smith
P. Flynn (Mineral) Gill Tract 58.44A.
J. Smith (Eldo Tract)
S. Sample
54.43
D. Sample Est
50A+
A. Shott
F. Shott
S. Sample
McCoy
Lewis Run
Main Alley
No 9 Lott
No 8 Lott
No 7 Lott
No 18 R.
No 17 R.
No 16 R.
No 15 R.
No 14 R.
No 13 R.
No 12 R.
No 10 R.
No 9 R.
No 8 R.
No 7 R.
Jan 6-1930
Jan 7-1930
Jan 16-1929
Oct. 14-1926
June 14-1927
Feb 9-1928
"Scale" 1in. = 400ft
U.S.C. 44J. 4-27-34 G.F.D.