


B Coal Lease
 94A ummined = 282000 gross tons
TROJAN COAL MINING CO
#1 MINE

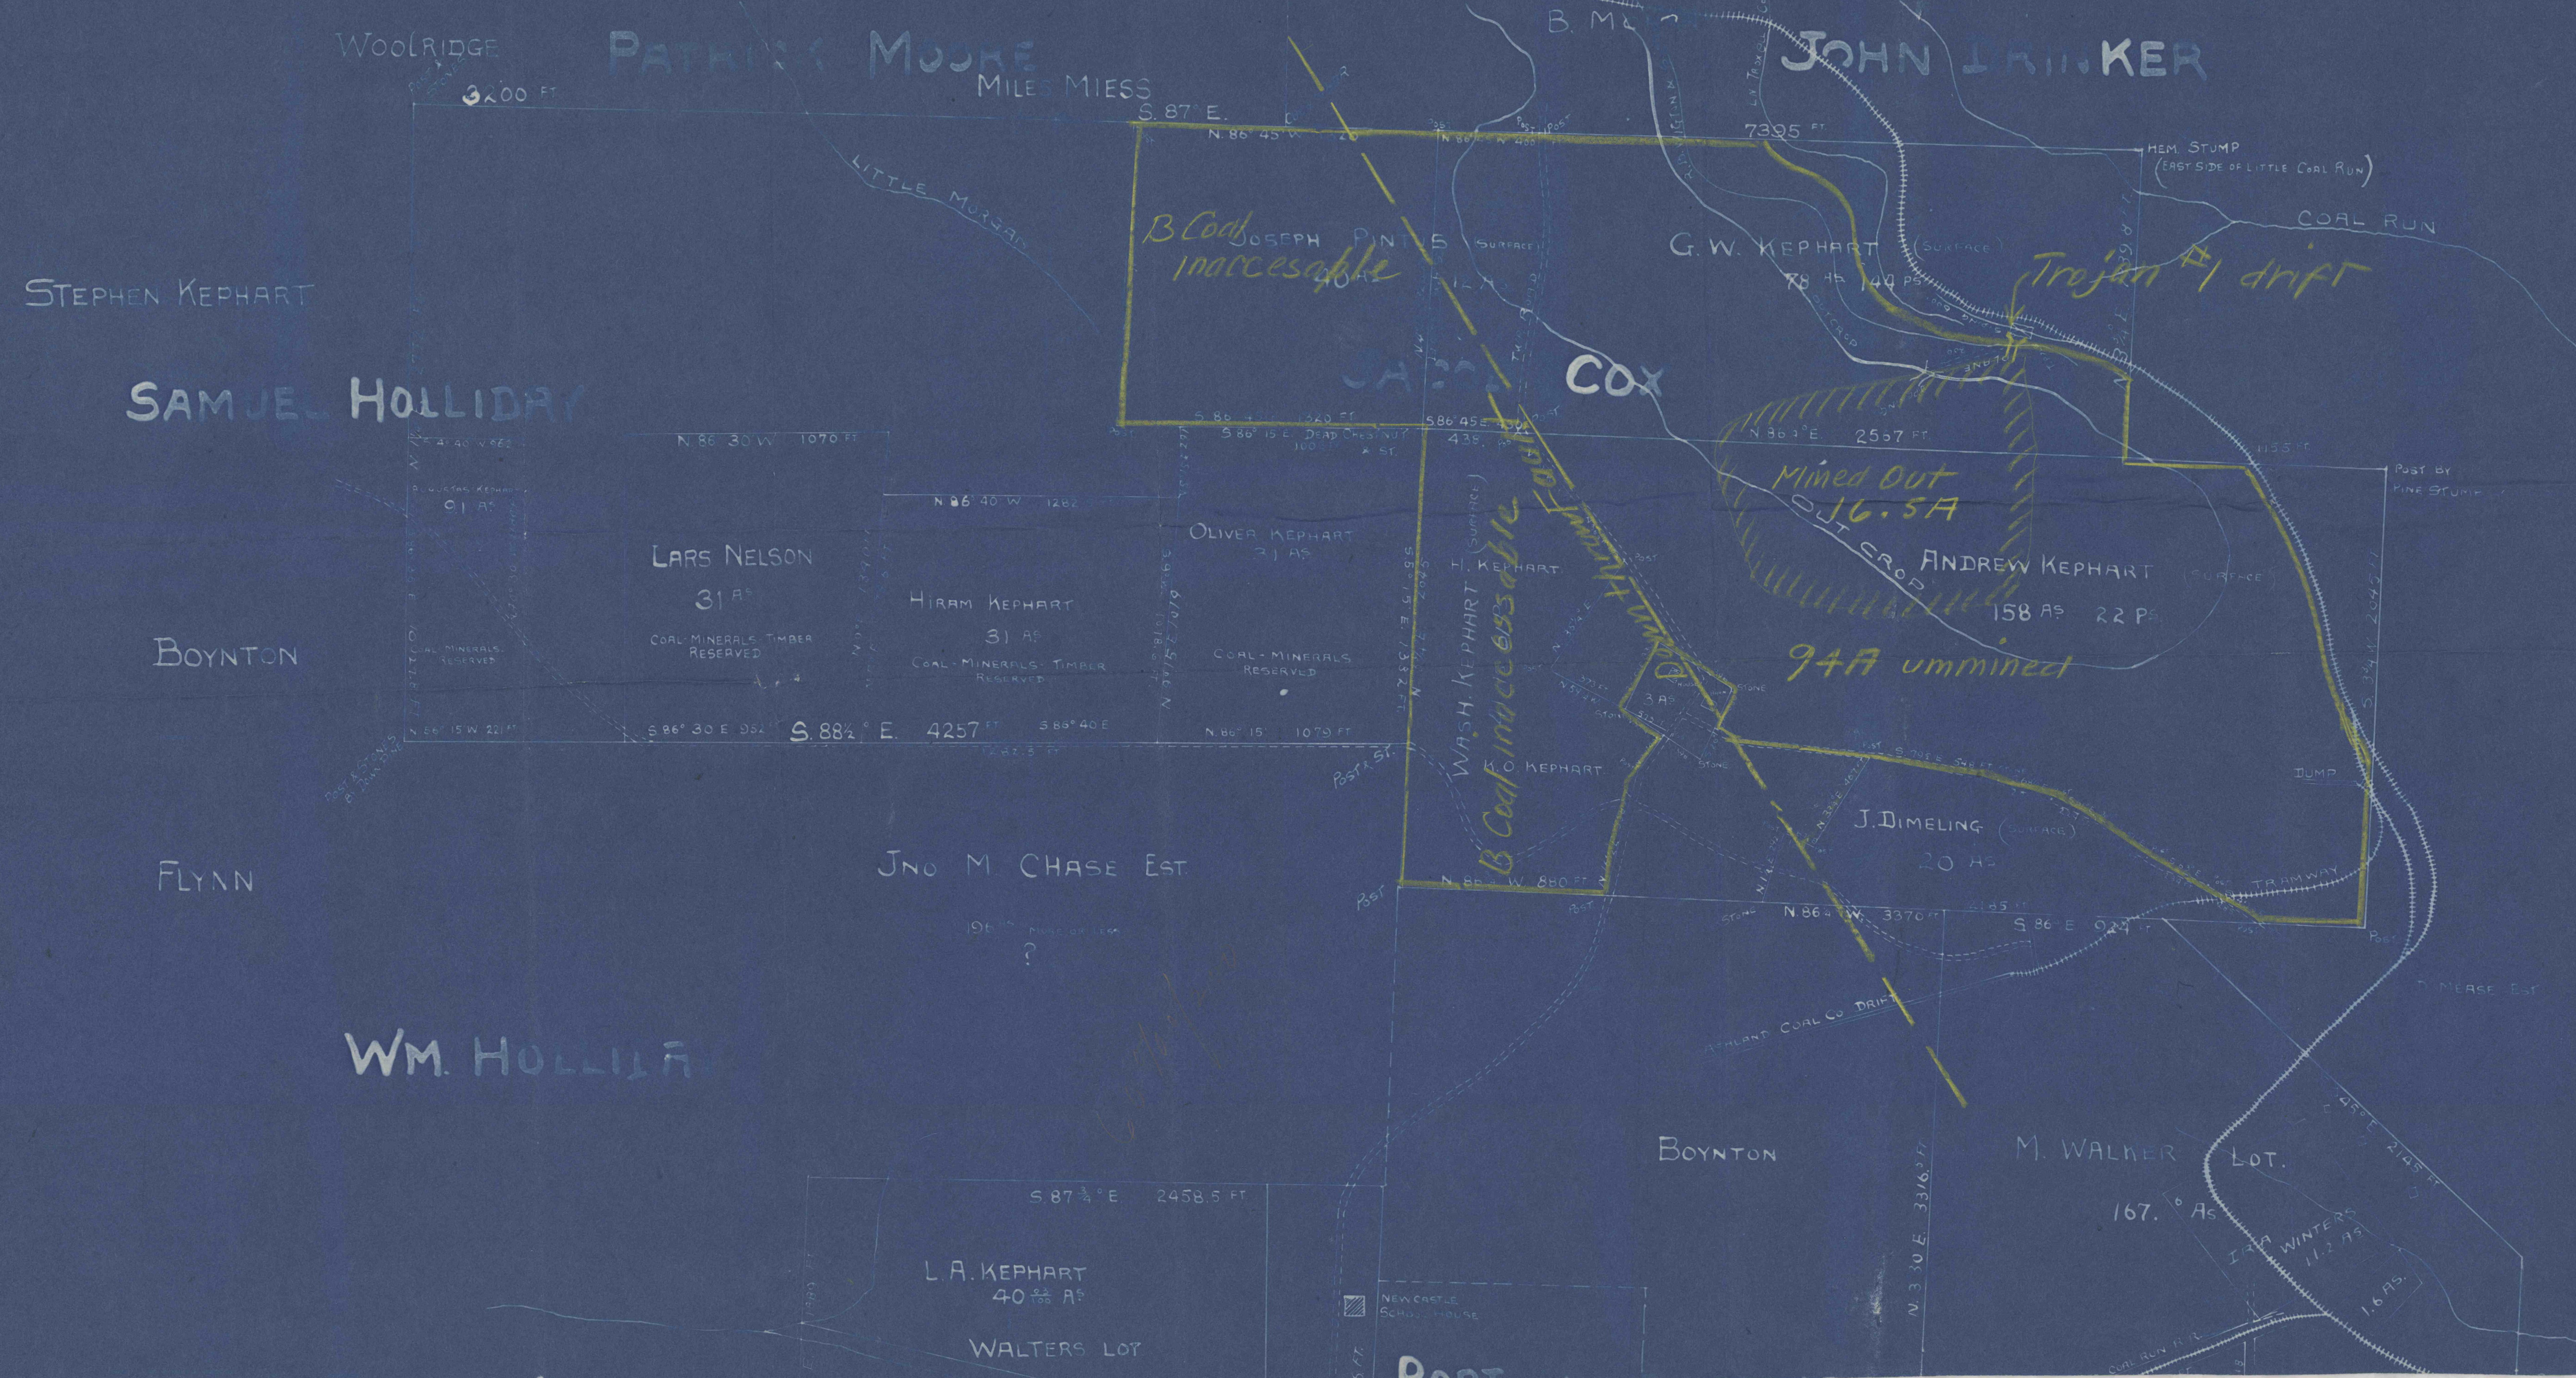

COAL RUN PROPERTY
 OF
 Reading, Richey & Wallace,
 Decatur Twp Clearfield Co, Pa.
 AREA 865.9 AS.
 Scale: 1 inch = 400 feet

Average height of B Coal
 40"