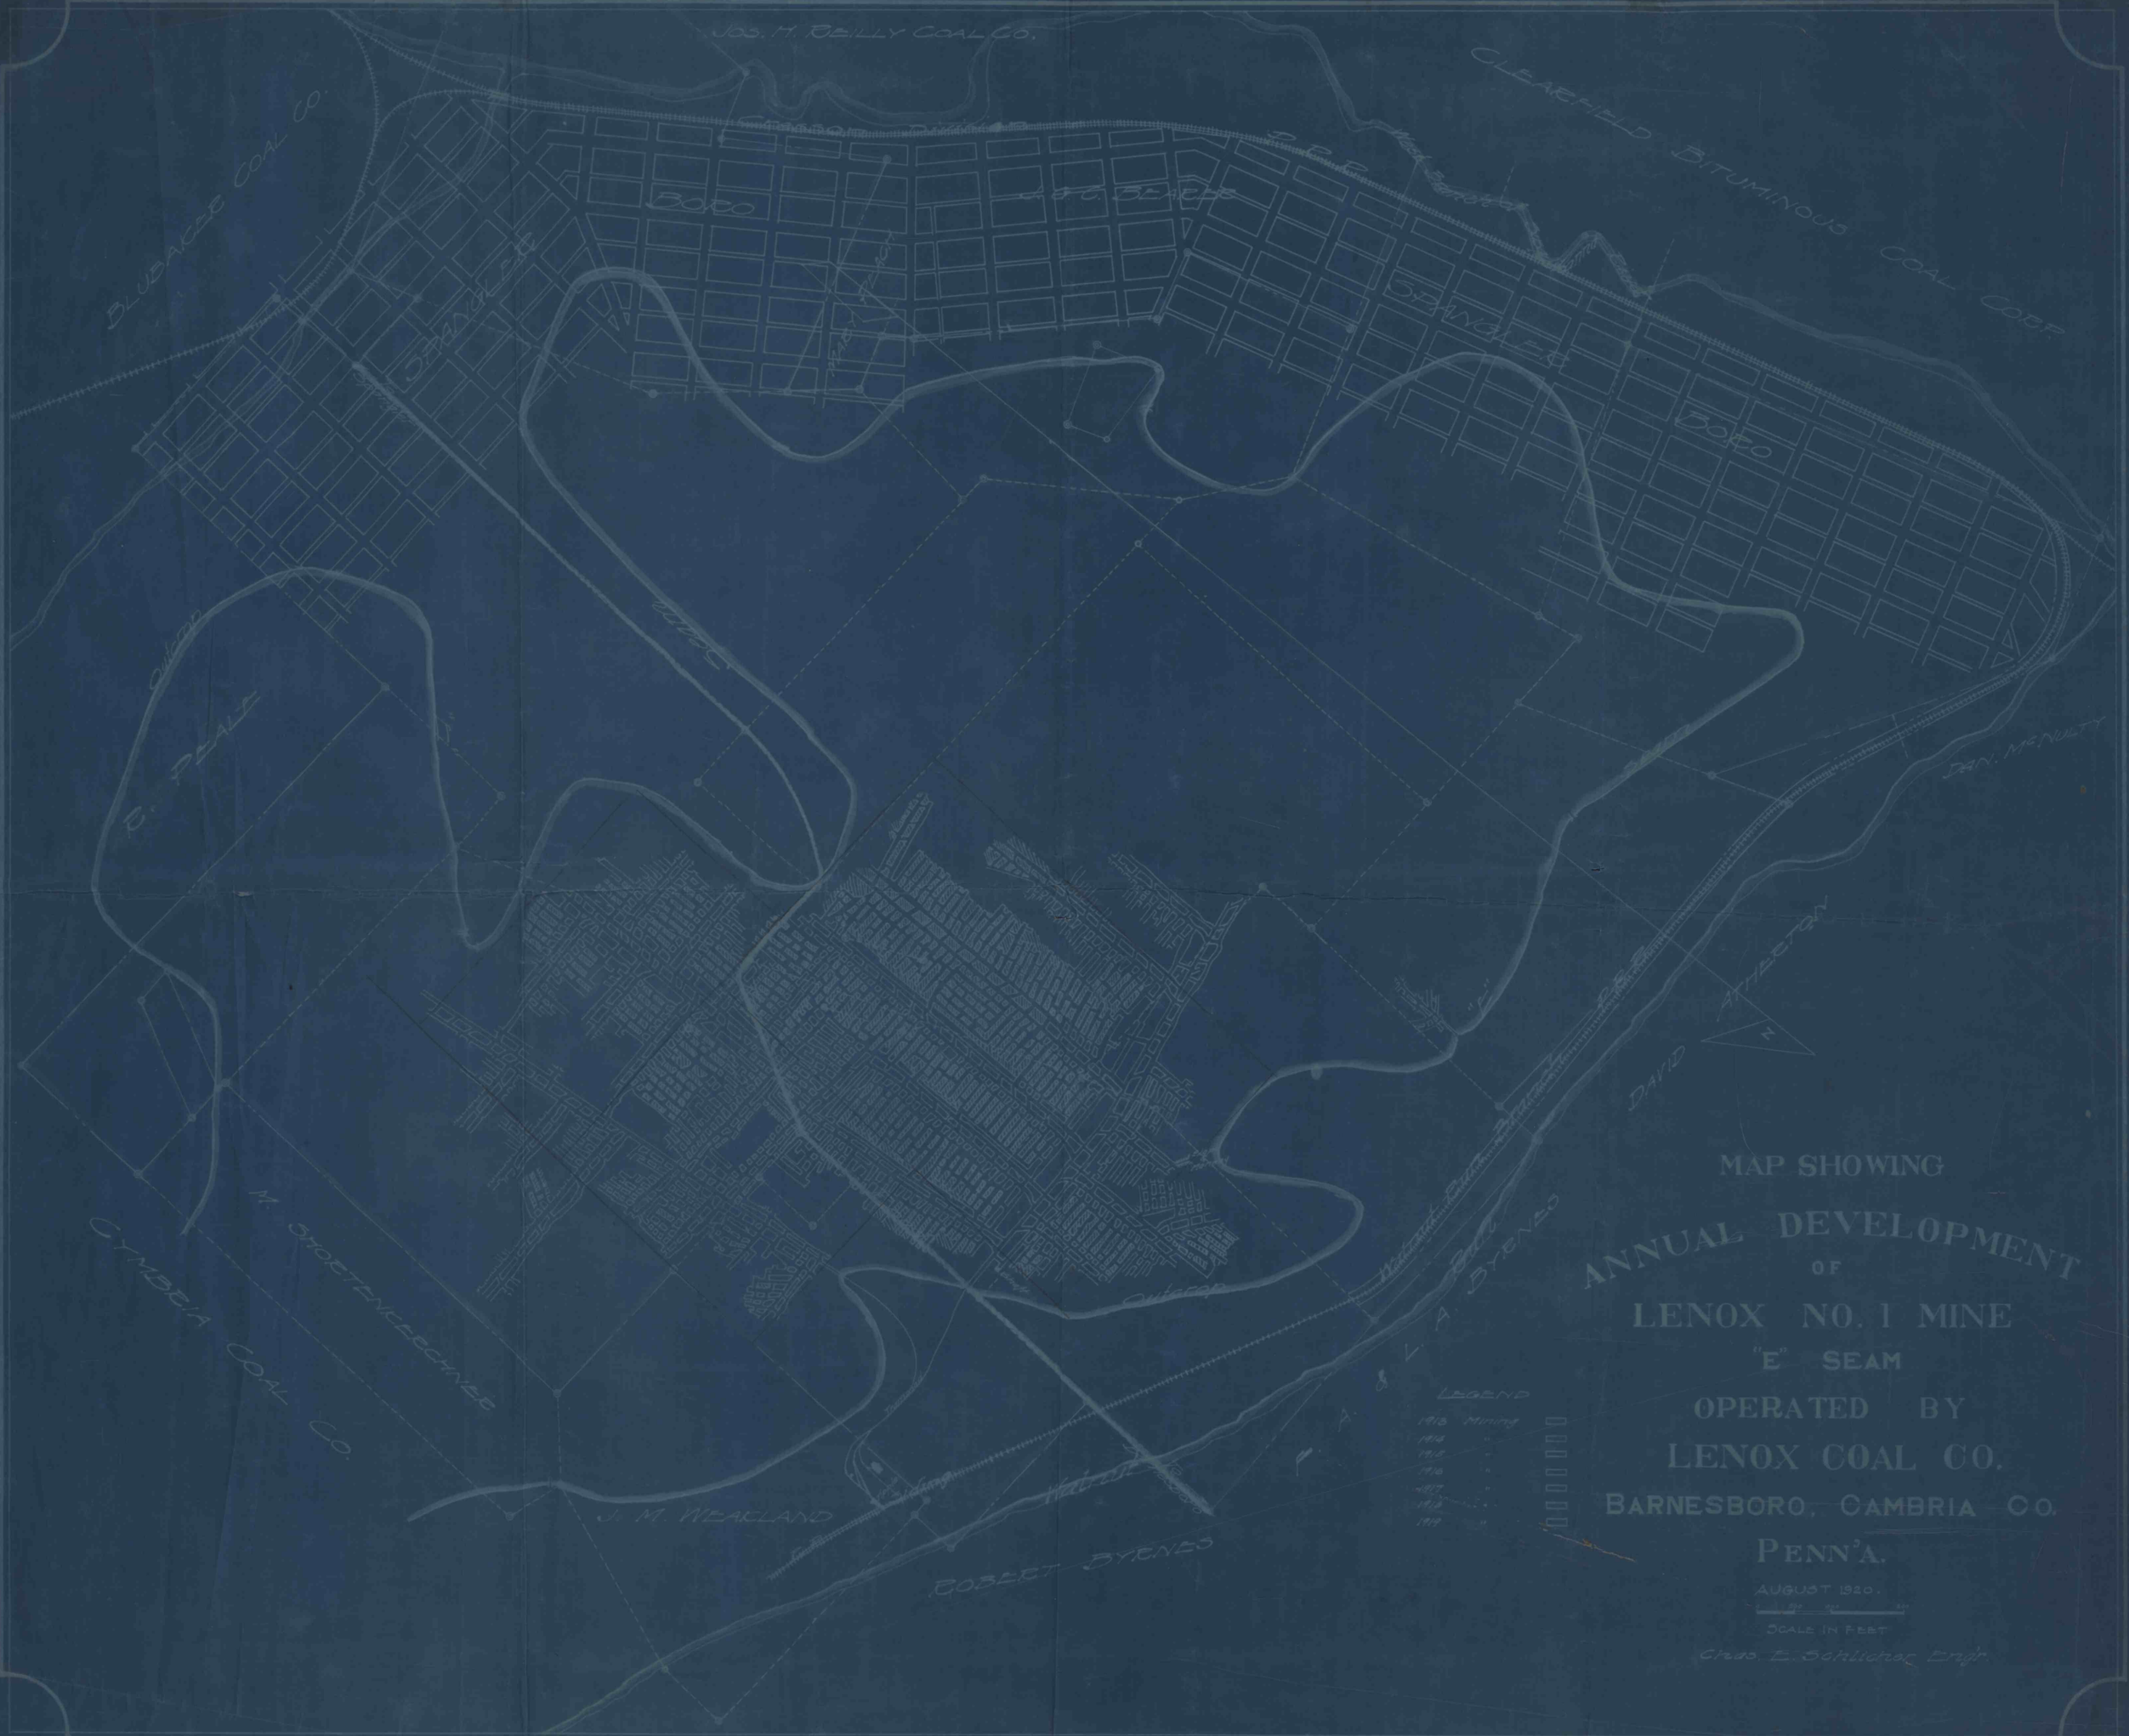
JOS. H. REILLY COAL CO.
CLEARFIELD BITUMINOUS COAL CORP.
BLUBAKER COAL CO.
BORO
J. & C. BEARER
SPANGLER
BORO
SPANGLER
R. PEALE
DAN. McNULTY
DAVID ATHERTON
M. SHORTENKERCHNER
CYMBRIA COAL CO.
J. M. WEAKLAND
ROBERT BYRNES
P. A. & L. A. BYRNES
LEGEND
1913 Mining
1914 "
1915 "
1916 "
1917 "
1918 "
1919 "
MAP SHOWING
ANNUAL DEVELOPMENT
OF
LENOX NO. 1 MINE
"E" SEAM
OPERATED BY
LENOX COAL CO.
BARNESBORO, CAMBRIA CO.
PENN'A.
AUGUST 1920.
SCALE IN FEET
Chas. E. Schlicher Engr.