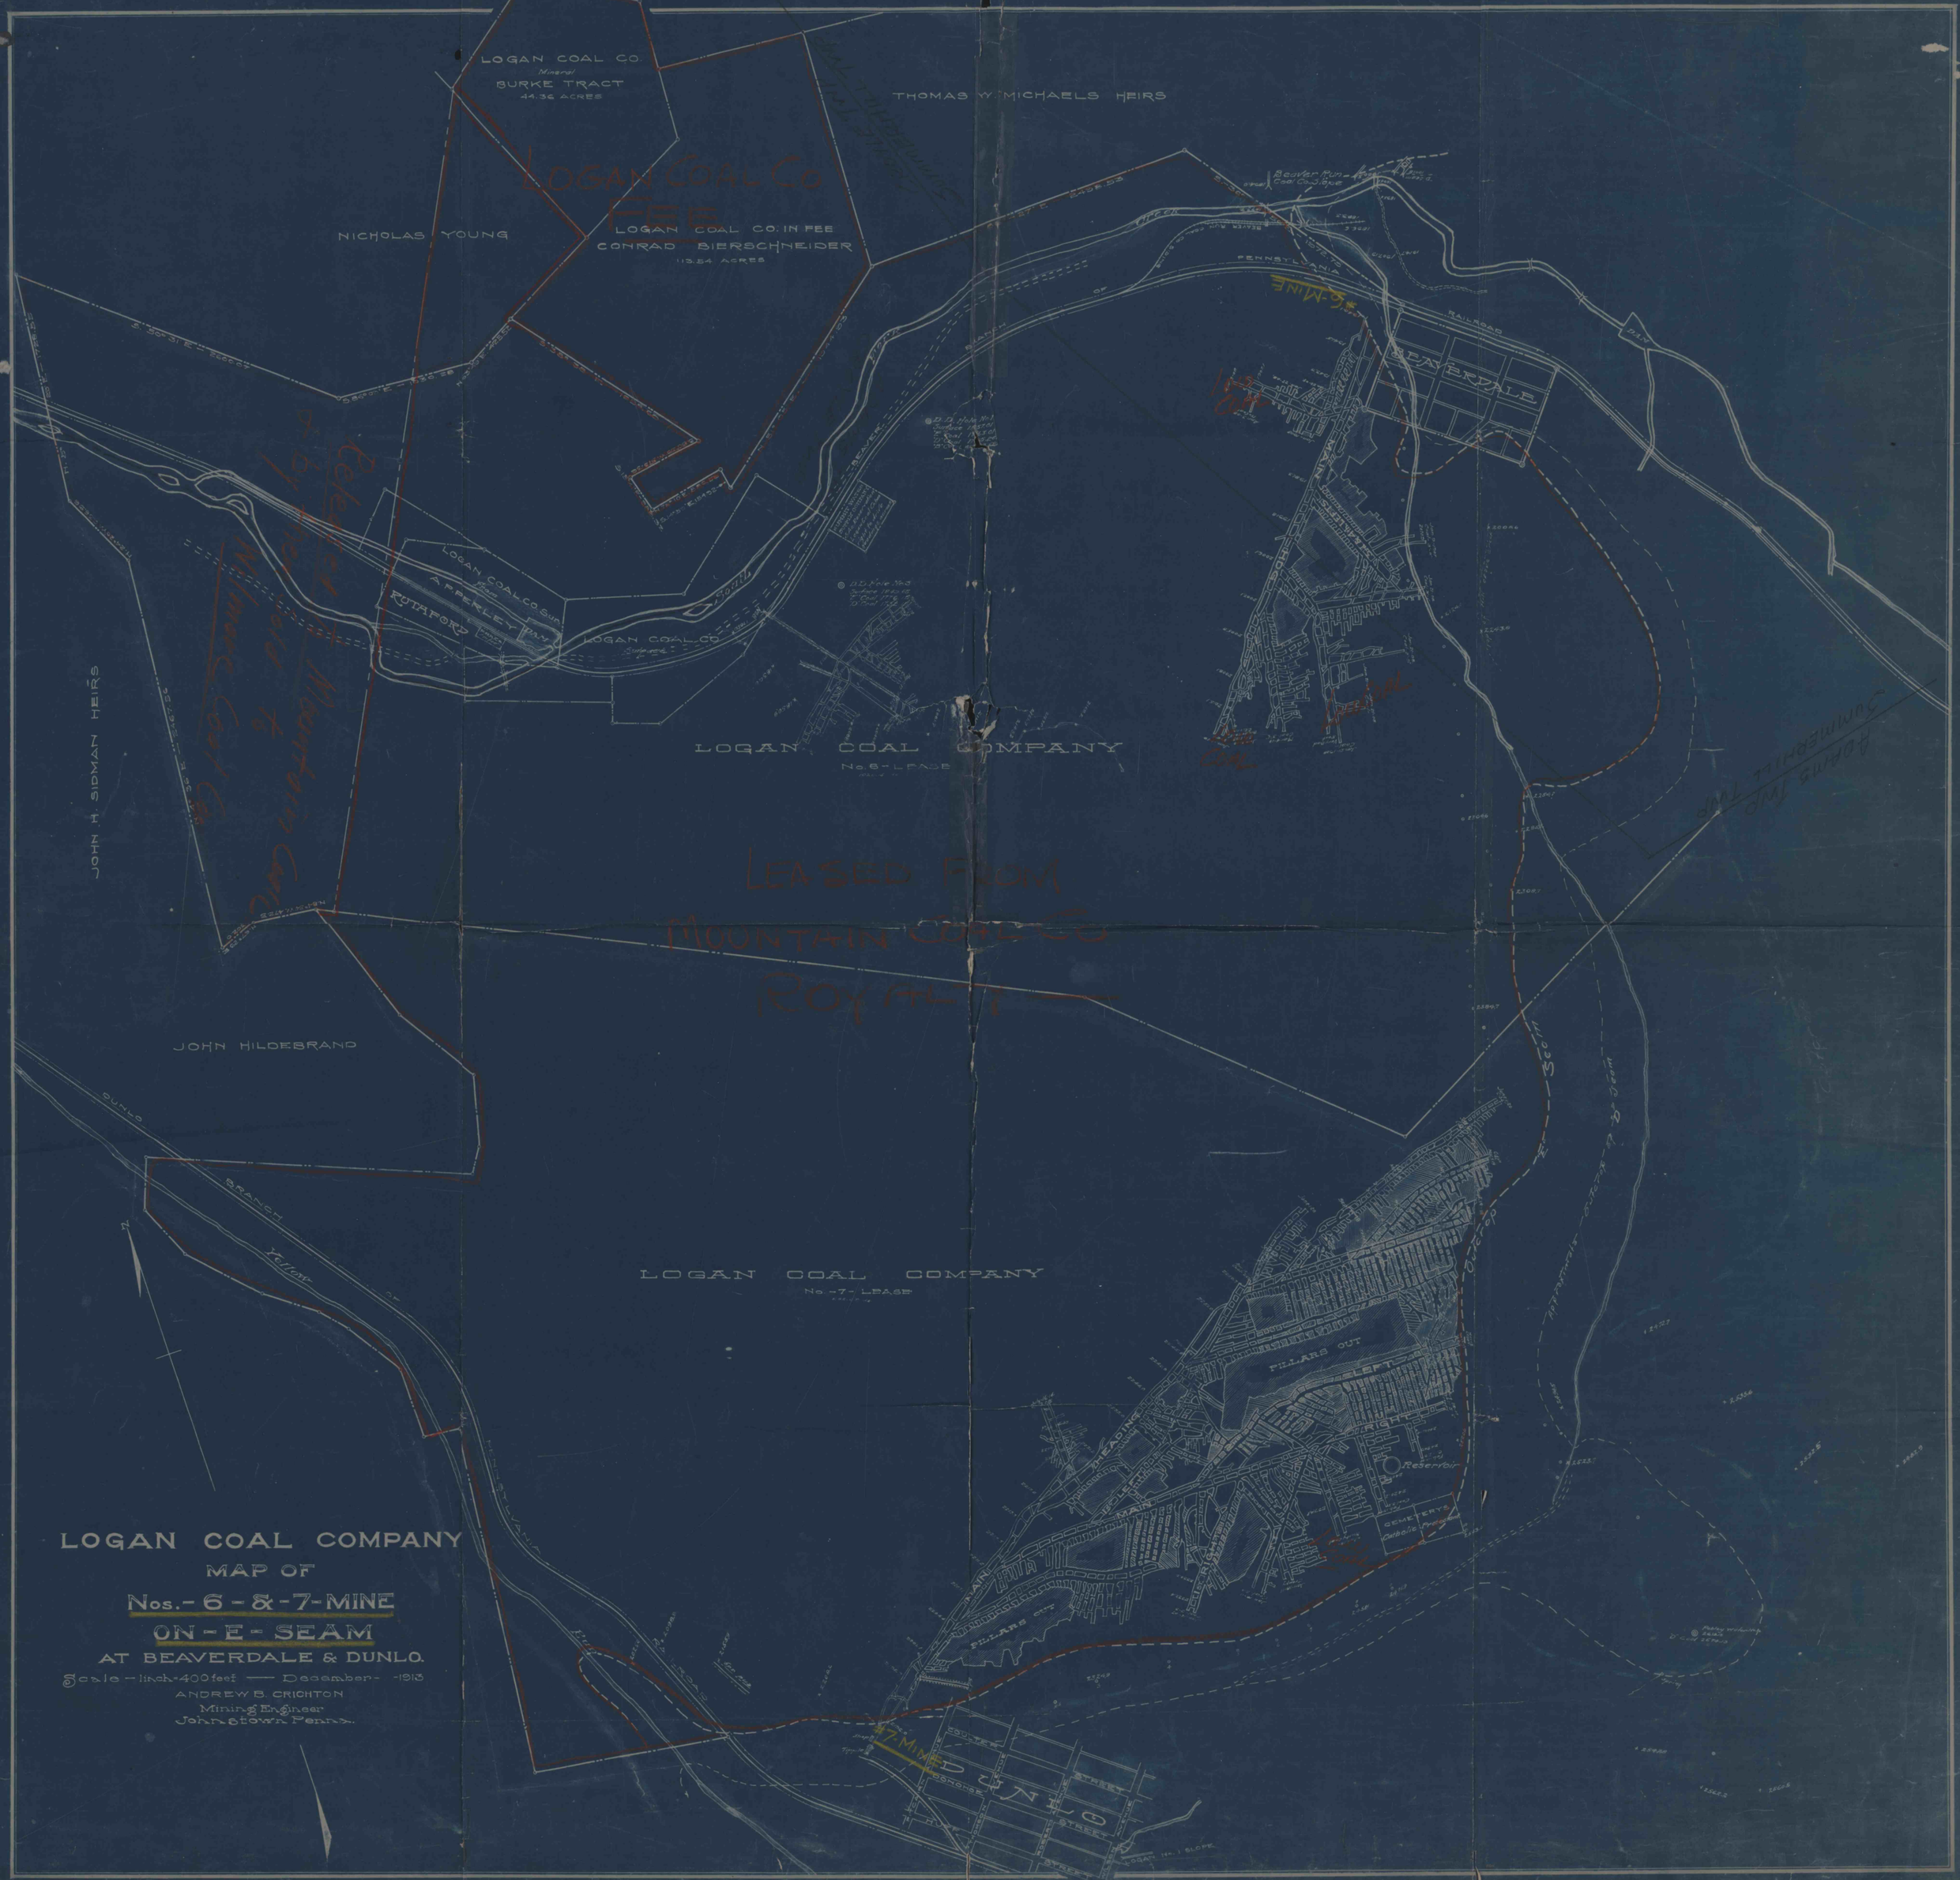
LOGAN COAL CO.
Mineral
BURKE TRACT
44.36 ACRES
THOMAS W. MICHAELS HEIRS
LOGAN COAL CO
FEE
NICHOLAS YOUNG
LOGAN COAL CO. IN FEE
CONRAD BIERSCHNEIDER
113.54 ACRES
PENNSYLVANIA
RAILROAD
BEAVERDALE
LOGAN COAL CO. Sur.
APPERLEY
RUTAFORD
LOGAN COAL CO.
LOGAN COAL COMPANY
No. 6 - LEASE
JOHN H. SIDMAN HEIRS
LEASED FROM
MOUNTAIN COAL CO
ROYALTY
JOHN HILDEBRAND
DUNLO
BRANCH
LOGAN COAL COMPANY
No. -7- LEASE
PILLARS OUT
Reservoir
CEMETERYS
DUNLO
LOGAN COAL COMPANY
MAP OF
Nos.- 6 - & - 7 - MINE
ON - E - SEAM
AT BEAVERDALE & DUNLO.
Scale - 1 inch = 400 feet —— December - 1913
ANDREW B. CRICHTON
Mining Engineer
Johnstown Penna.